


SACD PRODUCTS • NEW HOPE, MINNESOTA
REORDER BY PART NUMBER 8551

2504

SACD PRODUCTS • NEW HOPE, MINNESOTA
REORDER BY PART NUMBER 8551

SACD PRODUCTS • NEW HOPE, MINNESOTA
REORDER BY PART NUMBER 8551

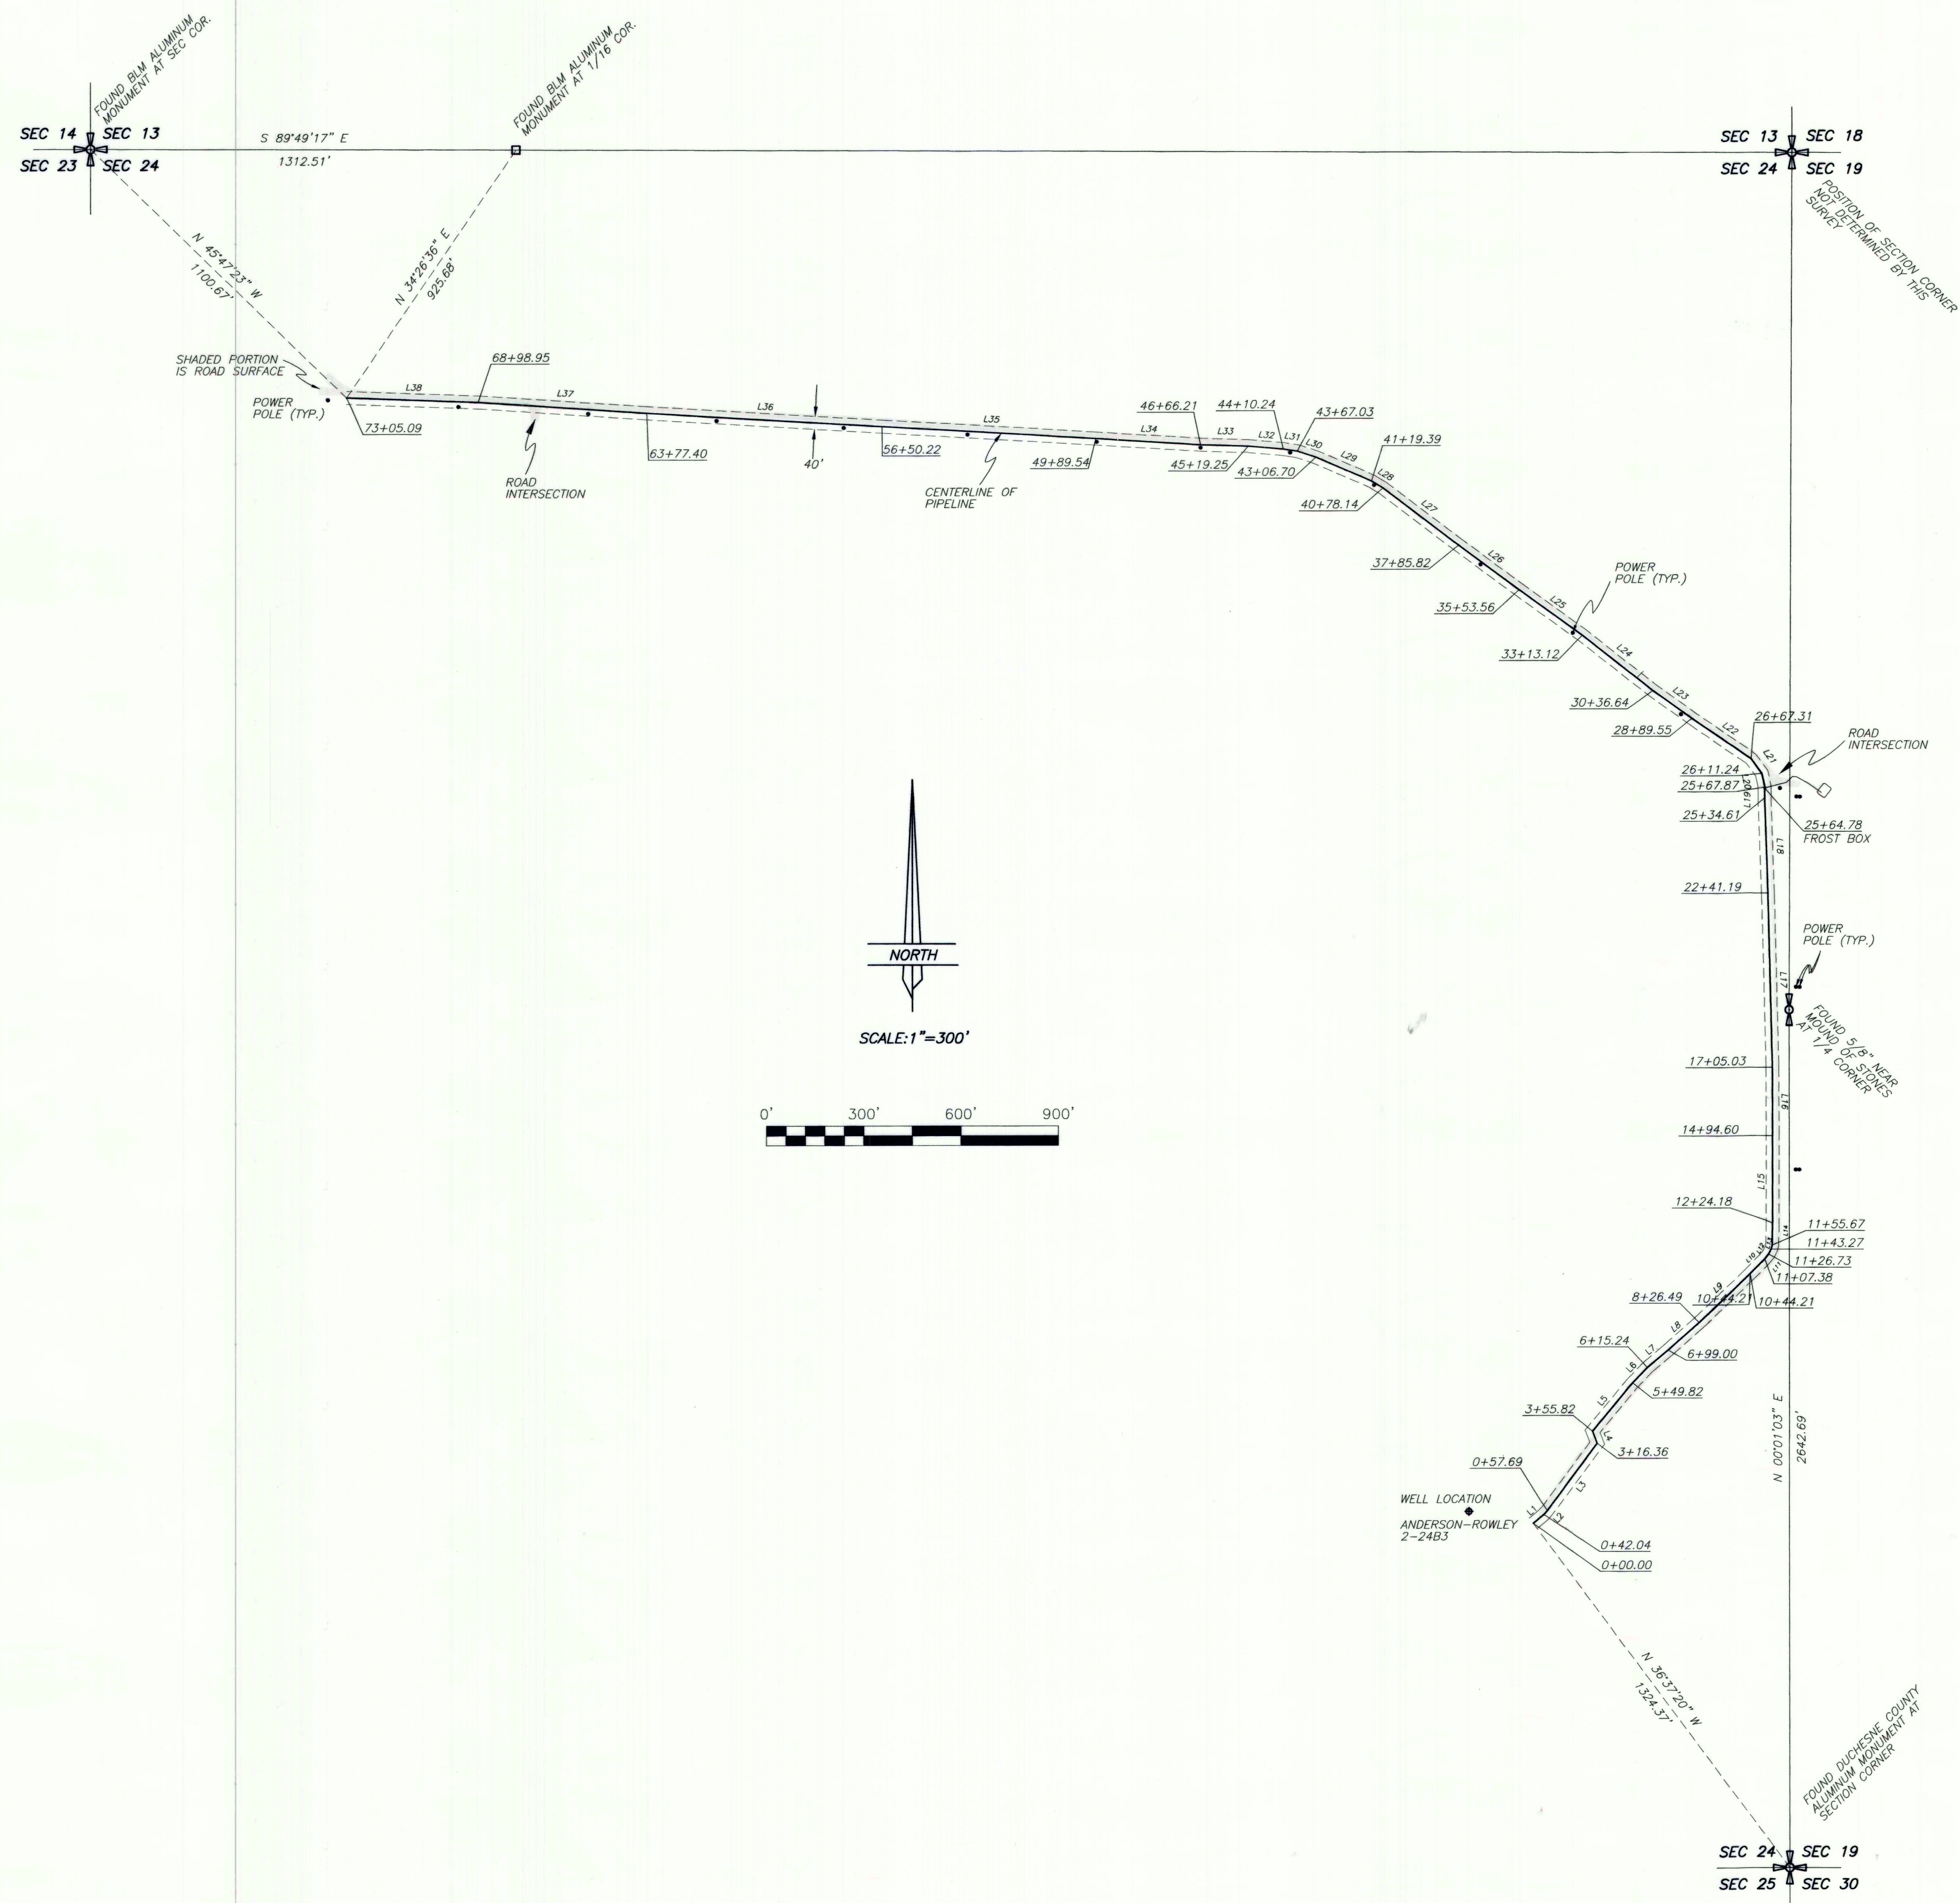

EL PASO E & P COMPANY, L.P.

PIPELINE AS-BUILT SURVEY
ANDERSON-ROWLEY 2-24B3


SECTION 24, TOWNSHIP 2 SOUTH, RANGE 3 WEST
UINTAH SPECIAL BASE AND MERIDIAN

LINE	BEARING	DISTANCE
L1	N 50°00'42" E	42.03'
L2	N 42°06'26" E	15.65'
L3	N 36°42'38" E	258.67'
L4	N 21°08'54" W	39.45'
L5	N 39°39'31" E	194.00'
L6	N 43°36'23" E	65.42'
L7	N 50°06'21" E	83.76'
L8	N 48°35'37" E	127.49'
L9	N 46°38'57" E	217.72'
L10	N 44°36'50" E	63.17'
L11	N 38°50'43" E	19.35'
L12	N 26°58'32" E	16.54'
L13	N 16°25'53" E	12.40'
L14	N 01°05'54" E	68.50'
L15	N 00°07'03" E	270.42'
L16	N 00°10'52" W	210.44'
L17	N 01°24'37" W	536.15'
L18	N 01°56'42" W	293.42'
L19	N 00°52'43" E	33.26'
L20	N 12°13'38" W	43.57'
L21	N 35°32'23" W	56.08'
L22	N 55°28'20" W	222.24'
L23	N 54°29'17" W	147.09'
L24	N 51°48'52" W	276.47'
L25	N 54°12'56" W	240.45'
L26	N 53°41'34" W	232.26'
L27	N 52°53'45" W	292.32'
L28	N 58°50'54" W	41.25'
L29	N 66°40'35" W	187.31'
L30	N 72°00'07" W	60.33'
L31	N 81°27'28" W	43.21'
L32	N 85°19'21" W	109.01'
L33	N 88°07'53" W	146.96'
L34	N 86°36'09" W	323.33'
L35	N 86°48'33" W	660.67'
L36	N 86°41'41" W	727.19'
L37	N 86°15'13" W	521.55'
L38	N 87°59'20" W	406.14'

THIS SURVEY WAS PERFORMED USING G.P.S. (GLOBAL POSITIONING SYSTEM) PROCEDURES AND EQUIPMENT.
THE BASIS OF BEARINGS IS BASED ON WGS-84 DATUM.

SURVEYOR'S CERTIFICATE

This is to certify that this plat was prepared from the field notes and electronic data collector files of an actual survey made by me, or under my personal supervision, of the parcel of land shown hereon, and that the monuments indicated were found or set during said survey, and that this plat accurately represents said survey to the best of my knowledge.

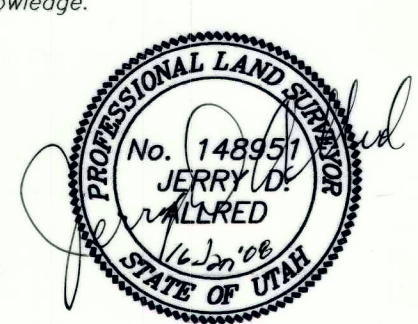

Jerry D. Allred, Professional Land Surveyor
Utah Certificate Number 148951

COUNTY RECORDER'S CERTIFICATE

STATE OF UTAH }
COUNTY OF DUCHESNE } SS
THIS IS TO CERTIFY THAT THIS PLAT WAS FILED FOR RECORD IN THE COUNTY RECORDER'S OFFICE ON THE
25 DAY OF JANUARY, 2007, AT 3:22 O'CLOCK P.M. AND IS DULY RECORDED.

FILE NO. 701995 PG 747-761
30.00

Charles R. Young
COUNTY RECORDER

COUNTY SURVEYOR'S FILE # 2504
JERRY D. ALLRED AND ASSOCIATES
SURVEYING CONSULTANTS
121 NORTH CENTER ST. - P.O. BOX 975
DUCHESTER, UTAH 84021
(435) 738-5352

13 DEC 2007 01-128-036