



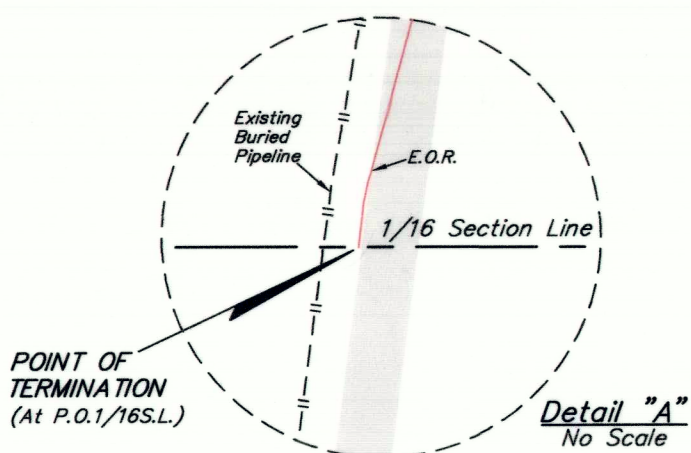

LENGTH TABLE

LOCATION	FEET	RODS
INSIDE 30' R-O-W	764.52	46.33
OUTSIDE 30' R-O-W	40.60	2.46
TOTAL	805.12	48.80

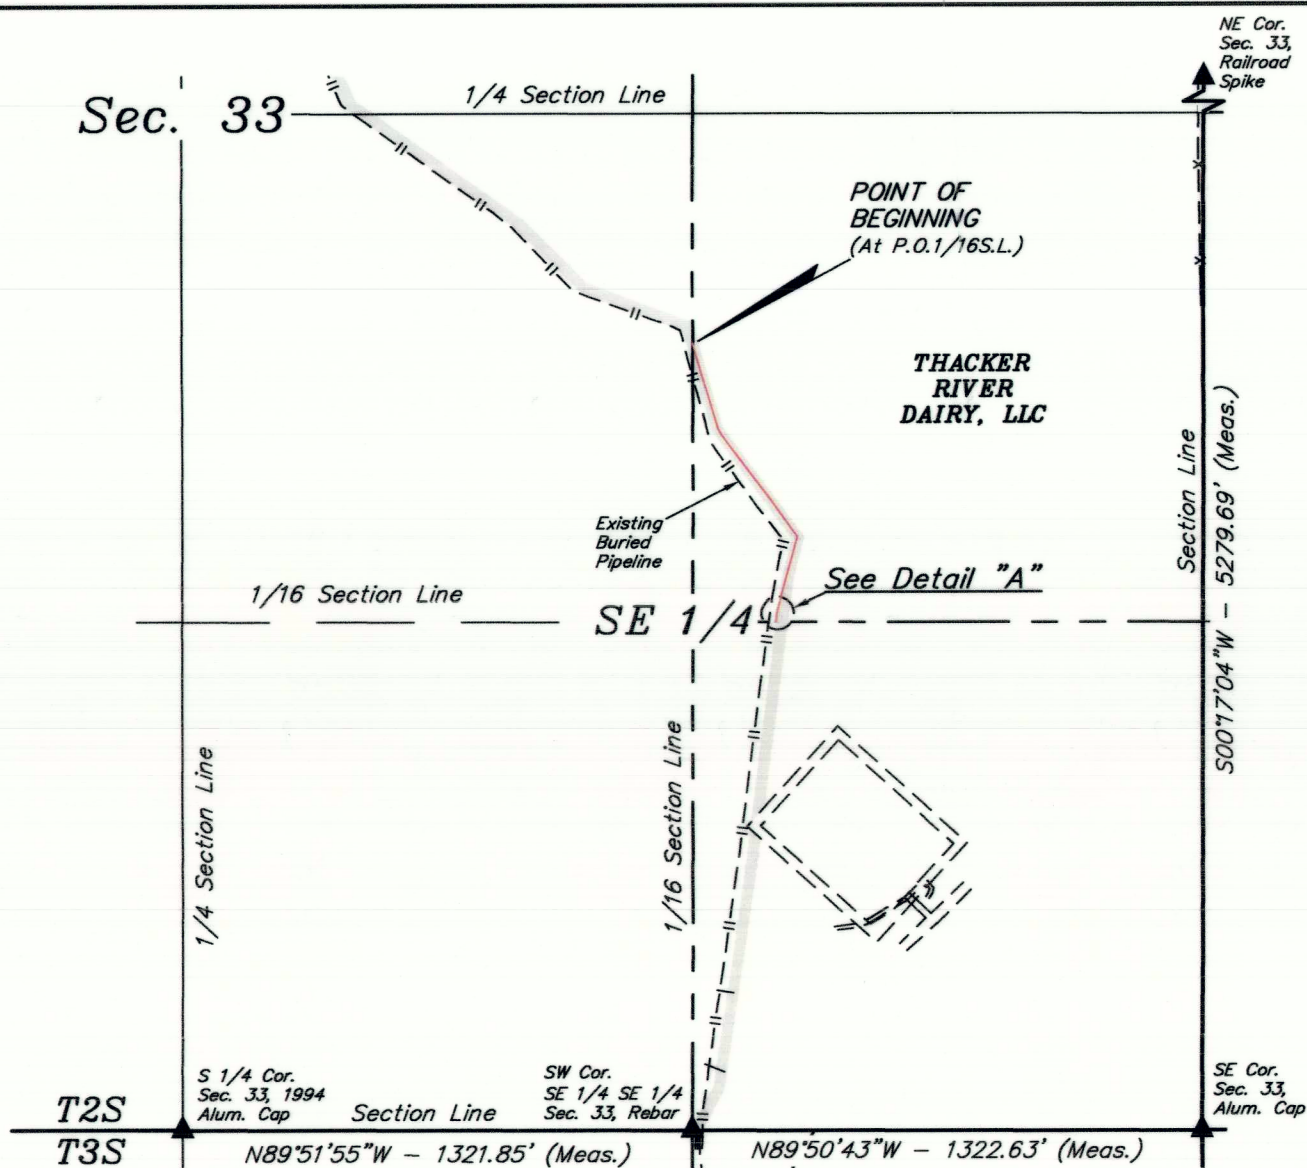

- ▲ = SECTION CORNERS LOCATED.
 ▲ = SECTION CORNERS RE-ESTABLISHED. (Not Set on Ground.)
 = EXISTING 30' WIDE RIGHT-OF-WAY.
 E.O.R. = EDGE OF RIGHT-OF-WAY

CERTIFICATE

THIS IS TO CERTIFY THAT THE ABOVE PLAT WAS PREPARED FROM FIELD NOTES OF ACTUAL SURVEYS MADE BY ME OR UNDER MY SUPERVISION AND THAT THE SAME ARE TRUE AND CORRECT TO THE BEST OF MY KNOWLEDGE AND BELIEF.



XCL RESOURCES

RAVOLA AS-BUILT PIPELINE ON
 THACKER RIVER DAIRY, LLC LANDS
 SECTION 33, T2S, R3W, U.S.B.&M.
 DUCHESNE COUNTY, UTAH

SURVEYED BY	C.R.	06-26-20	SCALE
DRAWN BY	S.O.	07-01-20	1" = 500'
FILE:	X-1396-N		

AS-BUILT PIPELINE



UELS, LLC
 Corporate Office * 85 South 200 East
 Vernal, UT 84078 * (435) 789-1017



County Surveyor's # 4594