


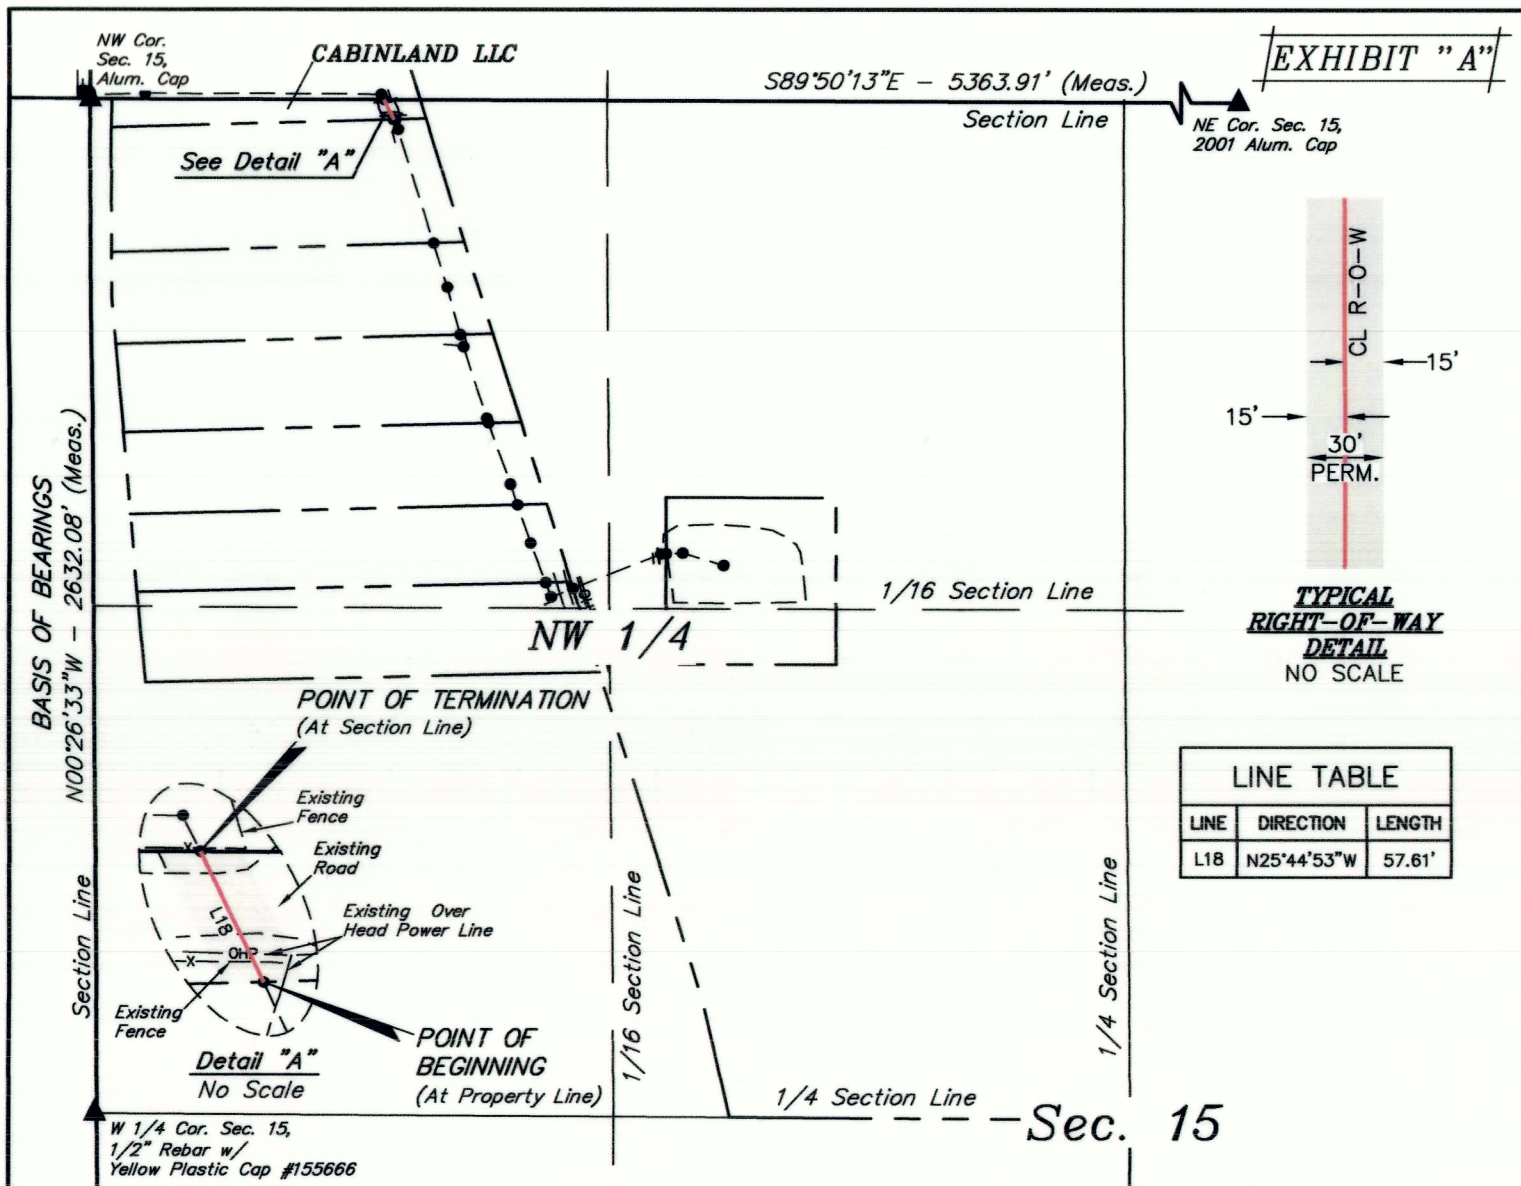

AS-BUILT PIPELINE RIGHT-OF-WAY DESCRIPTION

A 30' WIDE RIGHT-OF-WAY 15' ON EACH SIDE OF THE FOLLOWING DESCRIBED CENTERLINE.

COMMENCING AT THE WEST 1/4 CORNER OF SECTION 15, T2S, R3W, U.S.B.&M. THENCE N00°26'33"W 2632.08' ALONG THE WEST LINE OF THE NW 1/4 OF SAID SECTION 15 TO THE NORTHWEST CORNER OF SAID SECTION 15; THENCE S86°04'08"E 788.46' TO A POINT IN THE NW 1/4 NW 1/4 OF SAID SECTION 15 AND THE POINT OF BEGINNING; THENCE N25°44'53"W 57.61' TO A POINT ON THE NORTH LINE OF THE NW 1/4 NW 1/4 OF SAID SECTION 15 AND THE POINT OF TERMINATION, WHICH BEARS S89°50'13"E 761.59' FROM THE NORTHWEST CORNER OF SAID SECTION 15. THE SIDE LINES OF SAID DESCRIBED RIGHT-OF-WAY BEING SHORTENED OR ELONGATED TO MEET THE GRANTOR'S PROPERTY LINES. CONTAINS 0.040 ACRES MORE OR LESS.

POINT OF BEGINNING BEARS S86°04'08"E 788.46' FROM THE NORTHWEST CORNER OF SECTION 15, T2S, R3W, U.S.B.&M.

POINT OF TERMINATION BEARS S89°50'13"E 761.59' FROM THE NORTHWEST CORNER OF SECTION 15, T2S, R3W, U.S.B.&M.

500' 250' 0 500'

ACREAGE / LENGTH TABLE		
FEET	RODS	ACRES
57.61	3.49	0.040

▲ = SECTION CORNERS LOCATED.

CERTIFICATE

THIS IS TO CERTIFY THAT THE ABOVE PLAT WAS PREPARED FROM FIELD NOTES OF ACTUAL SURVEYS MADE BY ME OR UNDER MY SUPERVISION AND THAT THE SAME ARE TRUE AND CORRECT TO THE BEST OF MY KNOWLEDGE AND BELIEF.



XCL RESOURCES

**BODRERO NORTH PIPELINE
AS-BUILT PIPELINE RIGHT-OF-WAY ON
CABINLAND LLC LANDS
SECTION 15, T2S, R3W, U.S.B.&M.
DUCHESE COUNTY, UTAH**

SURVEYED BY	C.R.	06-24-20	SCALE
DRAWN BY	A.T.	06-29-20	1" = 500'
FILE:	X-1395-I		

AS-BUILT PIPELINE RIGHT-OF-WAY



UELS, LLC
Corporate Office * 85 South 200 East
Vernal, UT 84078 * (435) 789-1017

County Surveyor's File # 4609