


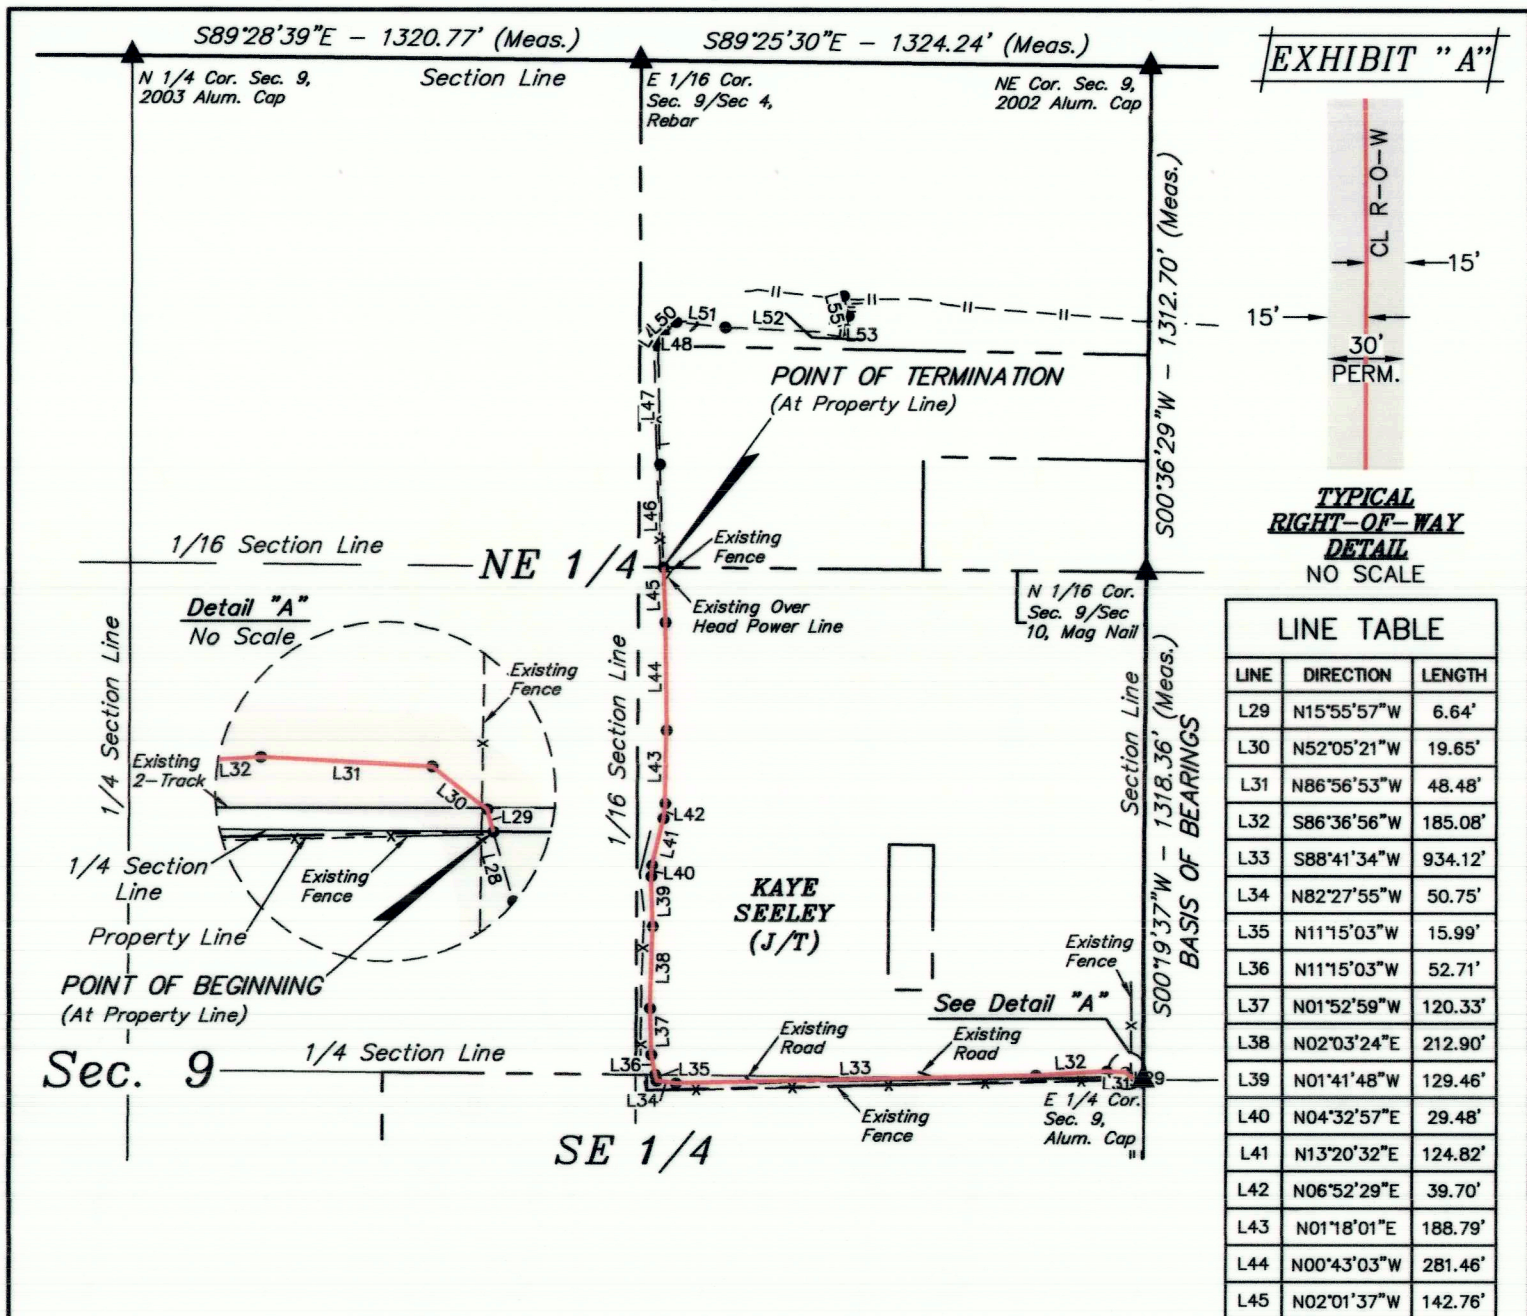

A 30' WIDE RIGHT-OF-WAY 15' ON EACH SIDE OF THE FOLLOWING DESCRIBED CENTERLINE.

COMMENCING AT THE NORTH 1/16 CORNER OF SECTION 9/SECTION 10, T2S, R3W, U.S.B.&M. THENCE S00°19'37"W 1318.36' ALONG THE EAST LINE OF THE SE 1/4 NE 1/4 OF SAID SECTION 9 TO THE EAST 1/4 CORNER OF SAID SECTION 9; THENCE N89°29'04"W 28.78' TO A POINT IN THE SE 1/4 NE 1/4 OF SAID SECTION 9 AND THE POINT OF BEGINNING; THENCE N15°55'57"W 6.64'; THENCE N52°05'21"W 19.65'; THENCE N86°56'53"W 48.48'; THENCE S86°36'56"W 185.08'; THENCE S88°41'34"W 934.12'; THENCE N82°27'55"W 50.75'; THENCE N11°15'03"W 15.99'; THENCE N11°15'03"W 52.71'; THENCE N01°52'59"W 120.33'; THENCE N02°03'24"E 212.90'; THENCE N01°41'48"W 129.46'; THENCE N04°32'57"E 29.48'; THENCE N13°20'32"E 124.82'; THENCE N06°52'29"E 39.70'; THENCE N01°18'01"E 188.79'; THENCE N00°43'03"W 281.46'; THENCE N02°01'37"W 142.76' TO A POINT ON THE NORTH LINE OF THE SE 1/4 SE 1/4 OF SAID SECTION 9 AND THE POINT OF TERMINATION, WHICH BEARS N89°31'45"W 1252.98' FROM THE NORTH 1/16 CORNER OF SAID SECTION 9/SECTION 10. THE SIDE LINES OF SAID DESCRIBED RIGHT-OF-WAY BEING SHORTENED OR ELONGATED TO MEET THE GRANTOR'S PROPERTY LINES. CONTAINS 1.779 ACRES MORE OR LESS.

POINT OF BEGINNING BEARS N89°29'04"W 28.78' FROM THE EAST 1/4 CORNER OF SECTION 9, T2S, R3W, U.S.B.&M.

POINT OF TERMINATION BEARS N89°31'45"W 1252.98' FROM THE NORTH 1/16 CORNER OF SECTION 9/SECTION 10, T2S, R3W, U.S.B.&M.

ACREAGE / LENGTH TABLE

FEET	RODS	ACRES
2583.12	156.55	1.779

▲ = SECTION CORNERS LOCATED.

CERTIFICATE

THIS IS TO CERTIFY THAT THE ABOVE PLAT WAS PREPARED FROM FIELD NOTES OF ACTUAL SURVEYS MADE BY ME OR UNDER MY SUPERVISION AND THAT THE SAME ARE TRUE AND CORRECT TO THE BEST OF MY KNOWLEDGE AND BELIEF.

REGISTERED LAND SURVEYOR
No. 6631032
BRANDON L. BODRERO
STATE OF UTAH
DATE OF PLAT 06-20

XCL RESOURCES

BODRERO NORTH PIPELINE
AS-BUILT PIPELINE RIGHT-OF-WAY ON
KAYE SEELEY (J/T) LANDS
SECTION 9, T2S, R3W, U.S.B.&M.
DUCHESENE COUNTY, UTAH

SURVEYED BY	C.R.	06-24-20	SCALE
DRAWN BY	A.T.	06-29-20	1" = 500'
FILE:	X-1395-L		

AS-BUILT PIPELINE RIGHT-OF-WAY



UELS, LLC
Corporate Office * 85 South 200 East
Vernal, UT 84078 * (435) 789-1017

County Surveyors File # 4612