


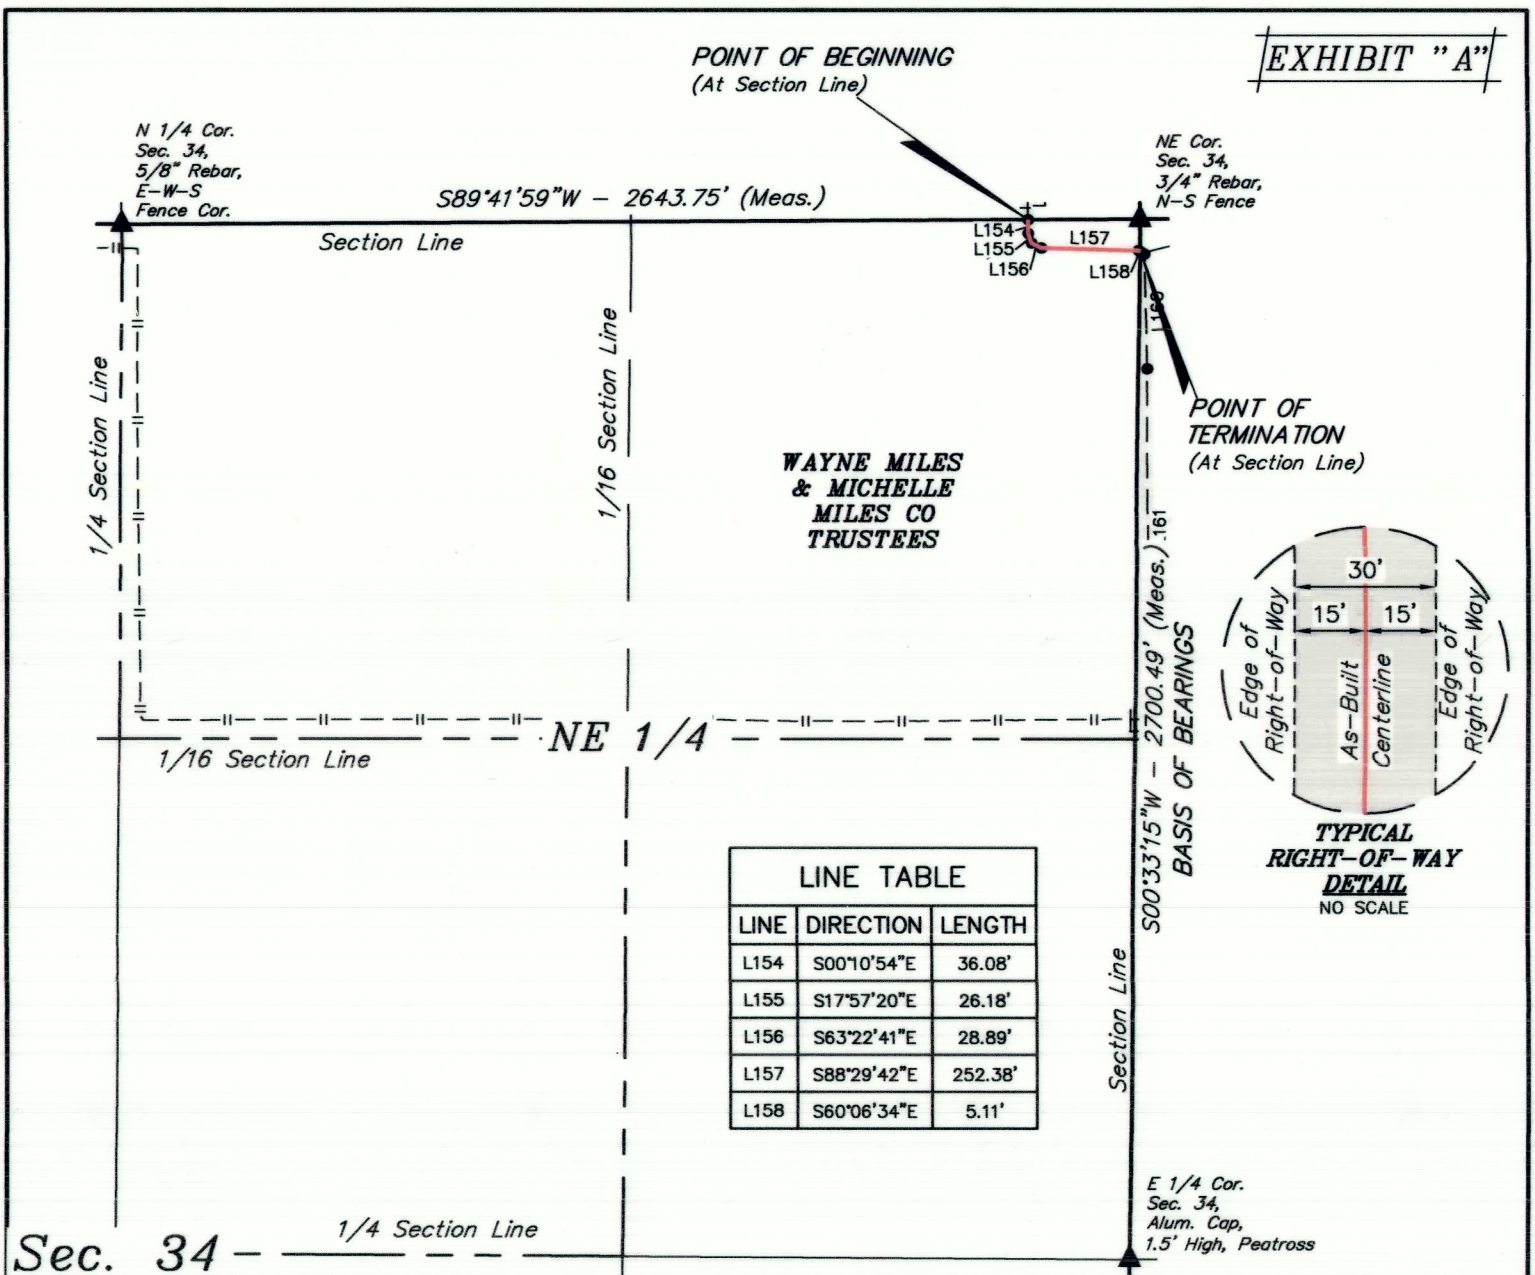

AS-BUILT PIPELINE RIGHT-OF-WAY DESCRIPTION

A 30' WIDE RIGHT-OF-WAY 15' ON EACH SIDE OF THE FOLLOWING DESCRIBED CENTERLINE.

COMMENCING AT THE EAST 1/4 CORNER OF SECTION 34, T2S, R3W, U.S.B.&M., THENCE N00°33'15"E 2700.49' ALONG THE EAST LINE OF THE NE 1/4 OF SAID SECTION 34 TO THE NORTHEAST CORNER OF SAID SECTION 34; THENCE S89°41'59"W 291.56' ALONG THE NORTH LINE OF THE NE 1/4 NE 1/4 OF SAID SECTION 34 TO THE POINT OF BEGINNING; THENCE S00°10'54"E 36.08'; THENCE S17°57'20"E 26.18'; THENCE S63°22'41"E 28.89'; THENCE S88°29'42"E 252.38'; THENCE S60°06'34"E 5.11' TO A POINT ON THE EAST LINE OF THE NE 1/4 NE 1/4 OF SAID SECTION 34 AND THE POINT OF TERMINATION, WHICH BEARS S00°33'15"W 84.64' FROM THE NORTHEAST CORNER OF SAID SECTION 34. THE SIDE LINES OF SAID DESCRIBED RIGHT-OF-WAY BEING SHORTENED OR ELONGATED TO MEET THE GRANTOR'S PROPERTY LINES. CONTAINS 0.240 ACRES MORE OR LESS.

POINT OF BEGINNING BEARS
S89°41'59"W 291.56' FROM THE
NORTHEAST CORNER OF SECTION 34,
T2S, R3W, U.S.B.&M.

POINT OF TERMINATION BEARS
S00°33'15"W 84.64' FROM THE
NORTHEAST CORNER OF SECTION 34,
T2S, R3W, U.S.B.&M.

CERTIFICATE

THIS IS TO CERTIFY THAT THE ABOVE PLAT WAS PREPARED FROM FIELD NOTES OF ACTUAL SURVEYS MADE BY ME OR UNDER MY SUPERVISION AND THAT THE SAME ARE TRUE AND CORRECT TO THE BEST OF MY KNOWLEDGE AND BELIEF.



XCL ASSETCO., LLC

MAIN TRUNK LINE

AS-BUILT PIPELINE RIGHT-OF-WAY ON WAYNE MILES & MICHELLE MILES CO TRUSTEE LANDS

SECTION 34, T2S, R3W, U.S.B.&M.

DUCHESE COUNTY, UTAH

SURVEYED BY	C.R.	11-05-20	SCALE
DRAWN BY	S.O.	11-12-20	1" = 500'
FILE:	X-1392-U		

AS-BUILT PIPELINE RIGHT-OF-WAY



UCLS, LLC
Corporate Office * 85 South 200 East
Vernal, UT 84078 * (435) 789-1017