


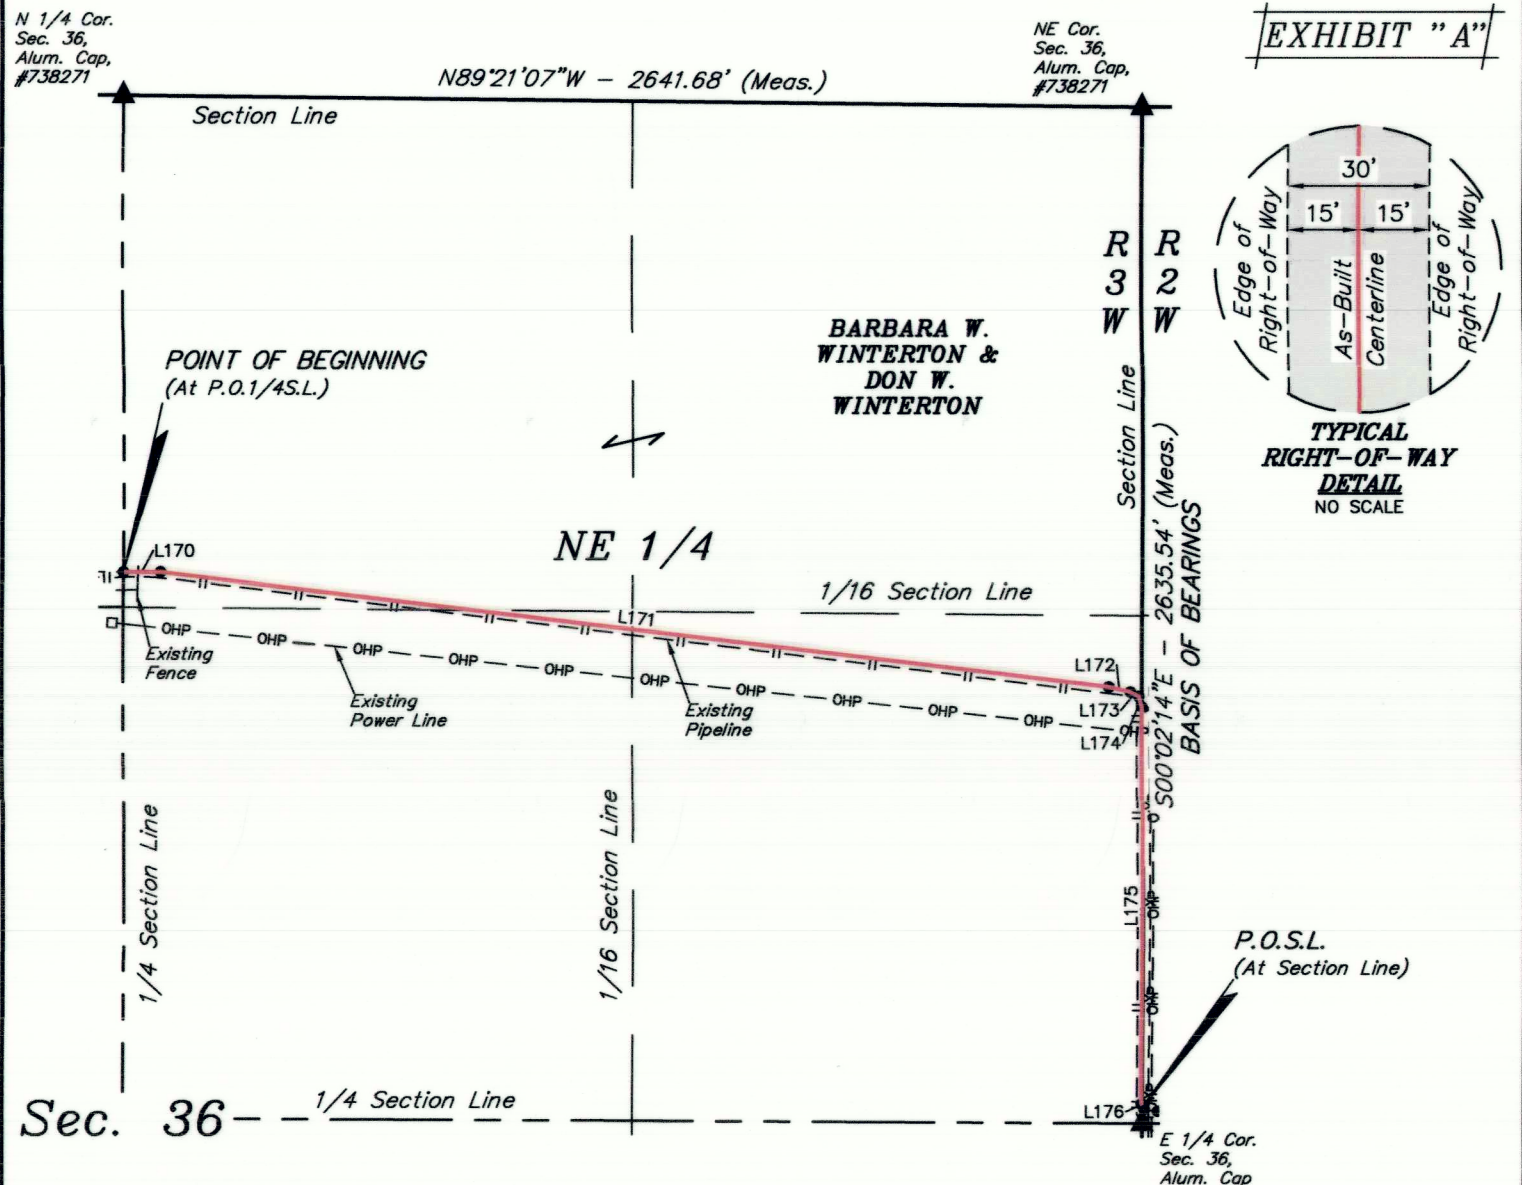

LINE TABLE		
LINE	DIRECTION	LENGTH
L170	N89°47'30"E	96.03'
L171	S83°05'46"E	2479.02'
L172	S76°57'16"E	57.08'
L173	S61°31'15"E	25.18'
L174	S16°09'13"E	28.39'
L175	S00°02'03"W	1028.46'
L176	S26°57'43"E	4.39'
L177	S26°57'43"E	11.23'
L178	S81°06'48"E	35.08'
L179	S89°50'27"E	5067.43'
L180	N47°30'27"E	23.38'
L181	N11°00'54"E	28.30'
L182	N00°00'48"E	482.37'
L183	N31°35'23"E	17.41'
L184	N75°11'53"E	20.84'
L185	S88°30'53"E	35.77'

POINT OF BEGINNING BEARS
S00°02'29"W 1235.57' FROM THE
NORTH 1/4 CORNER OF SECTION 36,
T2S, R3W, U.S.B.&M.

P.O.S.L. BEARS N00°02'14"W 47.68'
FROM THE EAST 1/4 CORNER OF
SECTION 36, T2S, R3W, U.S.B.&M.

POINT OF TERMINATION BEARS
N00°01'47"W 576.24' FROM THE
EAST 1/4 CORNER OF SECTION 31,
T2S, R2W, U.S.B.&M.

ACREAGE / LENGTH TABLE		
CENT. LINE FEET	CENT. LINE RODS	ACRES
3718.55	225.37	2.235



▲ = SECTION CORNERS LOCATED.

CERTIFICATE
THIS IS TO CERTIFY THAT THE ABOVE PLAT WAS PREPARED FROM FIELD
NOTES OF ACTUAL SURVEYS MADE BY ME OR UNDER MY SUPERVISION
AND THAT THE SAME ARE TRUE AND CORRECT TO THE BEST OF MY
KNOWLEDGE AND BELIEF.

REGISTERED LAND SURVEYOR
REGISTRATION NO. 6631032
STATE OF UTAH

SHEET 1 OF 2

XCL ASSETCO., LLC

MAIN TRUNK LINE
AS-BUILT PIPELINE RIGHT-OF-WAY ON BARBARA
W. WINTERTON & DON W. WINTERTON LANDS
SECTION 36, T2S, R3W, U.S.B.&M.
DUCESNE COUNTY, UTAH

SURVEYED BY	C.R.	11-05-20	SCALE
DRAWN BY	S.O.	11-12-20	1" = 500'
FILE:	X-1392-X1		

AS-BUILT PIPELINE RIGHT-OF-WAY



UELS, LLC
Corporate Office * 85 South 200 East
Vernal, UT 84078 * (435) 789-1017

EXHIBIT "A"

AS-BUILT PIPELINE RIGHT-OF-WAY DESCRIPTION

THAT PORTION OF THE FOLLOWING DESCRIBED RIGHT-OF-WAY THAT LIES IN SECTION 36, T2S, R3W, U.S.B.&M., BEING A 30' WIDE PERMANENT RIGHT-OF-WAY 15' ON EACH SIDE OF THE FOLLOWING DESCRIBED CENTERLINE. CONTAINS 2.235 ACRES MORE OR LESS.

COMMENCING AT THE EAST 1/4 CORNER OF SECTION 36, T2S, R3W, U.S.B.&M., THENCE N00°02'14"W 2635.54' ALONG THE EAST LINE OF THE NE 1/4 OF SAID SECTION 36 TO THE NORTHEAST CORNER OF SAID SECTION 36; THENCE N89°21'07"W 2641.68' ALONG THE NORTH LINE OF THE NE 1/4 OF SAID SECTION 36 TO THE NORTH 1/4 CORNER OF SAID SECTION 36, THENCE S00°02'29"W 1235.57' TO A POINT ON THE WEST LINE OF THE NW 1/4 NE 1/4 OF SAID SECTION 36 AND THE POINT OF BEGINNING; THENCE N89°47'30"E 96.03'; THENCE S83°05'46"E 2479.02'; THENCE S76°57'16"E 57.08'; THENCE S61°31'15"E 25.18'; THENCE S16°09'13"E 28.39'; THENCE S00°02'03"W 1028.46'; THENCE S26°57'43"E 4.39' TO A POINT ON THE EAST LINE OF THE SE 1/4 NE 1/4 OF SAID SECTION 36, WHICH BEARS N00°02'14"W 47.68' FROM THE EAST 1/4 CORNER OF SAID SECTION 36, THENCE S26°57'43"E 11.23'; THENCE S81°06'48"E 35.08'; THENCE S89°50'27"E 5067.43'; THENCE N47°30'27"E 23.38'; THENCE N11°00'54"E 28.30'; THENCE N00°00'48"E 482.37'; THENCE N31°35'23"E 17.41'; THENCE N75°11'53"E 20.84'; THENCE S88°30'53"E 35.77' TO A POINT ON THE EAST LINE OF THE SE 1/4 NE 1/4 OF SECTION 31, T2S, R2W, U.S.B.&M. AND THE POINT OF TERMINATION, WHICH BEARS N00°01'47"W 576.24' FROM THE EAST 1/4 CORNER OF SAID SECTION 31. THE SIDE LINES OF SAID DESCRIBED RIGHT-OF-WAY BEING SHORTENED OR ELONGATED TO MEET THE GRANTOR'S PROPERTY LINES.

CERTIFICATE
THIS IS TO CERTIFY THAT THE ABOVE PLAT WAS PREPARED FROM FIELD
NOTES OF ACTUAL SURVEYS MADE BY ME OR UNDER MY SUPERVISION
AND THAT THE SAME ARE TRUE AND CORRECT TO THE BEST OF MY
KNOWLEDGE AND BELIEF.

REGISTERED LAND SURVEYOR
REGISTRATION NO. 6631032
STATE OF UTAH

SHEET 2 OF 2

XCL ASSETCO., LLC

MAIN TRUNK LINE
AS-BUILT PIPELINE RIGHT-OF-WAY ON BARBARA
W. WINTERTON & DON W. WINTERTON LANDS
SECTION 36, T2S, R3W, U.S.B.&M.
DUCESNE COUNTY, UTAH

SURVEYED BY	C.R.	11-05-20	SCALE
DRAWN BY	S.O.	11-12-20	N/A
FILE:	X-1392-X2		

AS-BUILT PIPELINE RIGHT-OF-WAY



UELS, LLC
Corporate Office * 85 South 200 East
Vernal, UT 84078 * (435) 789-1017

County Surveyors File # 4747