



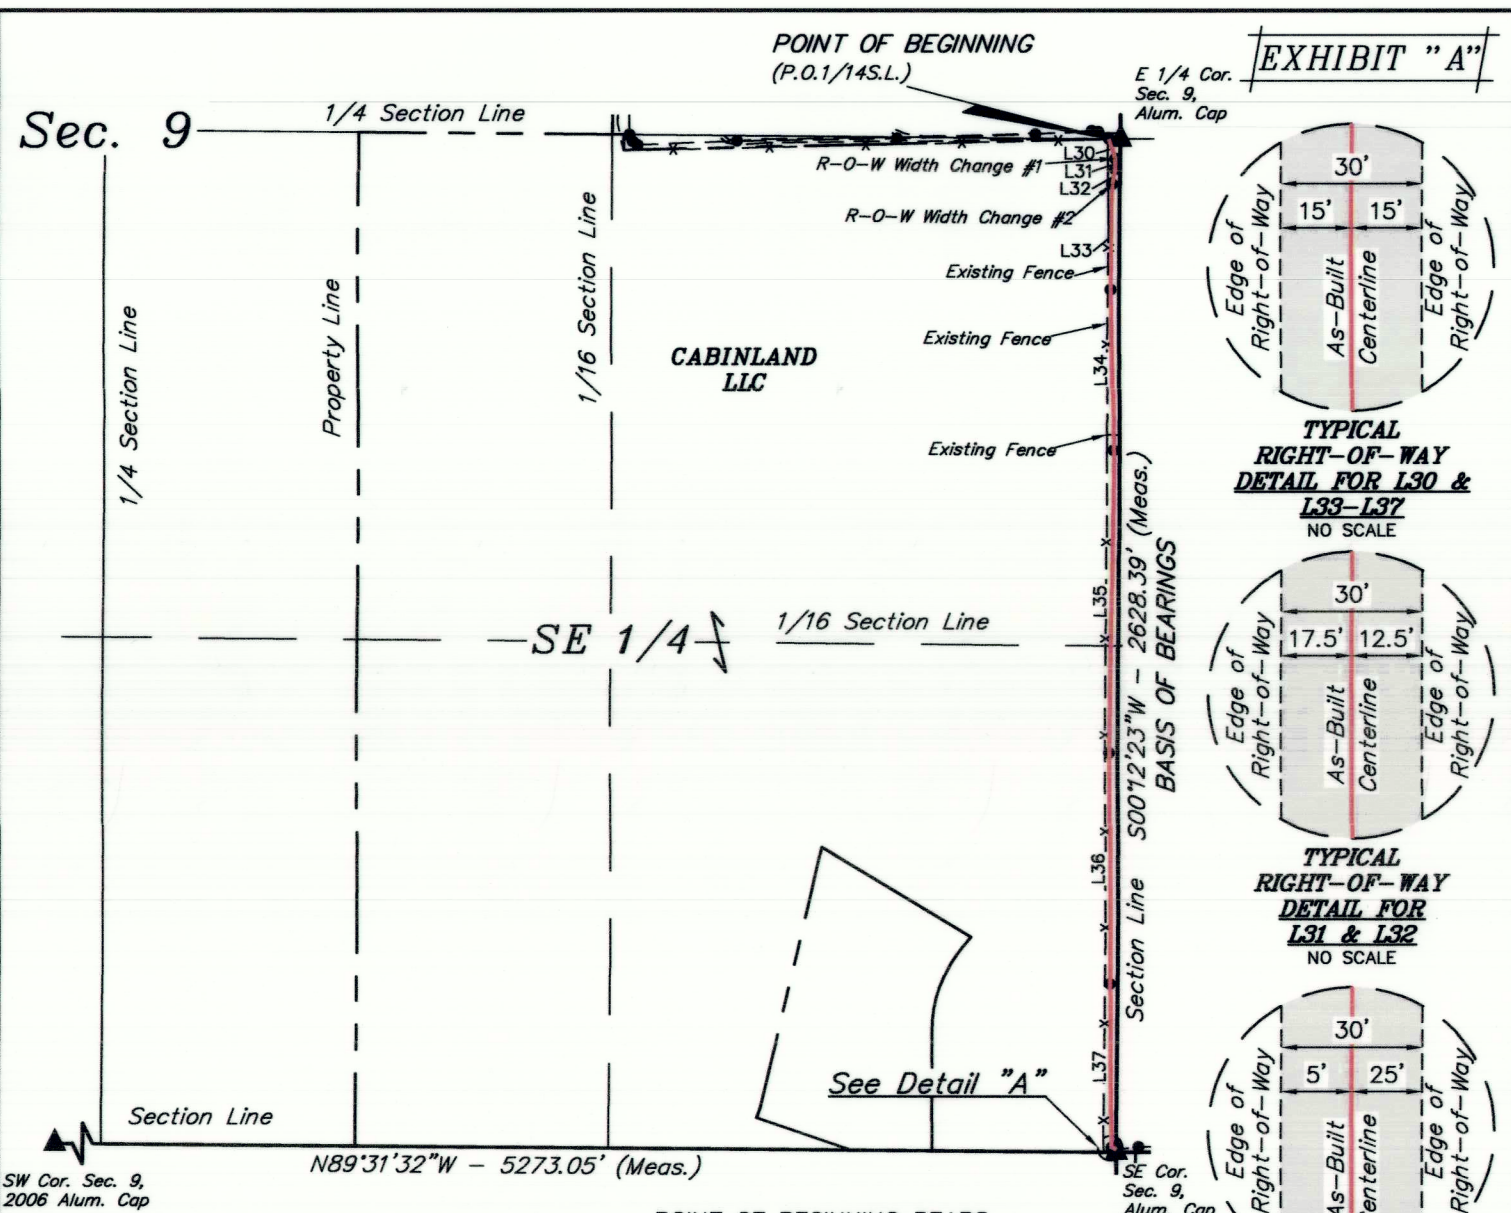



EXHIBIT "A"

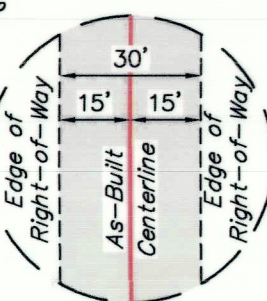

TYPICAL
RIGHT-OF-WAY
DETAIL FOR
L30 & L37
NO SCALE

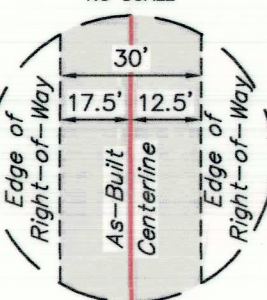

TYPICAL
RIGHT-OF-WAY
DETAIL FOR
L31 & L32
NO SCALE

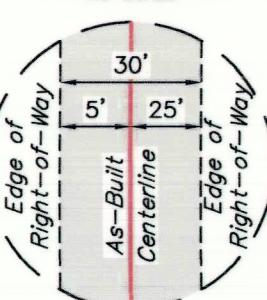

TYPICAL
RIGHT-OF-WAY
DETAIL FOR
L38 & L39
NO SCALE

POINT OF BEGINNING BEARS
N89°29'03"W 30.17' FROM THE
EAST 1/4 CORNER OF SECTION 9,
T2S, R3W, U.S.B.&M.

R-O-W WIDTH CHANGE #1 BEARS
S15°16'03"W 52.61' FROM THE
EAST 1/4 CORNER OF SECTION 9,
T2S, R3W, U.S.B.&M.


R-O-W WIDTH CHANGE #2 BEARS
S10°23'39"W 117.71' FROM THE
EAST 1/4 CORNER OF SECTION 9,
T2S, R3W, U.S.B.&M.

R-O-W WIDTH CHANGE #3 BEARS
N44°49'19"W 18.09' FROM THE
SOUTHEAST CORNER OF SECTION
9, T2S, R3W, U.S.B.&M.

POINT OF TERMINATION BEARS
N00°12'23"E 7.59' FROM THE
SOUTHEAST CORNER OF SECTION
9, T2S, R3W, U.S.B.&M.

LINE TABLE

LINE	DIRECTION	LENGTH
L30	S17°43'58"E	53.57'
L31	S00°23'05"W	27.16'
L32	S10°46'04"W	38.54'
L33	S00°40'15"W	274.03'
L34	S00°47'39"E	416.03'
L35	S00°42'44"W	786.32'
L36	S00°01'02"E	600.07'
L37	S00°49'05"E	423.47'
L38	S50°19'18"E	9.21'
L39	N83°41'01"E	5.73'

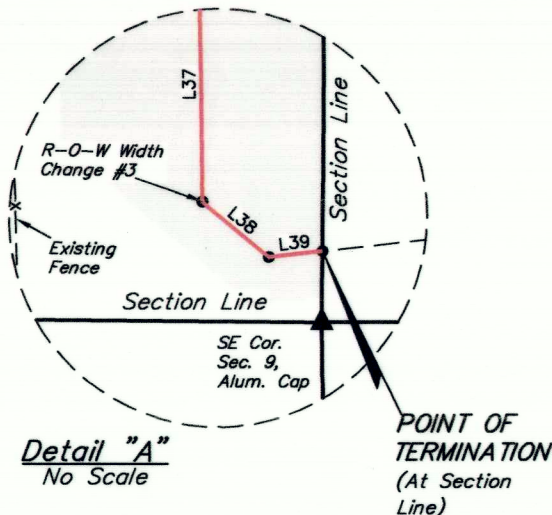

Detail "A"
No Scale

ACREAGE / LENGTH TABLE

FEET	RODS	ACRES
2634.13	159.64	1.814



▲ = SECTION CORNERS LOCATED.

CERTIFICATE
THIS IS TO CERTIFY THAT THE ABOVE PLAT WAS PREPARED FROM FIELD
NOTES OF ACTUAL SURVEYS MADE BY ME OR UNDER MY SUPERVISION
AND THAT THE SAME ARE TRUE AND CORRECT TO THE BEST OF MY
KNOWLEDGE AND BELIEF.

REGISTERED LAND SURVEYOR
REGISTRATION NO. 6631032
STATE OF UTAH

SHEET 1 OF 2

XCL ASSETCO., LLC

MAIN TRUNK LINE
AS-BUILT PIPELINE RIGHT-OF-WAY ON
CABINLAND LLC LANDS IN
SECTION 9, T2S, R3W, U.S.B.&M.
DUCESNE COUNTY, UTAH

SURVEYED BY	C.R.	11-05-20	SCALE
DRAWN BY	S.O.	11-12-20	1" = 500'
FILE:	X-1392-D1		

AS-BUILT PIPELINE RIGHT-OF-WAY



UELS, LLC
Corporate Office * 85 South 200 East
Vernal, UT 84078 * (435) 789-1017

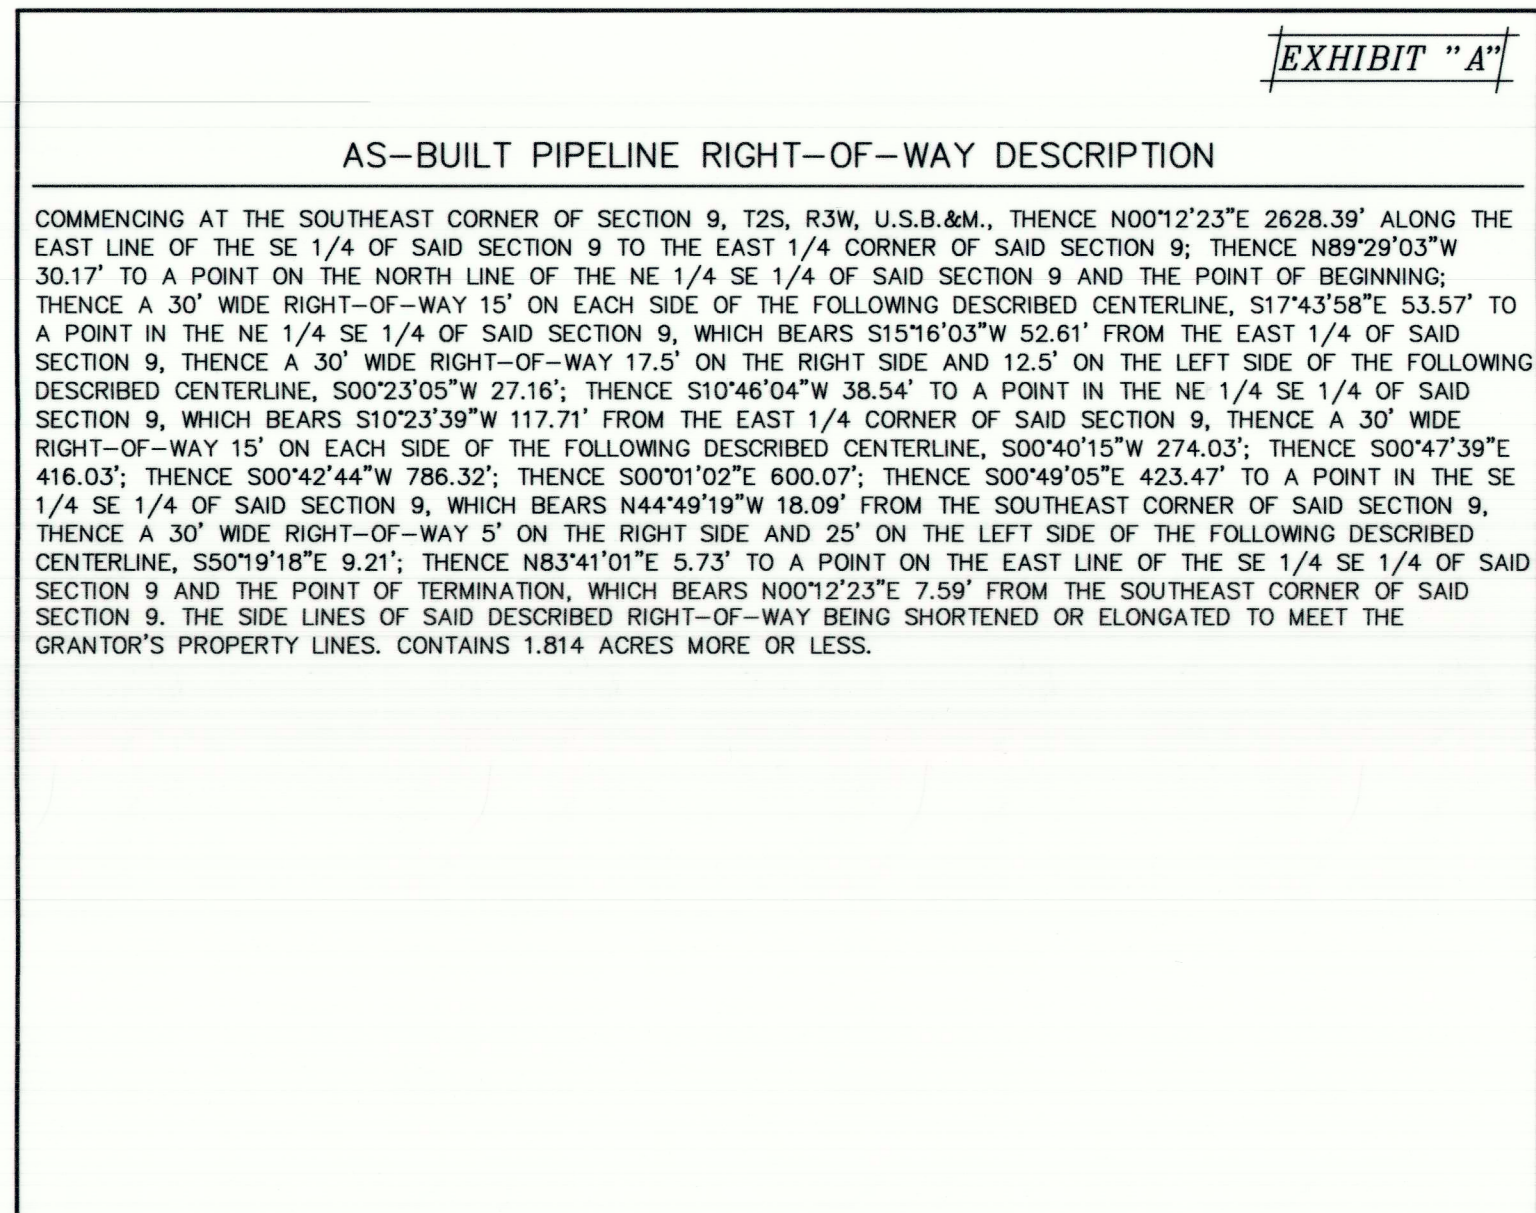


EXHIBIT "A"

AS-BUILT PIPELINE RIGHT-OF-WAY DESCRIPTION

COMMENCING AT THE SOUTHEAST CORNER OF SECTION 9, T2S, R3W, U.S.B.&M., THENCE N00°12'23"E 2628.39' ALONG THE EAST LINE OF THE SE 1/4 OF SAID SECTION 9 TO THE EAST 1/4 CORNER OF SAID SECTION 9; THENCE N89°29'03"W 30.17' TO A POINT ON THE NORTH LINE OF THE NE 1/4 SE 1/4 OF SAID SECTION 9 AND THE POINT OF BEGINNING; THENCE A 30' WIDE RIGHT-OF-WAY 15' ON EACH SIDE OF THE FOLLOWING DESCRIBED CENTERLINE, S17°43'58"E 53.57' TO A POINT IN THE NE 1/4 SE 1/4 OF SAID SECTION 9, WHICH BEARS S15°16'03"W 52.61' FROM THE EAST 1/4 CORNER OF SAID SECTION 9, THENCE A 30' WIDE RIGHT-OF-WAY 17.5' ON THE RIGHT SIDE AND 12.5' ON THE LEFT SIDE OF THE FOLLOWING DESCRIBED CENTERLINE, S00°23'05"W 27.16'; THENCE S10°46'04"W 38.54' TO A POINT IN THE NE 1/4 SE 1/4 OF SAID SECTION 9, WHICH BEARS S10°23'39"W 117.71' FROM THE EAST 1/4 CORNER OF SAID SECTION 9, THENCE A 30' WIDE RIGHT-OF-WAY 15' ON EACH SIDE OF THE FOLLOWING DESCRIBED CENTERLINE, S00°40'15"W 274.03'; THENCE S00°47'39"E 416.03'; THENCE S00°42'44"W 786.32'; THENCE S00°01'02"E 600.07'; THENCE S00°49'05"E 423.47' TO A POINT IN THE SE 1/4 SE 1/4 OF SAID SECTION 9, WHICH BEARS N44°49'19"W 18.09' FROM THE SOUTHEAST CORNER OF SAID SECTION 9, THENCE A 30' WIDE RIGHT-OF-WAY 5' ON THE RIGHT SIDE AND 25' ON THE LEFT SIDE OF THE FOLLOWING DESCRIBED CENTERLINE, S50°19'18"E 9.21'; THENCE N83°41'01"E 5.73' TO A POINT ON THE EAST LINE OF THE SE 1/4 SE 1/4 OF SAID SECTION 9 AND THE POINT OF TERMINATION, WHICH BEARS N00°12'23"E 7.59' FROM THE SOUTHEAST CORNER OF SAID SECTION 9. THE SIDE LINES OF SAID DESCRIBED RIGHT-OF-WAY BEING SHORTENED OR ELONGATED TO MEET THE GRANTOR'S PROPERTY LINES. CONTAINS 1.814 ACRES MORE OR LESS.

CERTIFICATE
THIS IS TO CERTIFY THAT THE ABOVE PLAT WAS PREPARED FROM FIELD
NOTES OF ACTUAL SURVEYS MADE BY ME OR UNDER MY SUPERVISION
AND THAT THE SAME ARE TRUE AND CORRECT TO THE BEST OF MY
KNOWLEDGE AND BELIEF.

REGISTERED LAND SURVEYOR
REGISTRATION NO. 6631032
STATE OF UTAH

SHEET 2 OF 2

XCL ASSETCO., LLC

MAIN TRUNK LINE
AS-BUILT PIPELINE RIGHT-OF-WAY ON
CABINLAND LLC LANDS IN
SECTION 9, T2S, R3W, U.S.B.&M.
DUCESNE COUNTY, UTAH

SURVEYED BY	C.R.	11-05-20	SCALE
DRAWN BY	S.O.	11-12-20	N/A
FILE:	X-1392-D2		

AS-BUILT PIPELINE RIGHT-OF-WAY



UELS, LLC
Corporate Office * 85 South 200 East
Vernal, UT 84078 * (435) 789-1017

County Surveyor's File # 4761