
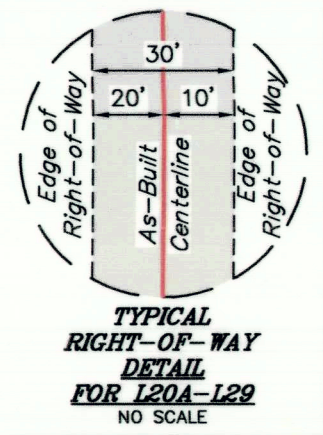


EXHIBIT "A"

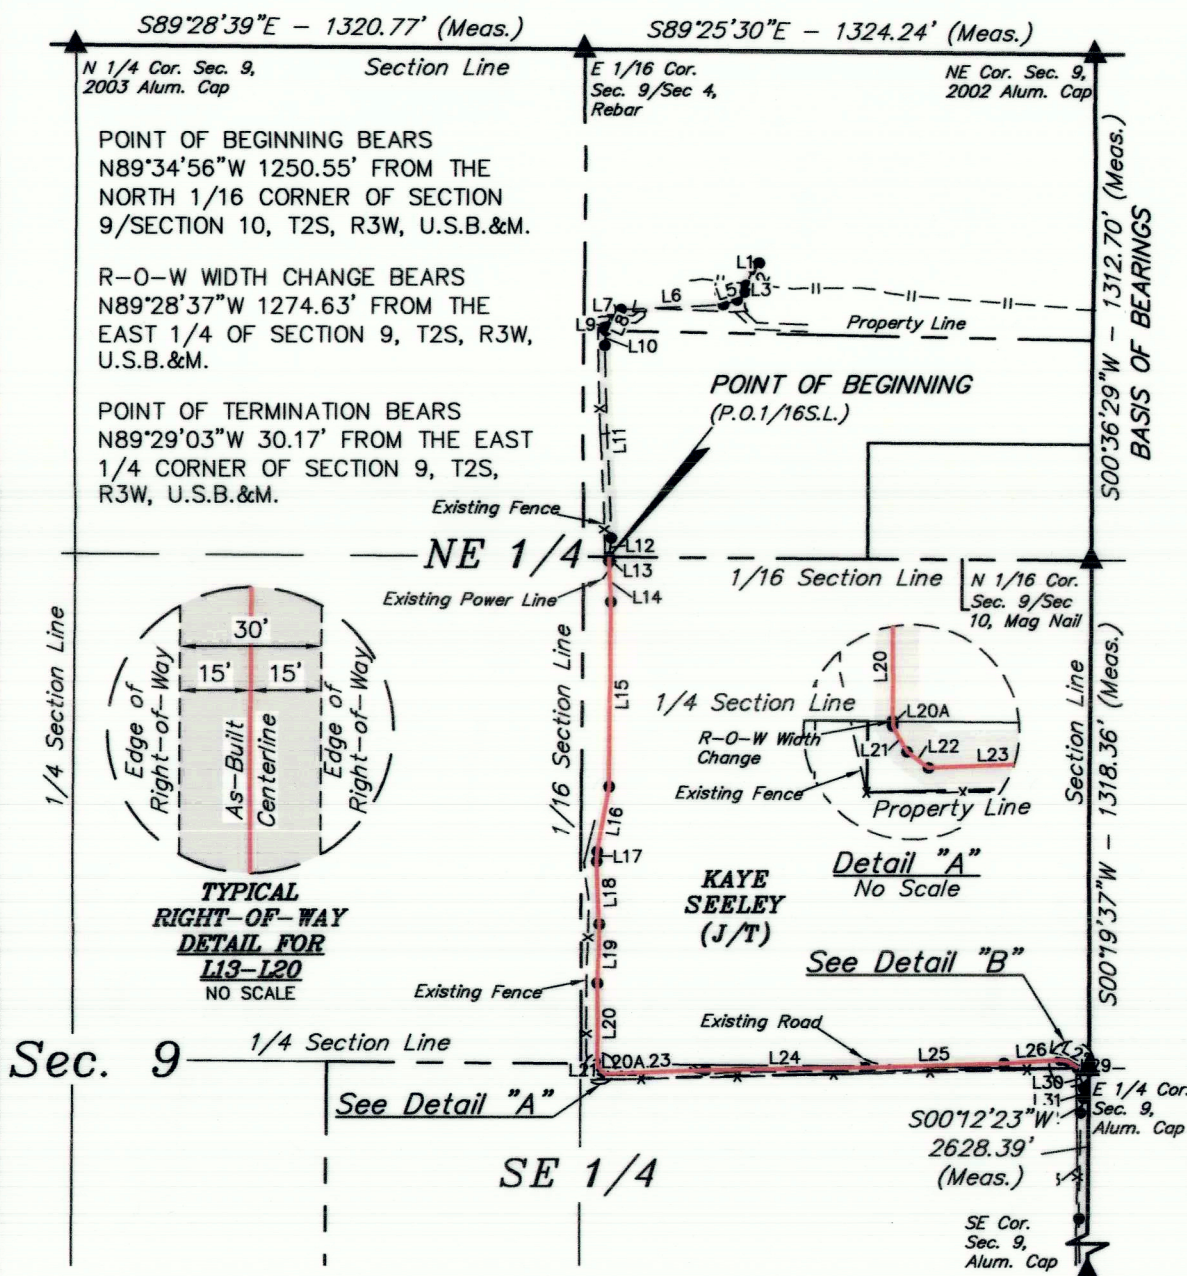


LINE TABLE		
LINE	DIRECTION	LENGTH
L13	S05°57'43\"W	10.53'
L14	S02°21'22\"E	106.38'
L15	S00°18'56\"W	479.73'
L16	S10°22'09\"W	170.79'
L17	S03°05'05\"W	26.28'
L18	S01°51'10\"E	162.91'
L19	S02°10'13\"W	152.13'
L20	S00°06'59\"E	210.24'
L20A	S00°06'59\"E	2.79'
L21	S29°14'02\"E	17.06'
L22	S53°23'45\"E	15.31'
L23	N87°44'09\"E	259.85'
L24	N89°06'14\"E	415.29'
L25	N88°11'02\"E	358.69'
L26	N86°26'58\"E	145.88'
L27	S80°50'33\"E	17.29'
L28	S59°39'58\"E	30.87'
L29	S17°43'58\"E	3.55'

AS-BUILT PIPELINE RIGHT-OF-WAY DESCRIPTION

COMMENCING AT THE NORTHEAST CORNER OF SECTION 9, T2S, R3W, U.S.B.&M., THENCE S00°36'29\"W 1312.70' ALONG THE EAST LINE OF THE NE 1/4 NE 1/4 OF SAID SECTION 9 TO THE EAST 1/16 CORNER OF SAID SECTION 9 AND SECTION 10, T2S, R3W, U.S.B.&M; THENCE N89°34'56\"W 1250.55' TO A POINT ON THE NORTH LINE OF THE SE 1/4 NE 1/4 OF SAID SECTION 9 AND THE POINT OF BEGINNING; THENCE A 30' WIDE RIGHT-OF-WAY 15' ON EACH SIDE OF THE FOLLOWING DESCRIBED CENTERLINE, S05°57'43\"W 10.53'; THENCE S02°21'22\"E 106.38'; THENCE S00°18'56\"W 479.73'; THENCE S10°22'09\"W 170.79'; THENCE S03°05'05\"W 26.28'; THENCE S01°51'10\"E 162.91'; THENCE S02°10'13\"W 152.13'; THENCE S00°06'59\"E 210.24' TO A POINT IN THE NE 1/4 SE 1/4 OF SAID SECTION 9, WHICH BEARS N89°28'37\"W 1274.63' FROM THE EAST 1/4 CORNER OF SAID SECTION 9; THENCE A 30' WIDE RIGHT-OF-WAY 10' ON THE RIGHT SIDE AND 20' ON THE LEFT SIDE OF THE FOLLOWING DESCRIBED CENTERLINE, S00°06'59\"E 2.79'; THENCE S29°14'02\"E 17.06'; THENCE S53°23'45\"E 15.31'; THENCE N87°44'09\"E 259.85'; THENCE N89°06'14\"E 415.29'; THENCE N88°11'02\"E 358.69'; THENCE N86°26'58\"E 145.88'; THENCE S80°50'33\"E 17.29'; THENCE S59°39'58\"E 30.87'; THENCE S17°43'58\"E 3.55' TO A POINT ON THE SOUTH LINE OF THE SE 1/4 NE 1/4 OF SAID SECTION 9 AND THE POINT OF TERMINATION, WHICH BEARS N89°29'03\"W 30.17' FROM THE EAST 1/4 CORNER OF SAID SECTION 9. THE SIDE LINES OF SAID DESCRIBED RIGHT-OF-WAY BEING SHORTENED OR ELONGATED TO MEET THE GRANTOR'S PROPERTY LINES. CONTAINS 1.781 ACRES MORE OR LESS.

ACREAGE / LENGTH TABLE		
FEET	RODS	ACRES
2585.57	156.70	1.781

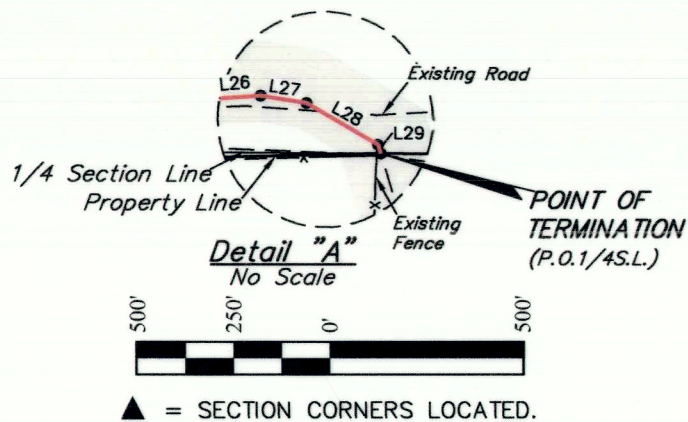

CERTIFICATE

THIS IS TO CERTIFY THAT THE ABOVE PLAT WAS PREPARED FROM FIELD NOTES OF ACTUAL SURVEYS MADE BY ME OR UNDER MY SUPERVISION AND THAT THE SAME ARE TRUE AND CORRECT TO THE BEST OF MY KNOWLEDGE AND BELIEF.

Brandon L. Rowthorpe
REGISTERED LAND SURVEYOR
REGISTRATION NO. 6631032
STATE OF UTAH

XCL ASSETCO., LLC

MAIN TRUNK LINE
AS-BUILT PIPELINE RIGHT-OF-WAY ON
KAYE SEELEY (J/T) LANDS IN
SECTION 9, T2S, R3W, U.S.B.&M.
DUCHESE COUNTY, UTAH

SURVEYED BY	C.R.	11-05-20	SCALE
DRAWN BY	S.O.	11-12-20	1" = 500'
FILE:	X-1392-C		

AS-BUILT PIPELINE RIGHT-OF-WAY

U. INTAH
ENGINEERING & LAND SURVEYING

UELS, LLC
Corporate Office * 85 South 200 East
Vernal, UT 84078 * (435) 789-1017

County Surveyor's File # 4766