

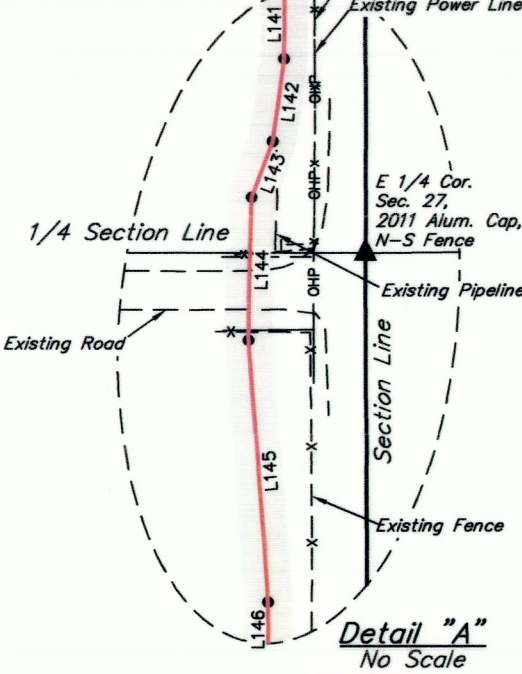
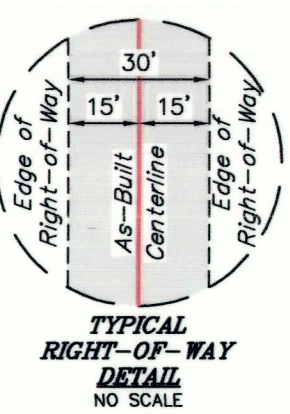


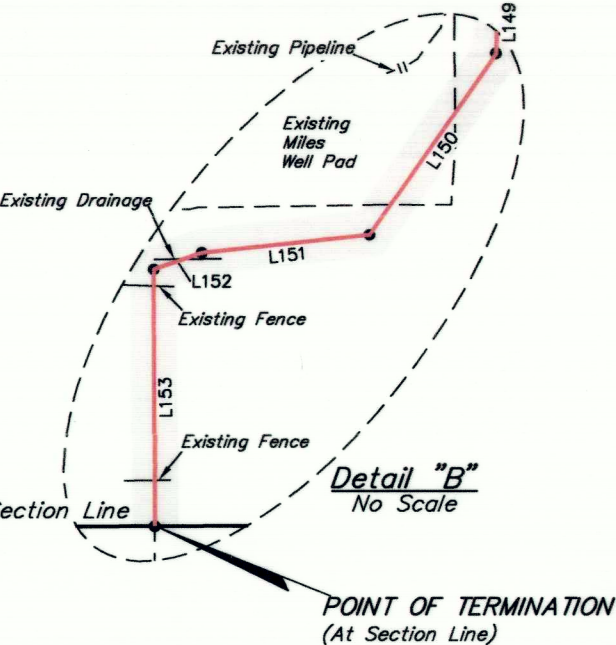

ACREAGE / LENGTH TABLE		
FEET	RODS	ACRES
4094.57	248.16	2.820

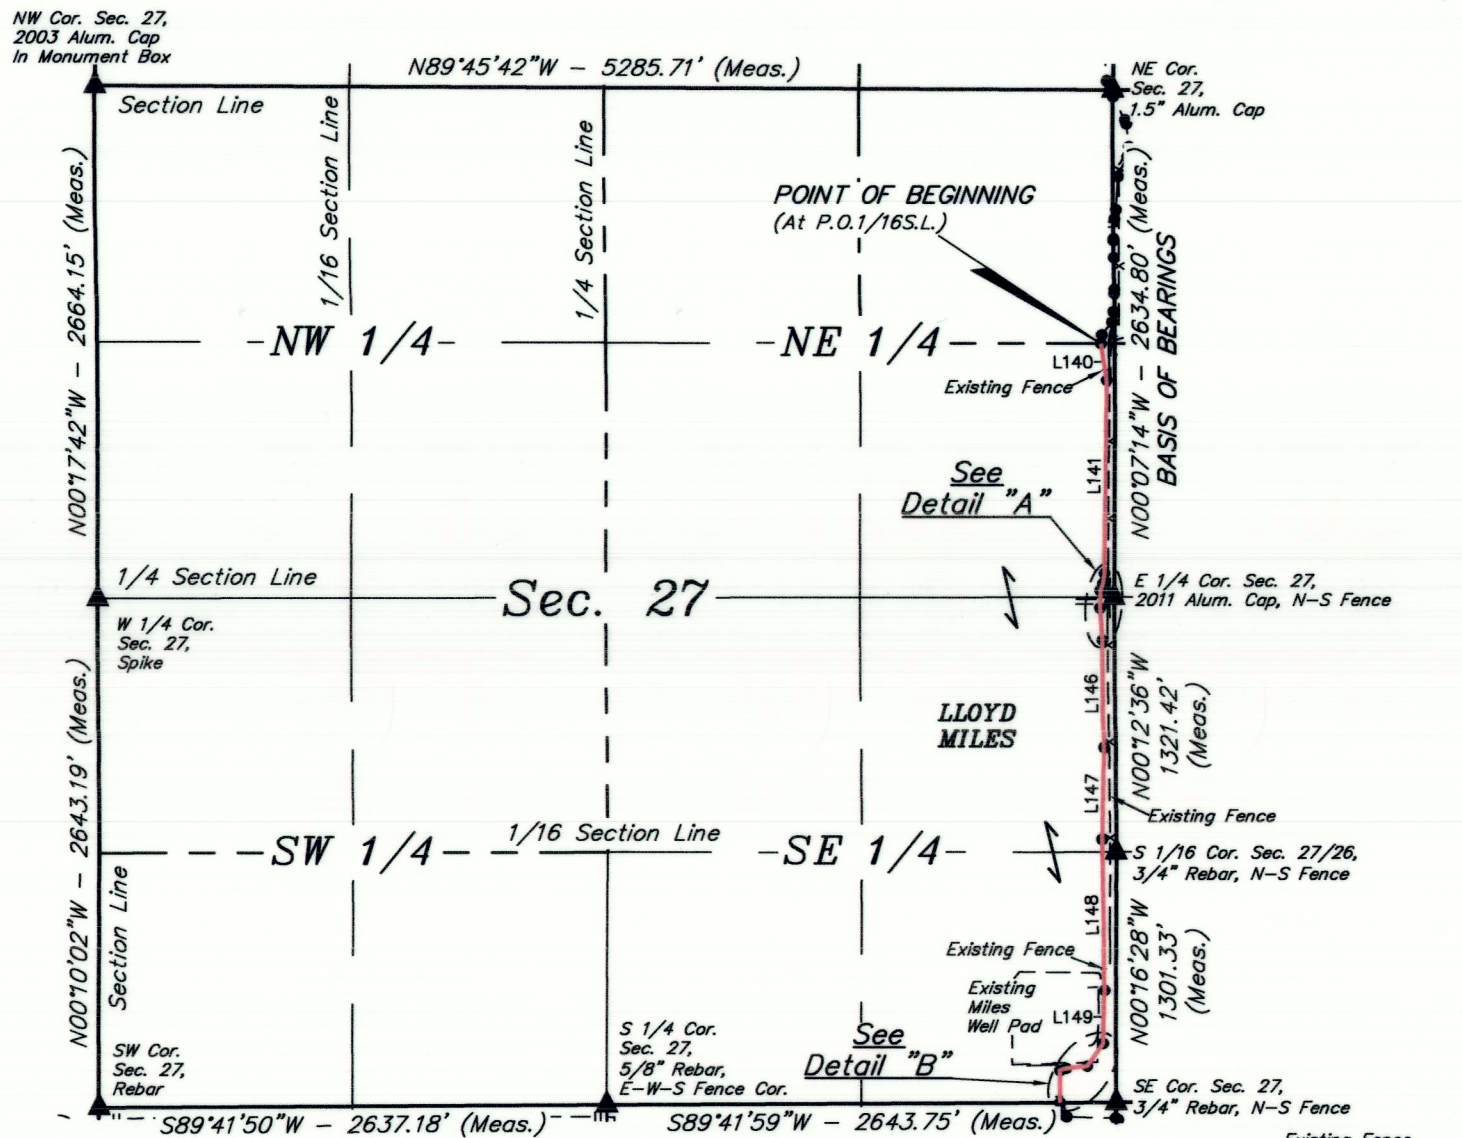

▲ = SECTION CORNERS LOCATED.

CERTIFICATE
THIS IS TO CERTIFY THAT THE ABOVE PLAT WAS PREPARED FROM FIELD NOTES OF ACTUAL SURVEYS MADE BY ME OR UNDER MY SUPERVISION AND THAT THE SAME ARE TRUE AND CORRECT TO THE BEST OF MY KNOWLEDGE AND BELIEF.

REGISTERED LAND SURVEYOR
REGISTRATION NO. 6631032
STATE OF UTAH

XCL ASSETCO., LLC

MAIN TRUNK LINE
AS-BUILT PIPELINE RIGHT-OF-WAY ON
LLOYD MILES LANDS
SECTION 27, T2S, R3W, U.S.B.&M.
DUCESNE COUNTY, UTAH

SURVEYED BY	C.R.	11-05-20	SCALE
DRAWN BY	S.O.	11-12-20	1" = 1000'
FILE:	X-1392-T1		

AS-BUILT PIPELINE RIGHT-OF-WAY



UELS, LLC
Corporate Office * 85 South 200 East
Vernal, UT 84078 * (435) 789-1017

AS-BUILT PIPELINE RIGHT-OF-WAY DESCRIPTION

A 30' WIDE RIGHT-OF-WAY 15' ON EACH SIDE OF THE FOLLOWING DESCRIBED CENTERLINE.

COMMENCING AT THE EAST 1/4 CORNER OF SECTION 27, T2S, R3W, U.S.B.&M., THENCE N00°07'14"W 2634.80' ALONG THE EAST LINE OF THE NE 1/4 OF SAID SECTION 27 TO THE NORTHEAST CORNER OF SAID SECTION 27; THENCE S03°59'44"W 1319.10' TO A POINT ON THE NORTH LINE OF THE SE 1/4 NE 1/4 OF SAID SECTION 27 AND THE POINT OF BEGINNING; THENCE S08°44'19"E 192.52'; THENCE S00°23'46"W 1003.78'; THENCE S08°03'00"W 53.26'; THENCE S20°17'11"W 38.04'; THENCE S01°00'11"W 90.78'; THENCE S04°16'21"E 167.22'; THENCE S00°22'36"E 555.50'; THENCE S01°21'16"W 478.60'; THENCE S01°17'56"E 782.60'; THENCE S01°08'21"W 276.79'; THENCE S34°57'10"W 144.27'; THENCE S83°50'44"W 110.16'; THENCE S70°57'03"W 33.28'; THENCE S00°10'54"E 167.77' TO A POINT ON THE SOUTH LINE OF THE SE 1/4 SE 1/4 OF SAID SECTION 27 AND THE POINT OF TERMINATION, WHICH BEARS S89°41'59"W 291.56' FROM THE SOUTHEAST CORNER OF SAID SECTION 27. THE SIDE LINES OF SAID DESCRIBED RIGHT-OF-WAY BEING SHORTENED OR ELONGATED TO MEET THE GRANTOR'S PROPERTY LINES. CONTAINS 2.820 ACRES MORE OR LESS.

LINE TABLE		
LINE	DIRECTION	LENGTH
L140	S08°44'19"E	192.52'
L141	S00°23'46"W	1003.78'
L142	S08°03'00"W	53.26'
L143	S20°17'11"W	38.04'
L144	S01°00'11"W	90.78'
L145	S04°16'21"E	167.22'
L146	S00°22'36"E	555.50'
L147	S01°21'16"W	478.60'
L148	S01°17'56"E	782.60'
L149	S01°08'21"W	276.79'
L150	S34°57'10"W	144.27'
L151	S83°50'44"W	110.16'
L152	S70°57'03"W	33.28'
L153	S00°10'54"E	167.77'

POINT OF BEGINNING BEARS
S03°59'44"W 1319.10' FROM THE
NORTHEAST CORNER OF SECTION 27,
T2S, R3W, U.S.B.&M.

POINT OF TERMINATION BEARS
S89°41'59"W 291.56' FROM THE
SOUTHEAST CORNER OF SECTION 27,
T2S, R3W, U.S.B.&M.

CERTIFICATE
THIS IS TO CERTIFY THAT THE ABOVE PLAT WAS PREPARED FROM FIELD NOTES OF ACTUAL SURVEYS MADE BY ME OR UNDER MY SUPERVISION AND THAT THE SAME ARE TRUE AND CORRECT TO THE BEST OF MY KNOWLEDGE AND BELIEF.

REGISTERED LAND SURVEYOR
REGISTRATION NO. 6631032
STATE OF UTAH

XCL ASSETCO., LLC

MAIN TRUNK LINE
AS-BUILT PIPELINE RIGHT-OF-WAY ON
LLOYD MILES LANDS
SECTION 27, T2S, R3W, U.S.B.&M.
DUCESNE COUNTY, UTAH

SURVEYED BY	C.R.	11-05-20	SCALE
DRAWN BY	S.O.	11-12-20	N/A
FILE:	X-1392-T2		

AS-BUILT PIPELINE RIGHT-OF-WAY



UELS, LLC
Corporate Office * 85 South 200 East
Vernal, UT 84078 * (435) 789-1017