


**"AS-BUILT" SURVEY FOR
ELPASO E&P, CO.
BOURNAKIS 3-18B4
SECTION 18, TOWNSHIP 2 SOUTH, RANGE 4 WEST
UINTAH SPECIAL BASE AND MERIDIAN**




SCALE: 1=200'

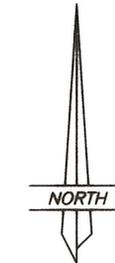

THIS SURVEY WAS PERFORMED USING GLOBAL POSITIONING SYSTEM PROCEDURES AND EQUIPMENT

THE BASIS OF BEARINGS IS GEODETIC NORTH DERIVED FROM G.P.S. OBSERVATIONS USING THE UTAH STATE G.P.S. VIRTUAL REFERENCE STATION CONTROL NETWORK MAINTAINED AND OPERATED BY THE AUTOMATED GEOGRAPHIC REFERENCE CENTER

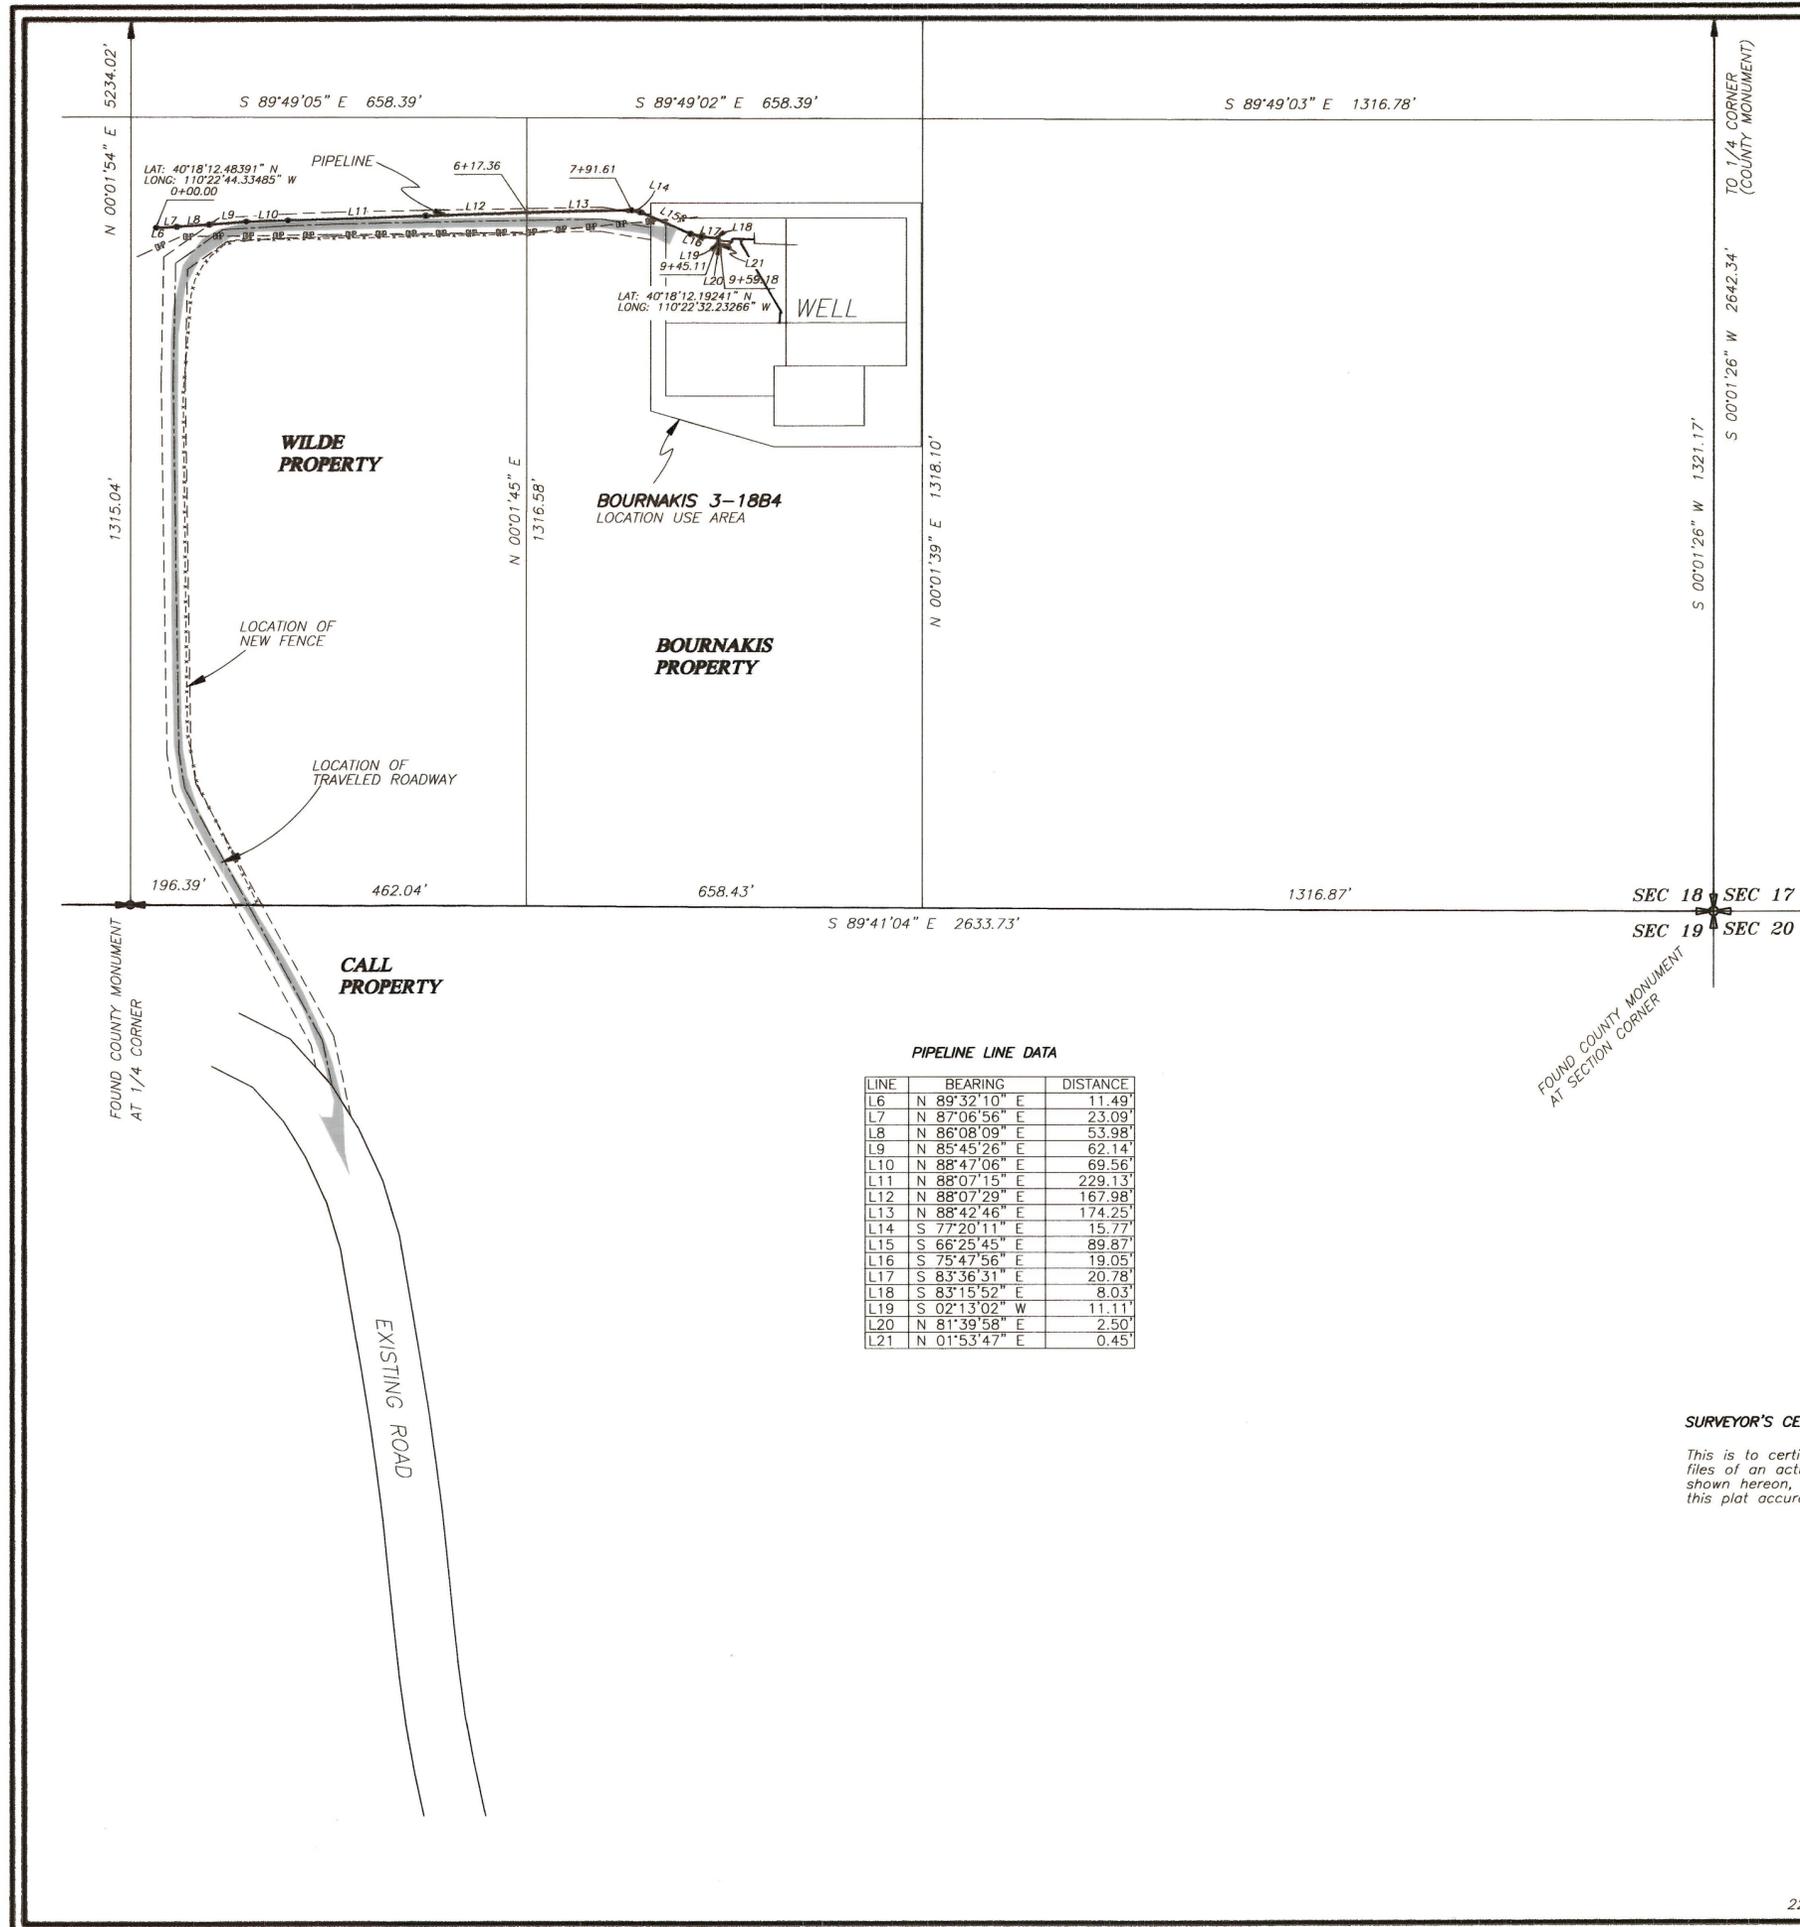


PIPELINE LINE DATA

LINE	BEARING	DISTANCE
L6	N 89°32'10" E	11.49'
L7	N 87°06'56" E	23.09'
L8	N 86°08'09" E	53.98'
L9	N 85°45'26" E	62.14'
L10	N 88°47'06" E	69.56'
L11	N 88°07'15" E	229.13'
L12	N 88°07'29" E	167.98'
L13	N 88°42'46" E	174.25'
L14	S 77°20'11" E	15.77'
L15	S 66°25'45" E	89.87'
L16	S 75°47'56" E	19.05'
L17	S 83°36'31" E	20.78'
L18	S 83°15'52" E	8.03'
L19	S 02°13'02" W	11.11'
L20	N 81°39'58" E	2.50'
L21	N 01°53'47" E	0.45'


SURVEYOR'S CERTIFICATE

This is to certify that this plat was prepared from the field notes and electronic data collector files of an actual survey made by me, or under my personal supervision, of the parcel of land shown hereon, and that the monuments indicated were found or set during said survey, and that this plat accurately represents said survey to the best of my knowledge.

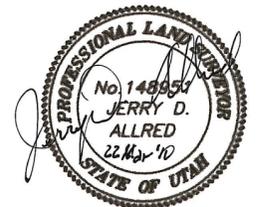

Jerry D. Allred, Professional Land Surveyor,
Certificate No. 148951, (Utah)

COUNTY SURVEYOR'S FILE # 2246

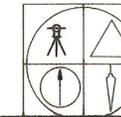

JERRY D. ALLRED AND ASSOCIATES
SURVEYING CONSULTANTS

1235 NORTH 700 EAST--P.O. BOX 975
DUCHESNE, UTAH 84021
(435) 738-5352