



PIPELINE AS-BUILT SURVEY FOR
KINDER MORGAN ALTAMONT, LLC.
ALLEN 3-8B4
 SECTION 8, T2S, R4W, U.S.B.&M.
 DUCHESNE COUNTY, UTAH

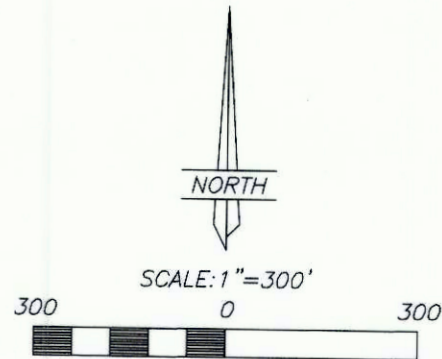

LINE	BEARING	DISTANCE
L1	N 44°36'40" W	76.78'
L2	N 56°02'15" W	109.58'
L3	S 85°08'48" W	126.97'
L4	S 79°48'02" W	269.27'
L5	S 80°35'34" W	254.39'
L6	S 78°45'11" W	74.04'
L7	N 88°13'56" W	62.47'
L8	N 44°16'47" W	58.78'
L9	N 39°41'32" W	29.90'
L10	S 09°41'57" E	4.49'

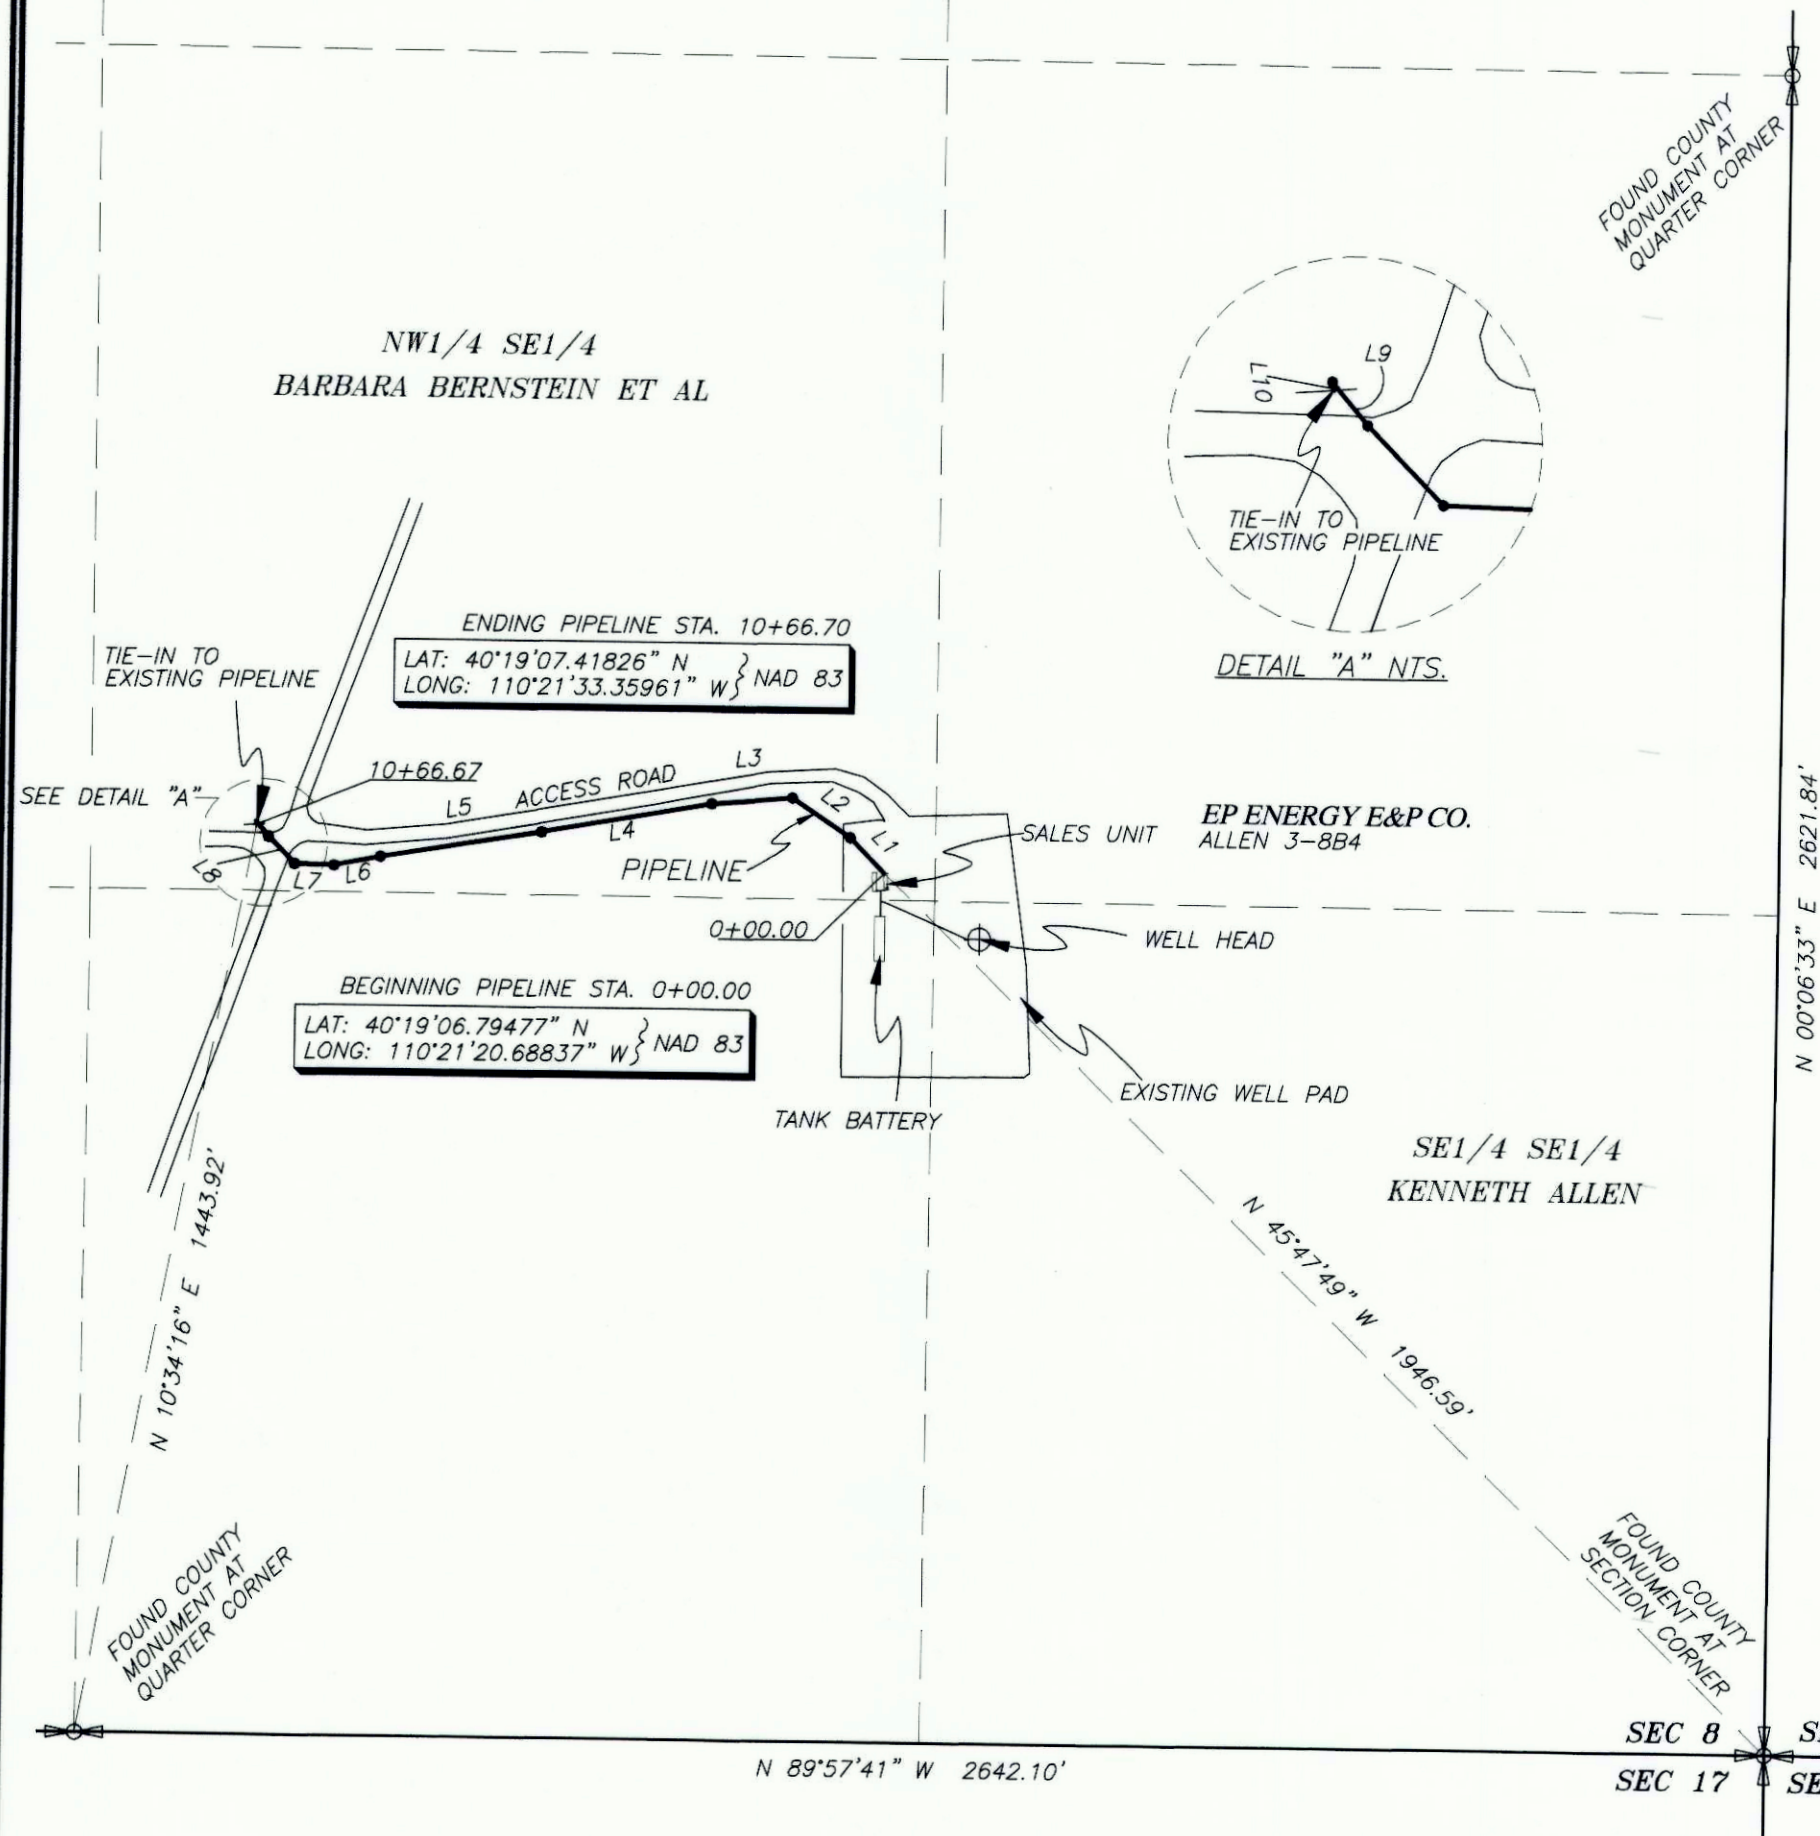


THIS SURVEY WAS PERFORMED USING GLOBAL POSITIONING SYSTEM PROCEDURES AND EQUIPMENT

THE BASIS OF BEARINGS IS GEODETIC NORTH DERIVED FROM G.P.S. OBSERVATIONS AT A SECTION CORNER LOCATED AT LAT. 40°21'33.56882"N AND LONG. 110°16'31.53266"W USING THE UTAH STATE G.P.S. VIRTUAL REFERENCE STATION CONTROL NETWORK MAINTAINED AND OPERATED BY THE AUTOMATED GEOGRAPHIC REFERENCE CENTER


SURVEYOR'S CERTIFICATE

This is to certify that this plat was prepared from the field notes and electronic data collector files of an actual survey made by me, or under my personal supervision, of the pipeline shown hereon, and that this plat accurately represents said survey to the best of my knowledge.

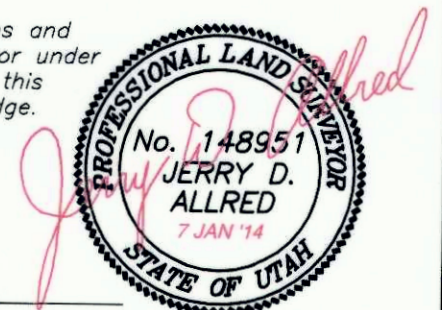

JERRY D. ALLRED, REGISTERED LAND SURVEYOR,
 CERTIFICATE NO. 148951 (UTAH)

COUNTY SURVEYOR'S FILE NUMBER

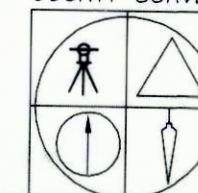


JERRY D. ALLRED AND ASSOCIATES
 SURVEYING CONSULTANTS
 1235 NORTH 700 EAST--P.O. BOX 975
 DUCHESNE, UTAH 84021
 (435) 738-5352

PIPELINE AS-BUILT SURVEY FOR
KINDER MORGAN ALTAMONT, LLC.
ROWLEY 3-16B4
 SECTION 16 & 17, T2S, R4W, U.S.B.&M.
 DUCHESNE COUNTY, UTAH


LINE	BEARING	DISTANCE
L1	N 25°52'17" W	5.07'
L2	N 57°16'41" W	66.45'
L3	N 68°55'05" W	71.23'
L4	N 75°33'49" W	19.13'
L5	S 89°43'05" W	139.77'
L6	N 85°24'01" W	147.93'
L7	N 86°33'57" W	174.60'
L8	S 87°49'52" W	238.22'
L9	S 72°09'51" W	94.53'
L10	S 35°32'40" W	25.50'
L11	S 01°38'06" W	47.52'
L12	S 09°50'38" E	81.61'
L13	S 24°56'05" W	10.48'
L14	S 80°39'07" W	11.14'
L15	S 12°17'20" E	10.44'
L16	S 82°18'46" W	7.70'

THIS SURVEY WAS PERFORMED USING GLOBAL POSITIONING SYSTEM PROCEDURES AND EQUIPMENT
 THE BASIS OF BEARINGS IS GEODETIC NORTH DERIVED FROM G.P.S. OBSERVATIONS AT A SECTION CORNER LOCATED AT LAT. 40°21'33.56882"N AND LONG. 110°16'31.53266"W USING THE UTAH STATE G.P.S. VIRTUAL REFERENCE STATION CONTROL NETWORK MAINTAINED AND OPERATED BY THE AUTOMATED GEOGRAPHIC REFERENCE CENTER

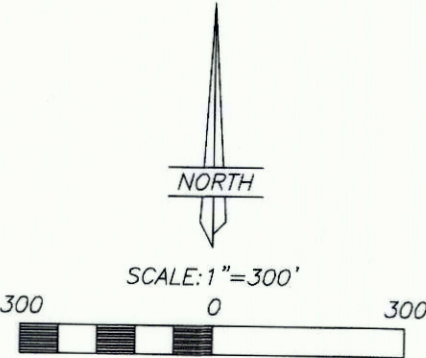


SURVEYOR'S CERTIFICATE

This is to certify that this plat was prepared from the field notes and electronic data collector files of an actual survey made by me, or under my personal supervision, of the pipeline shown hereon, and that this plat accurately represents said survey to the best of my knowledge.

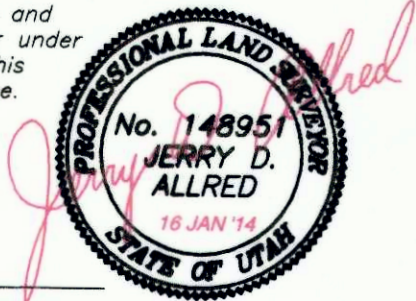

JERRY D. ALLRED, REGISTERED LAND SURVEYOR,
 CERTIFICATE NO. 148951 (UTAH)

COUNTY SURVEYOR'S FILE NUMBER

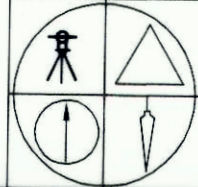


JERRY D. ALLRED AND ASSOCIATES
 SURVEYING CONSULTANTS

1235 NORTH 700 EAST--P.O. BOX 975
 DUCHESNE, UTAH 84021
 (435) 738-5352


16 JAN 2014 12-121-130

County Surveyors File# 2928

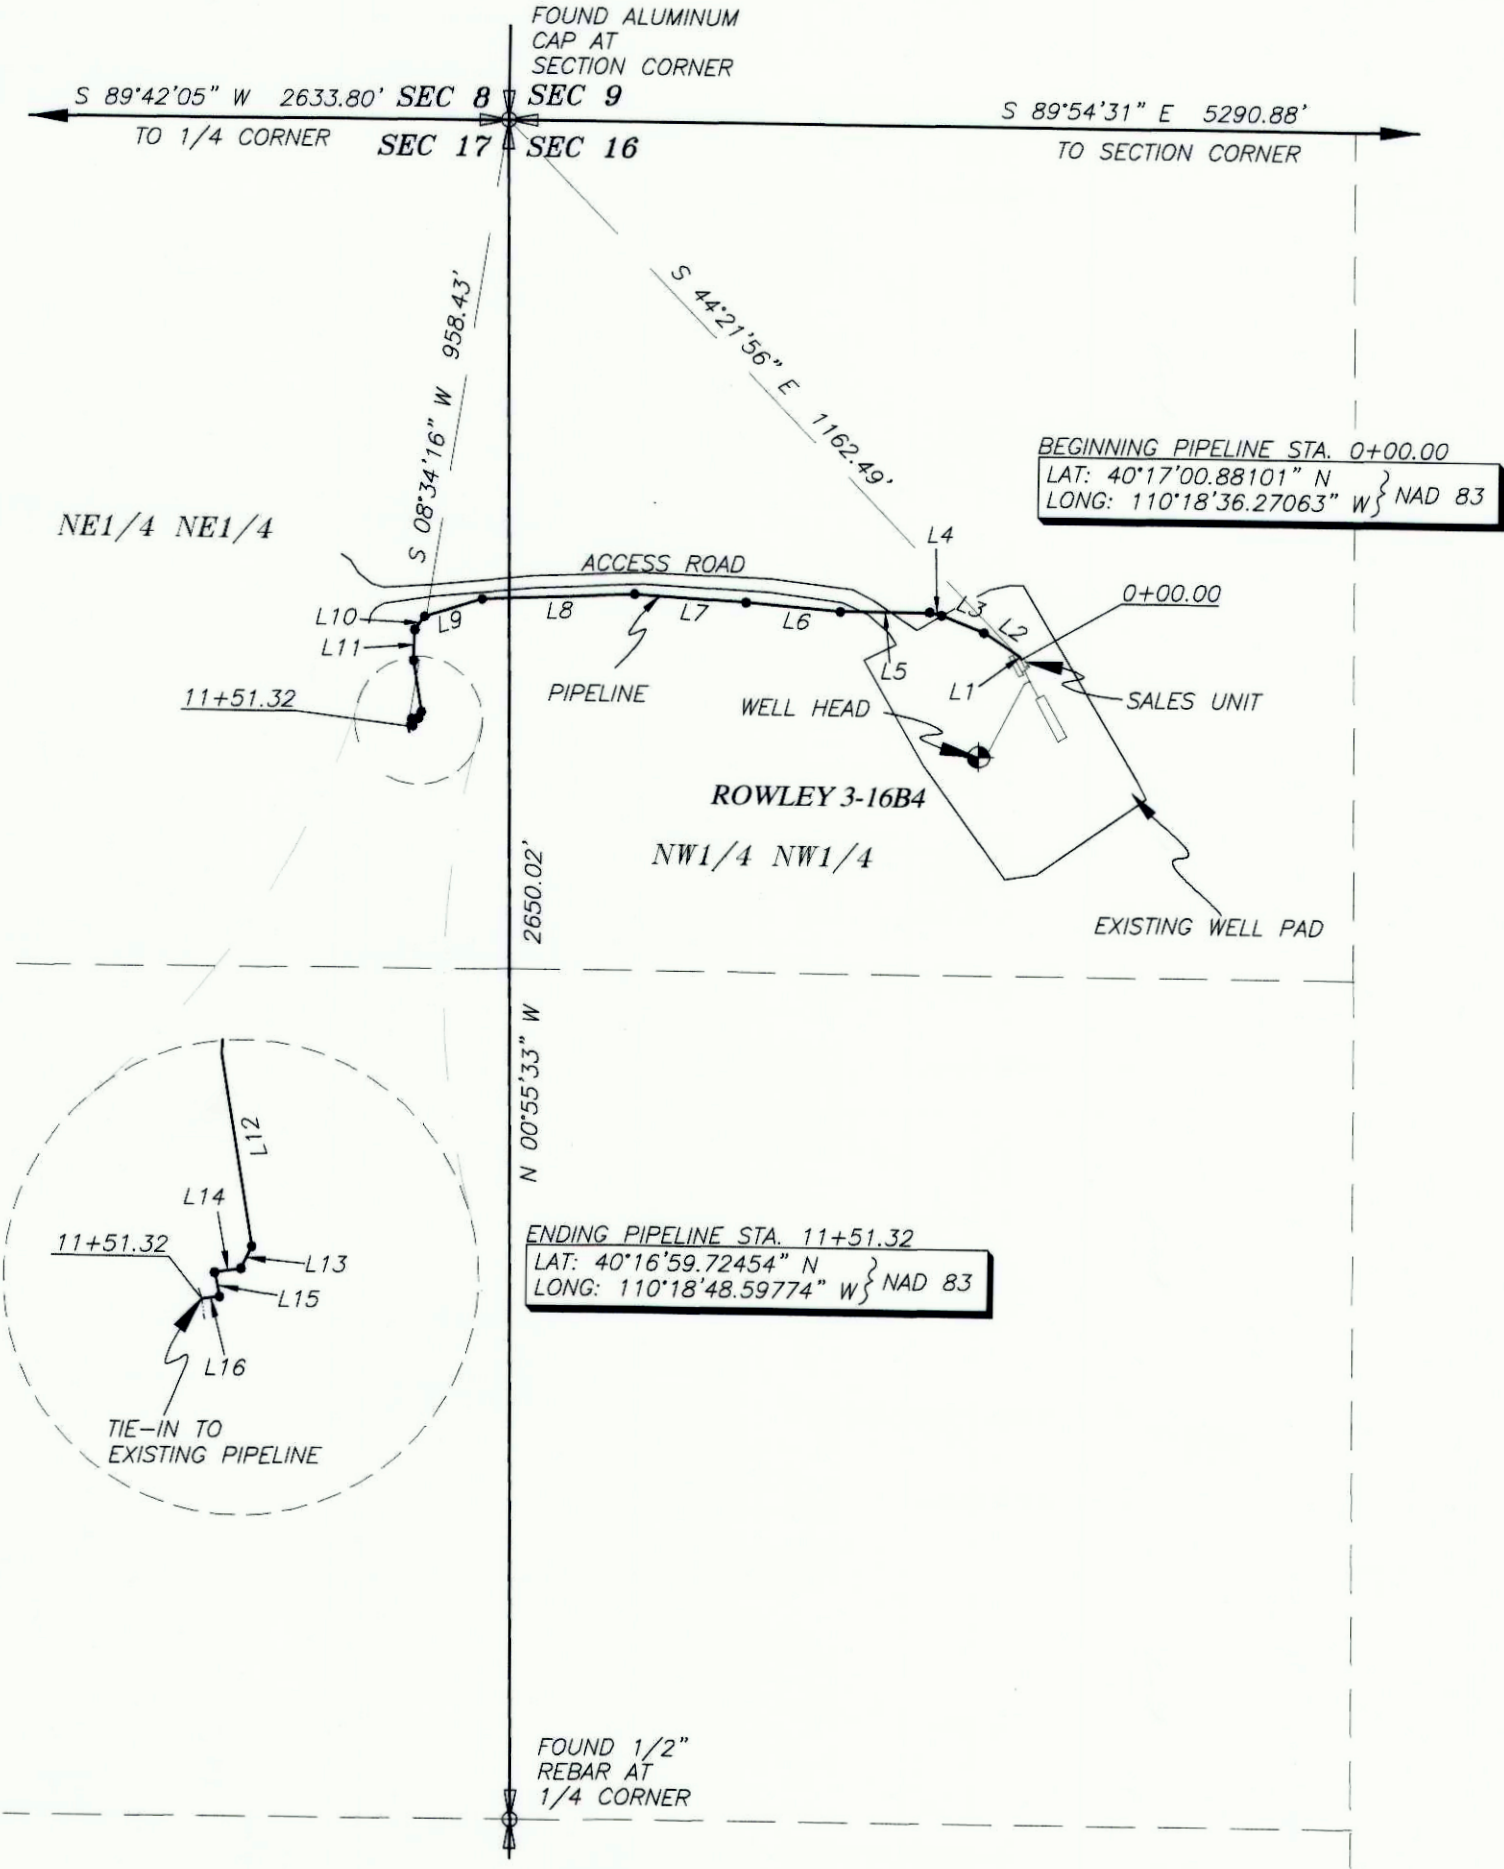


PIPELINE AS-BUILT SURVEY FOR
KINDER MORGAN ALTAMONT, LLC.
LAKE FORK RANCH 3-13B4
 SECTION 13, T2S, R4W, U.S.B.&M.
 DUCHESNE COUNTY, UTAH

LINE	BEARING	DISTANCE
L1	S 89°45'54" W	6.59'
L2	N 60°58'38" W	22.54'
L3	S 76°40'17" W	41.66'
L4	N 73°55'54" W	131.17'
L5	N 54°55'42" W	144.15'
L6	N 10°29'03" W	84.19'
L7	N 00°19'51" E	171.47'
L8	N 00°24'29" E	187.36'
L9	N 00°45'12" W	191.76'
L10	N 14°26'50" W	184.65'
L11	N 22°58'53" W	168.92'
L12	N 22°17'47" W	175.18'
L13	N 23°37'37" W	199.30'
L14	N 23°39'18" W	174.58'
L15	N 23°44'54" W	105.94'
L16	N 20°36'57" W	186.13'
L17	N 18°22'56" W	238.82'
L18	N 34°55'34" W	126.80'
L19	N 83°38'48" W	33.91'

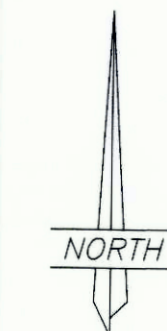

SCALE: 1"=300'

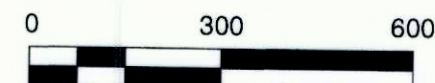


THIS SURVEY WAS PERFORMED USING GLOBAL POSITIONING SYSTEM PROCEDURES AND EQUIPMENT

THE BASIS OF BEARINGS IS GEODETIC NORTH DERIVED FROM G.P.S. OBSERVATIONS AT A CONTROL POINT LOCATED AT LAT. 40°21'33.56882"N AND LONG. 110°16'31.53266"W USING THE UTAH STATE G.P.S. VIRTUAL REFERENCE STATION CONTROL NETWORK MAINTAINED AND OPERATED BY THE AUTOMATED GEOGRAPHIC REFERENCE CENTER


SURVEYOR'S CERTIFICATE

This is to certify that this plat was prepared from the field notes and electronic data collector files of an actual survey made by me, or under my personal supervision of the pipeline shown hereon, and that the monuments indicated were found or set during said survey, and that this plat accurately represents said survey to the best of my knowledge.

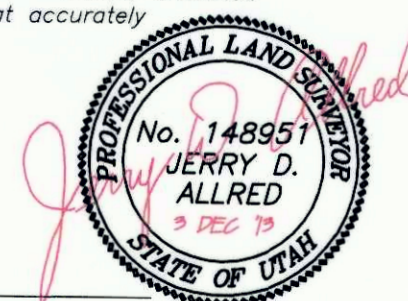

JERRY D. ALLRED, REGISTERED LAND SURVEYOR,
 CERTIFICATE NO. 148951 (UTAH)

COUNTY SURVEYOR'S FILE NUMBER 2928

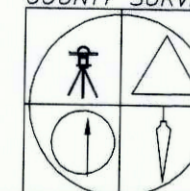

JERRY D. ALLRED AND ASSOCIATES
 SURVEYING CONSULTANTS

1235 NORTH 700 EAST--P.O. BOX 975
 DUCHESNE, UTAH 84021
 (435) 738-5352

