



PIPELINE AS-BUILT SURVEY FOR
KINDER MORGAN ALTAMONT, LLC.
LAKE FORK RANCH 4-23B4
SECTION 23, T2S, R4W, U.S.B.&M.
DUCESNE COUNTY, UTAH

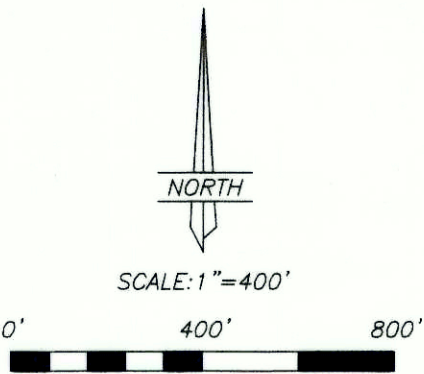

LINE	BEARING	DISTANCE
L1	N 35°18'14" W	15.34'
L2	N 30°06'16" W	52.61'
L3	N 12°33'45" W	45.01'
L4	N 01°02'32" E	34.15'
L5	N 24°34'10" E	62.83'
L6	N 35°57'57" E	168.77'
L7	N 42°09'10" E	151.70'
L8	N 49°45'53" E	114.20'

SURVEYOR'S CERTIFICATE

This is to certify that this plat was prepared from the field notes and electronic data collector files of an actual survey made by me, or under my personal supervision of the pipeline shown hereon, and that the monuments indicated were found or set during said survey, and that this plat accurately represents said survey to the best of my knowledge.

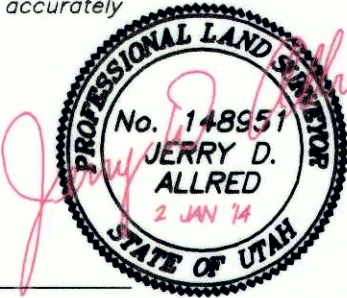


THIS SURVEY WAS PERFORMED USING GLOBAL POSITIONING SYSTEM PROCEDURES AND EQUIPMENT


THE BASIS OF BEARINGS IS GEODETIC NORTH DERIVED FROM G.P.S. OBSERVATIONS AT A CONTROL POINT LOCATED AT LAT. 40°21'33.56882"N AND LONG. 110°16'31.53266"W USING THE UTAH STATE G.P.S. VIRTUAL REFERENCE STATION CONTROL NETWORK MAINTAINED AND OPERATED BY THE AUTOMATED GEOGRAPHIC REFERENCE CENTER

JERRY D. ALLRED, REGISTERED LAND SURVEYOR,
CERTIFICATE NO. 148951 (UTAH)

COUNTY SURVEYOR'S FILE NUMBER 2929

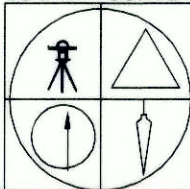

JERRY D. ALLRED AND ASSOCIATES
SURVEYING CONSULTANTS
1235 NORTH 700 EAST--P.O. BOX 975
DUCESNE, UTAH 84021
(435) 738-5352

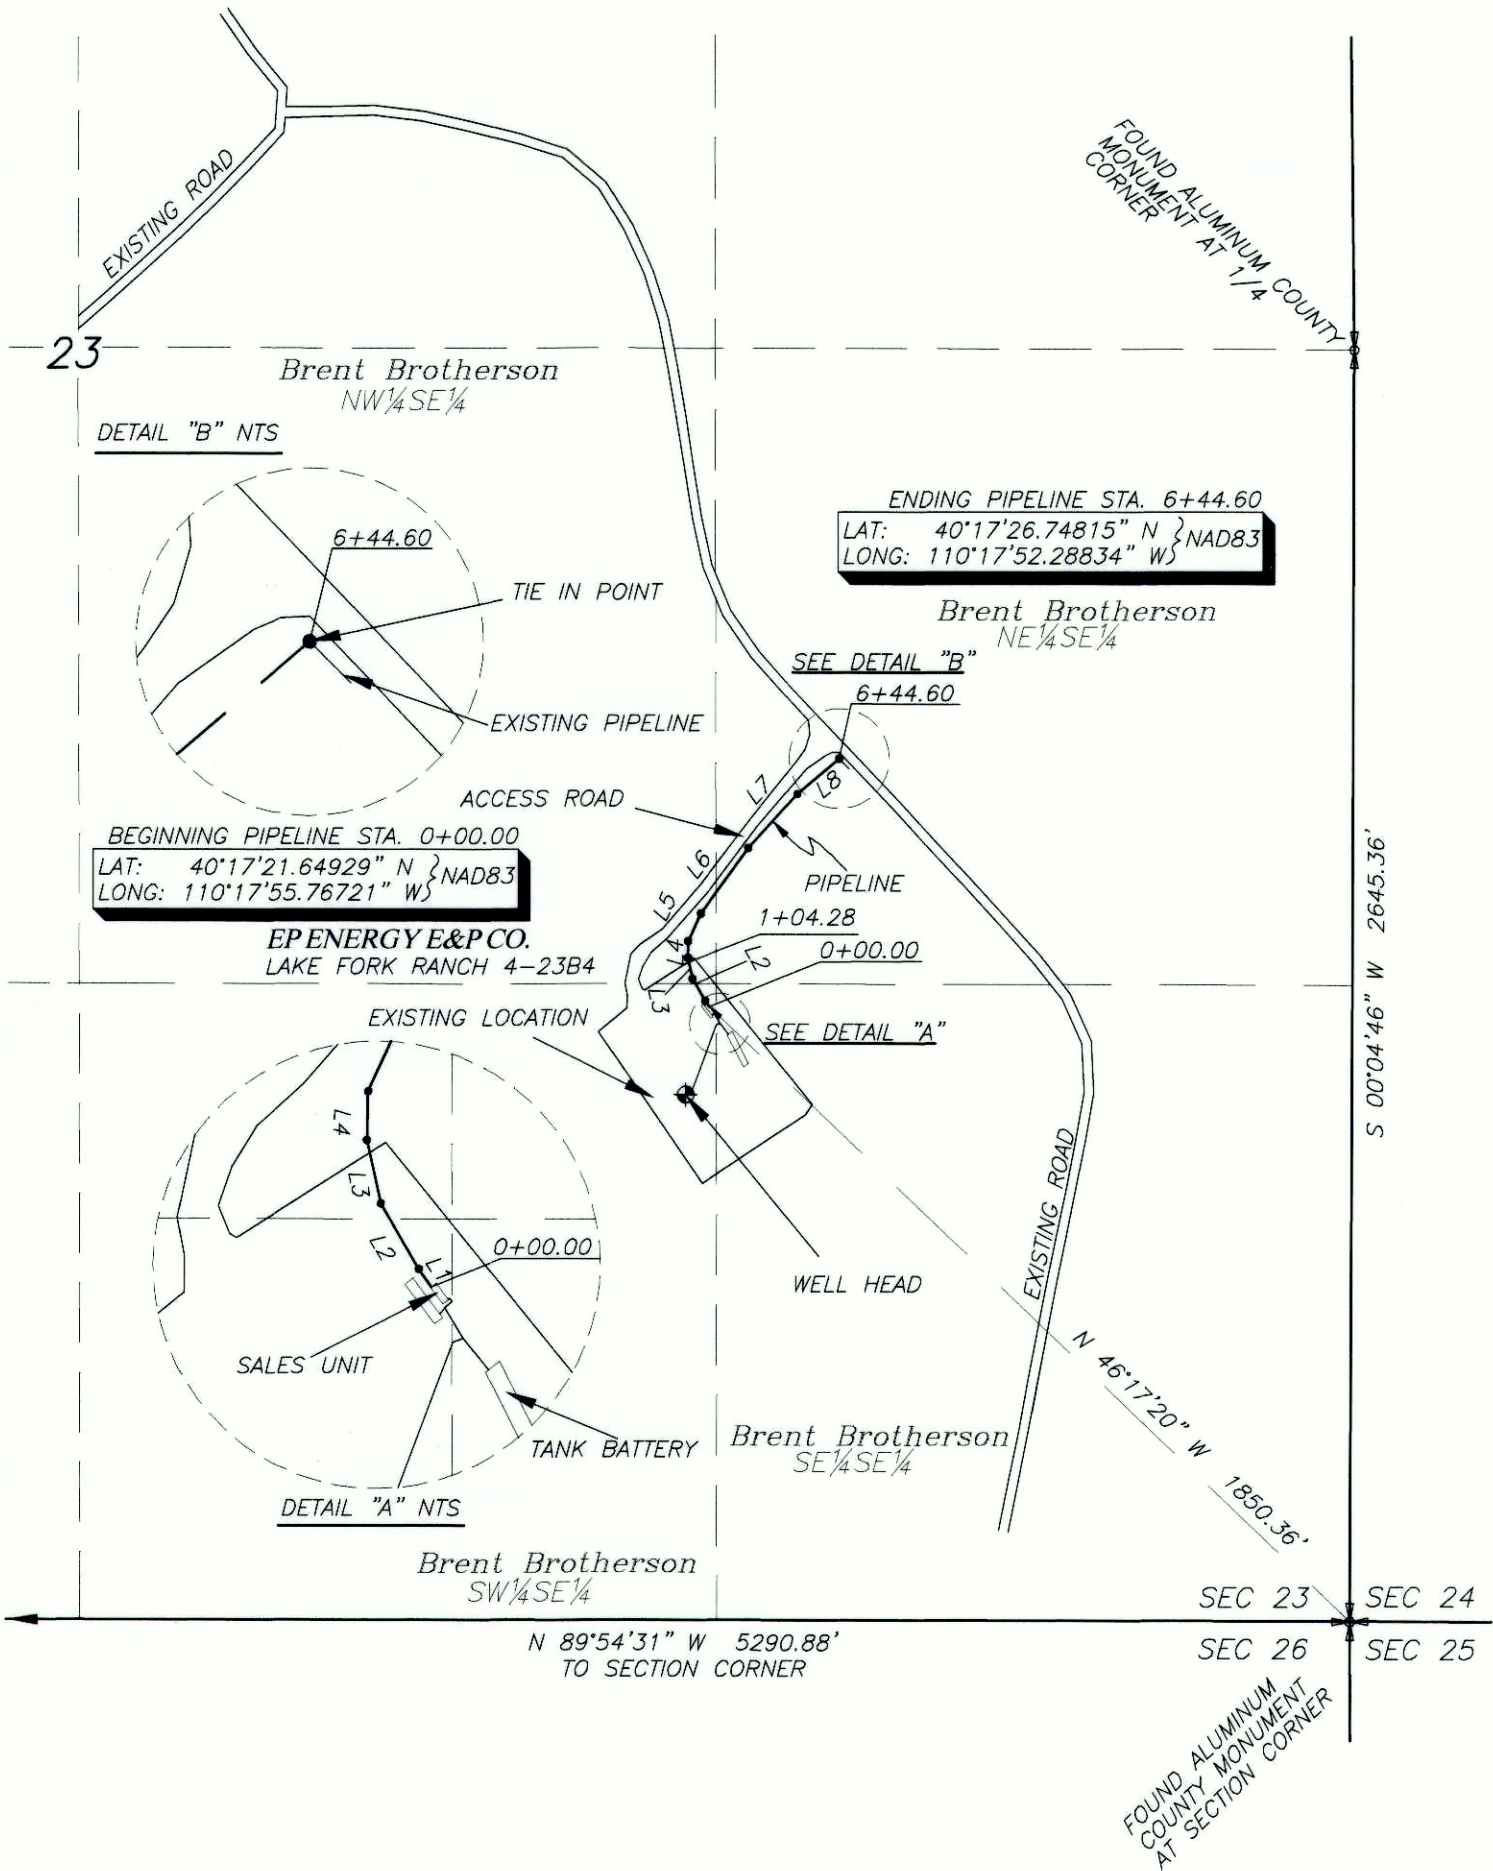

PIPELINE AS-BUILT SURVEY FOR
KINDER MORGAN ALTAMONT, LLC.
LAKE FORK RANCH 4-24B4
SECTION 24, T2S, R4W, U.S.B.&M.
DUCHESNE COUNTY, UTAH


LINE	BEARING	DISTANCE
L1	N 76°48'31" E	10.54'
L2	N 66°45'40" E	62.41'
L3	N 89°38'52" E	85.91'
L4	S 51°13'12" E	57.60'
L5	S 52°20'44" E	142.33'
L6	S 52°08'21" E	127.24'
L7	S 43°58'53" E	76.66'
L8	S 45°01'31" E	119.19'
L9	S 48°18'10" E	128.92'
L10	S 55°22'20" E	125.02'
L11	S 59°31'17" E	117.05'
L12	S 62°09'41" E	90.62'
L13	S 70°12'00" E	45.14'
L14	S 62°09'26" E	4.15'

THIS SURVEY WAS PERFORMED USING GLOBAL POSITIONING SYSTEM PROCEDURES AND EQUIPMENT

THE BASIS OF BEARINGS IS GEODETIC NORTH DERIVED FROM G.P.S. OBSERVATIONS AT A CONTROL POINT LOCATED AT LAT. 40°21'33.56882"N AND LONG. 110°16'31.53266"W USING THE UTAH STATE G.P.S. VIRTUAL REFERENCE STATION CONTROL NETWORK MAINTAINED AND OPERATED BY THE AUTOMATED GEOGRAPHIC REFERENCE CENTER


SURVEYOR'S CERTIFICATE

This is to certify that this plat was prepared from the field notes and electronic data collector files of an actual survey made by me, or under my personal supervision of the pipeline shown hereon, and that the monuments indicated were found or set during said survey, and that this plat accurately represents said survey to the best of my knowledge.

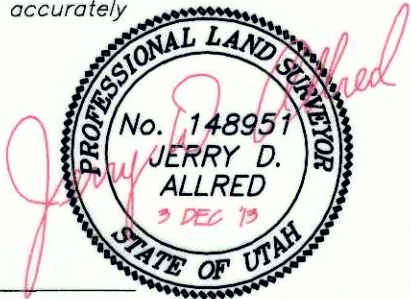


JERRY D. ALLRED, REGISTERED LAND SURVEYOR,
CERTIFICATE NO. 148951 (UTAH)

COUNTY SURVEYOR'S FILE NUMBER 2929

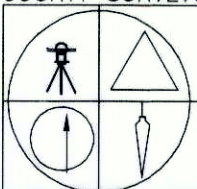

JERRY D. ALLRED AND ASSOCIATES
SURVEYING CONSULTANTS
1235 NORTH 700 EAST--P.O. BOX 975
DUCHESNE, UTAH 84021
(435) 738-5352

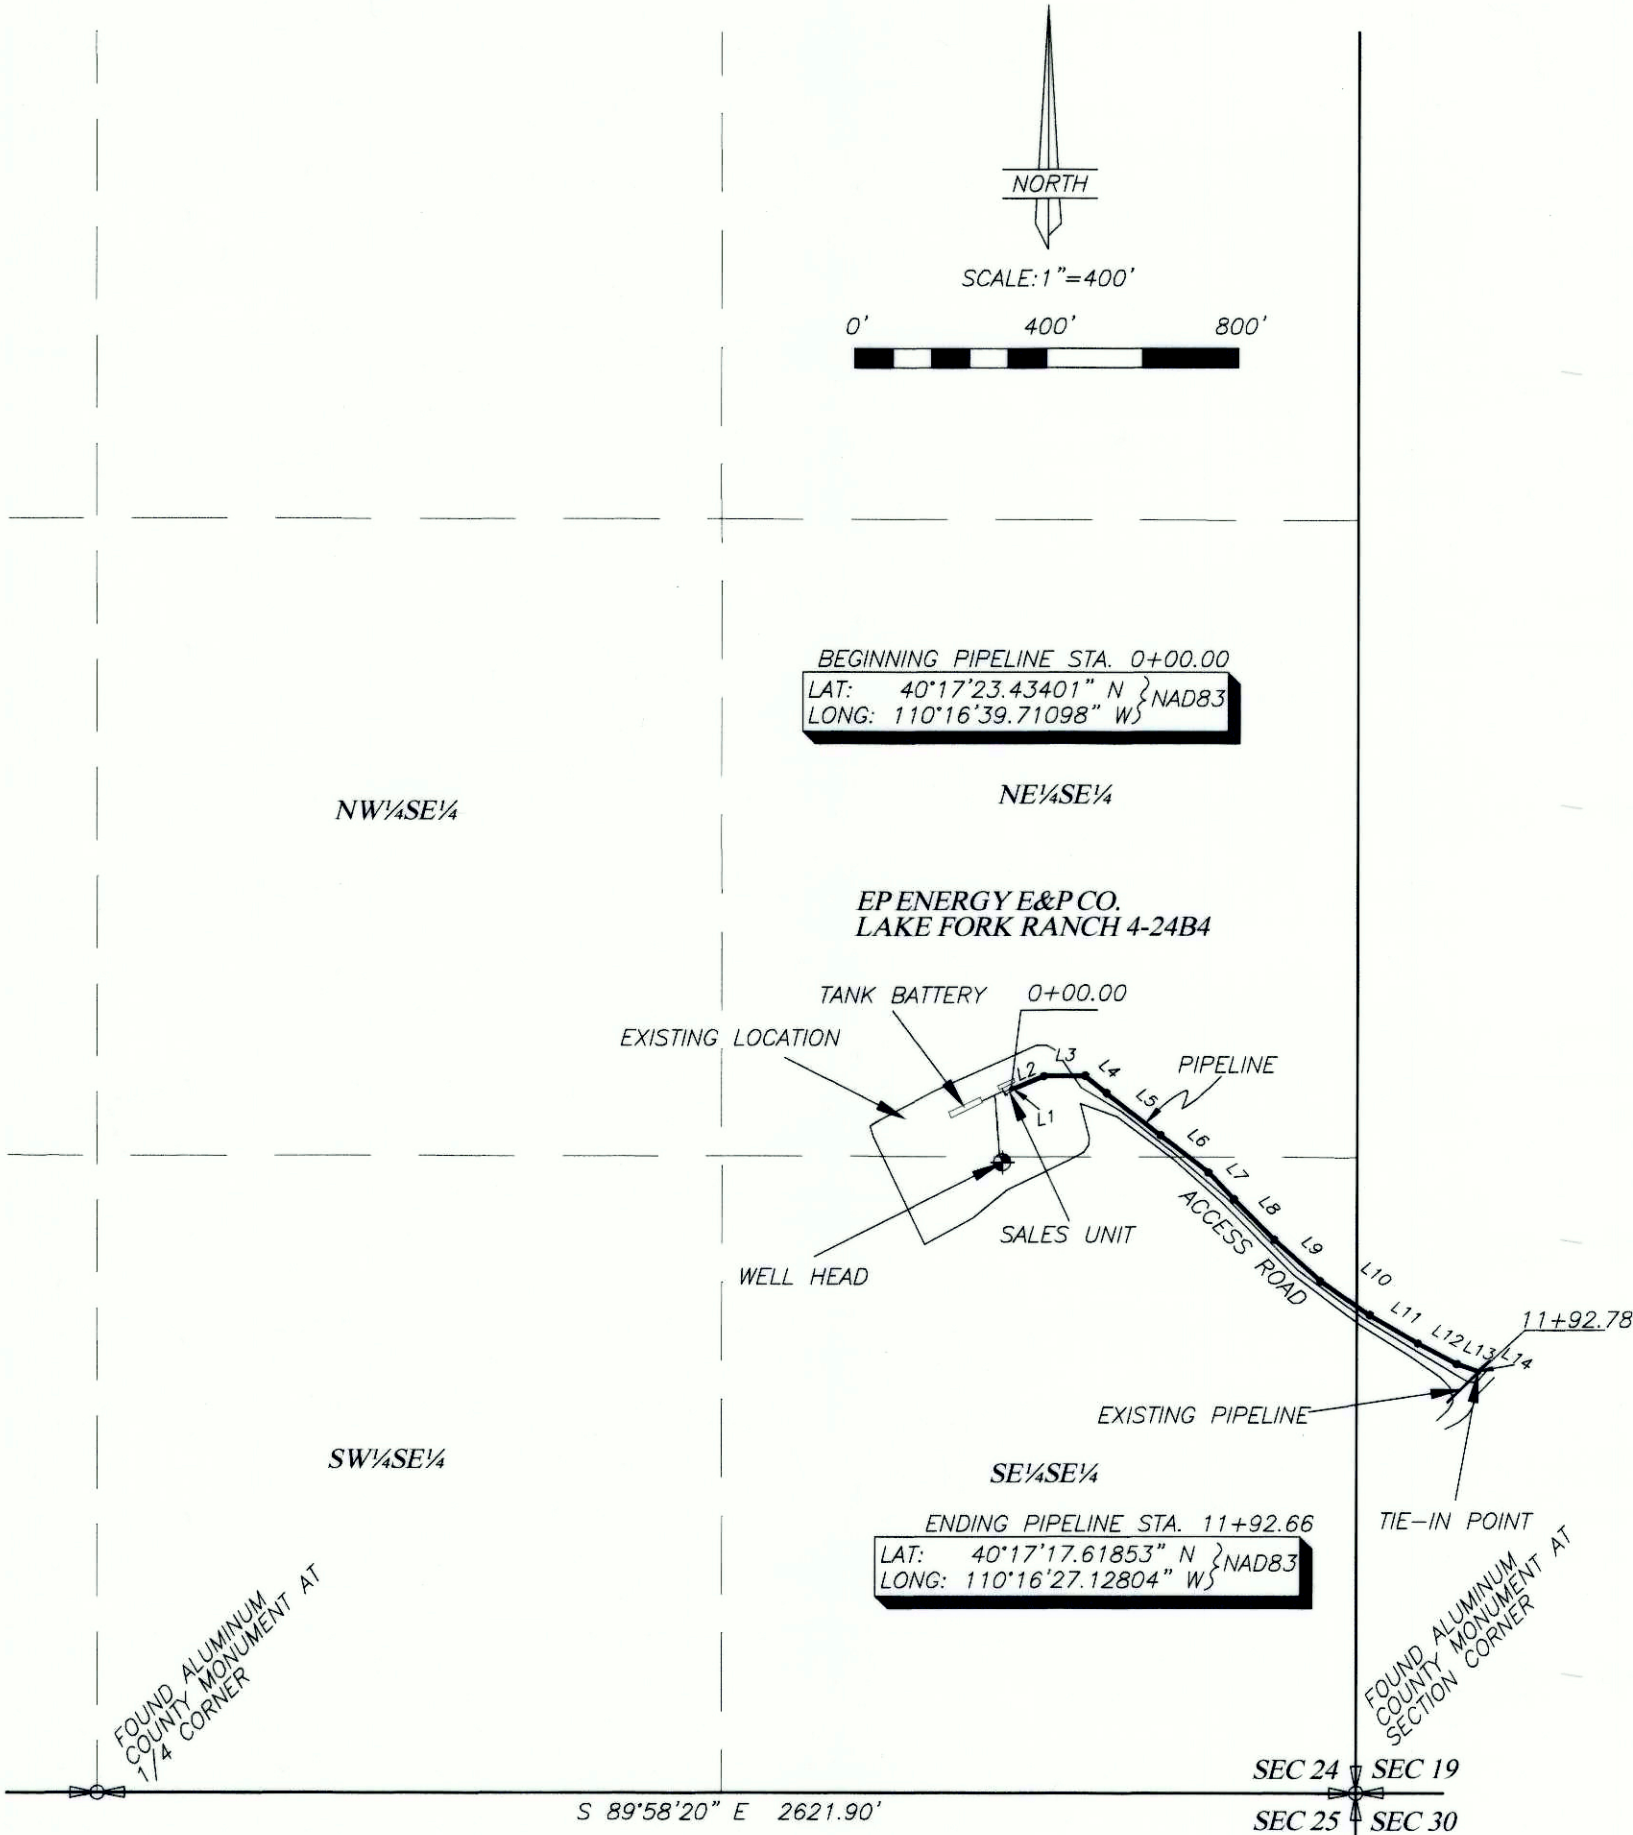

3 DEC 2013

12-121-092