



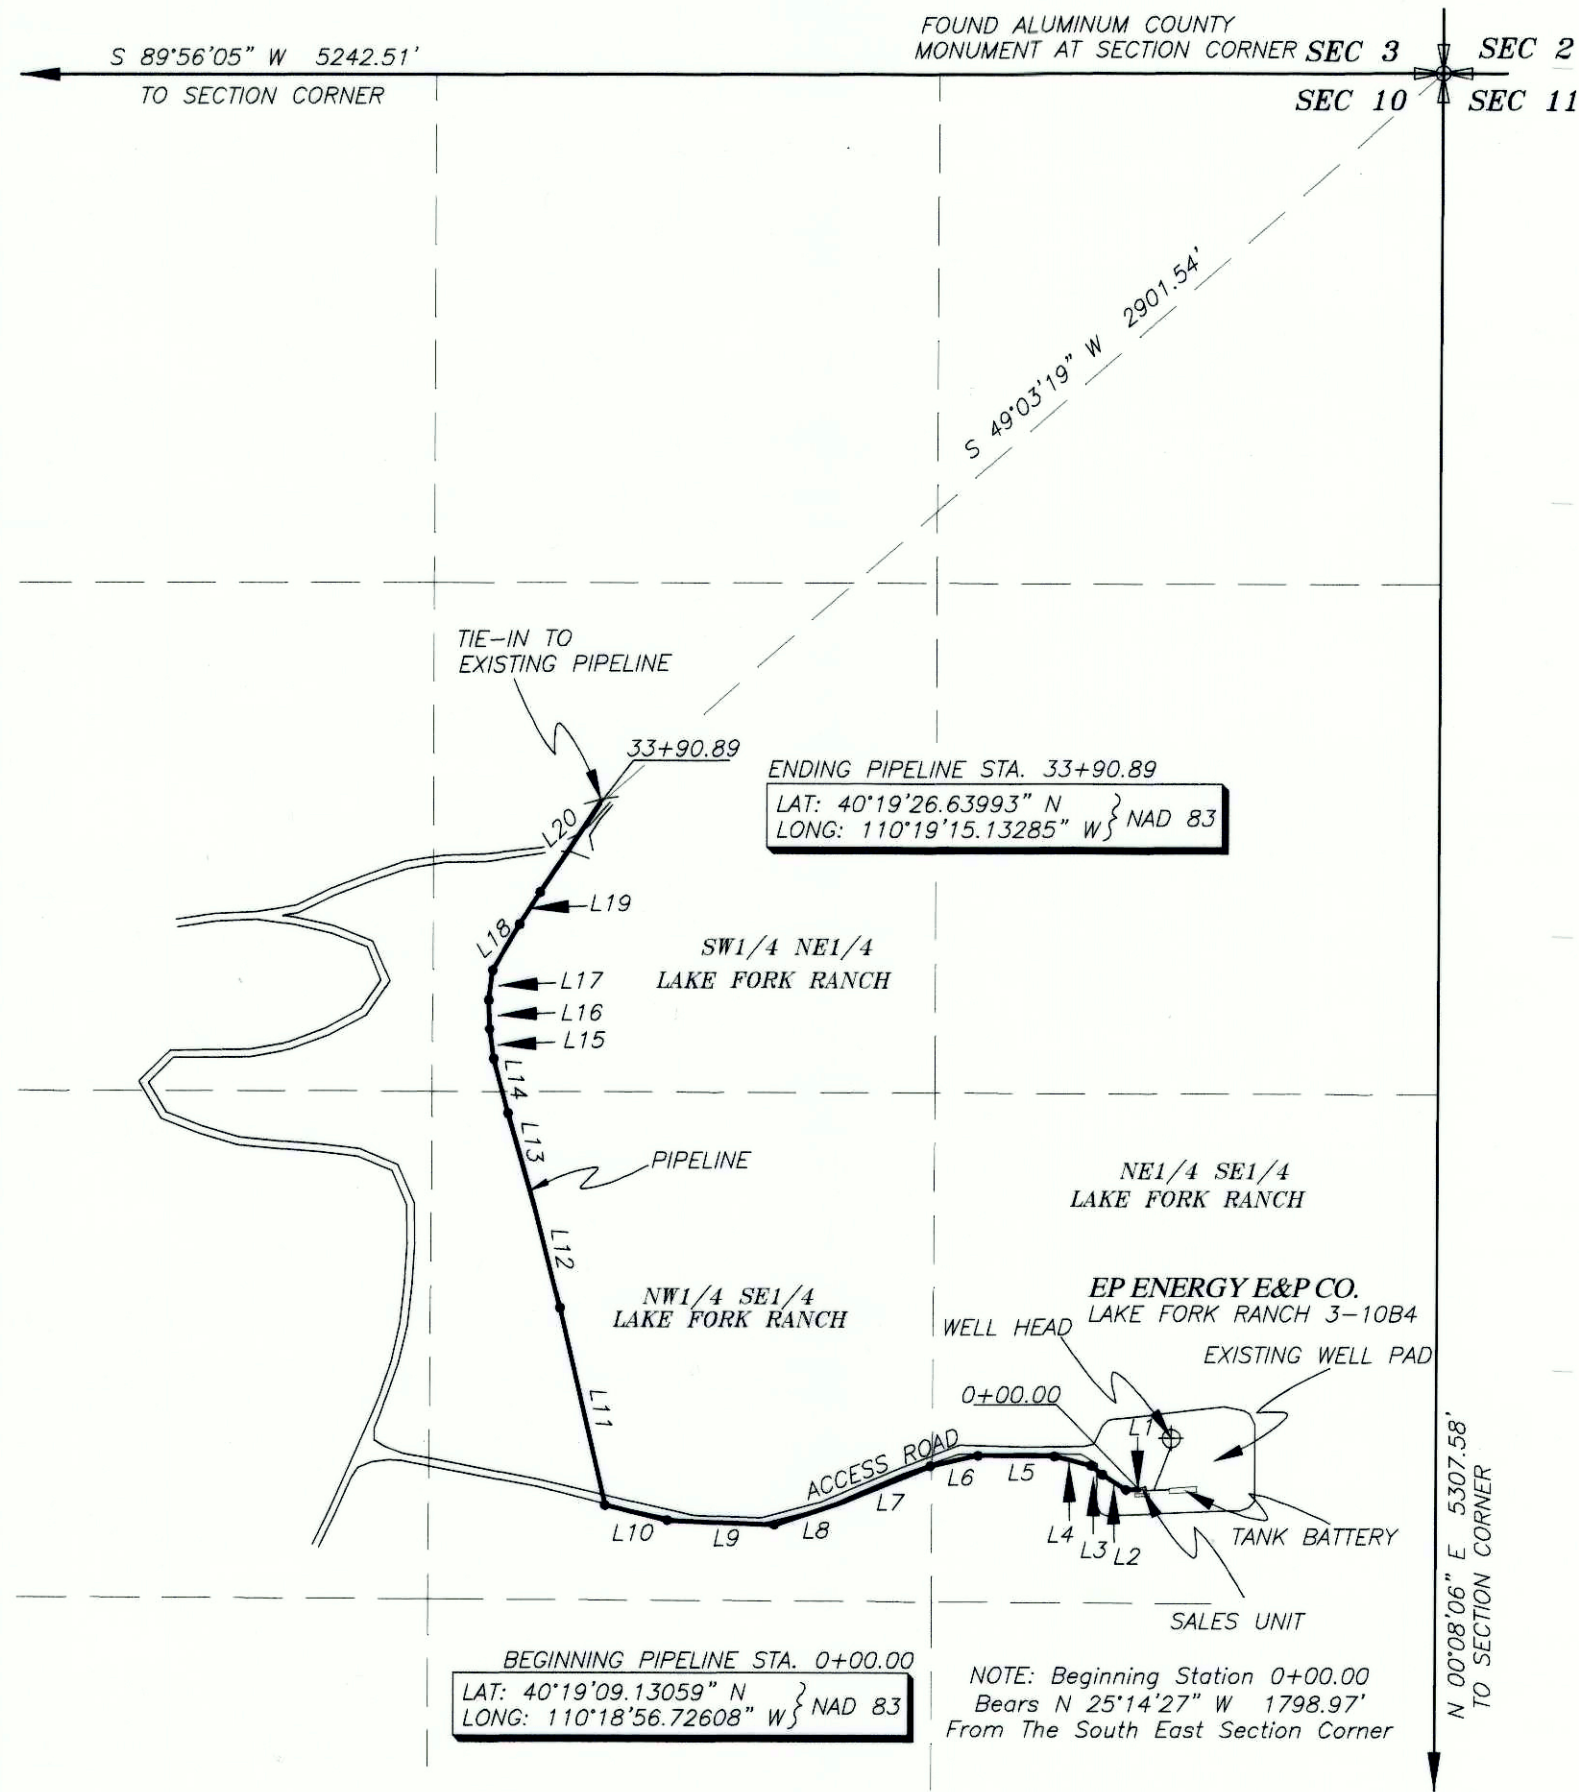

PIPELINE AS-BUILT SURVEY FOR
KINDER MORGAN ALTAMONT, LLC.
LAKE FORK RANCH 3-10B4
 SECTION 10, T2S, R4W, U.S.B.&M.
 DUCHESNE COUNTY, UTAH

LINE	BEARING	DISTANCE
L1	S 89°00'53" W	35.96'
L2	N 56°58'01" W	71.73'
L3	N 52°49'30" W	37.73'
L4	N 75°44'01" W	98.84'
L5	N 89°35'39" W	197.34'
L6	S 77°44'12" W	127.59'
L7	S 67°35'48" W	244.40'
L8	S 71°24'58" W	189.36'
L9	N 87°32'03" W	279.73'
L10	N 76°25'10" W	167.40'
L11	N 13°02'37" W	526.60'
L12	N 14°10'53" W	270.52'
L13	N 16°11'23" W	252.85'
L14	N 15°05'11" W	146.59'
L15	N 07°51'54" W	77.82'
L16	N 01°53'06" W	75.85'
L17	N 07°04'55" E	78.44'
L18	N 30°30'42" E	138.03'
L19	N 32°38'13" E	98.87'
L20	N 33°52'24" E	275.24'

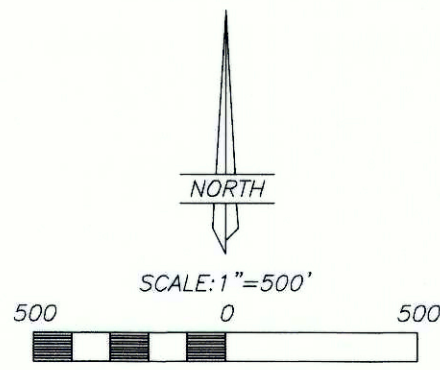


THIS SURVEY WAS PERFORMED USING GLOBAL POSITIONING SYSTEM PROCEDURES AND EQUIPMENT

THE BASIS OF BEARINGS IS GEODETIC NORTH DERIVED FROM G.P.S. OBSERVATIONS AT A SECTION CORNER LOCATED AT LAT. 40°21'33.56882"N AND LONG. 110°16'31.53266"W USING THE UTAH STATE G.P.S. VIRTUAL REFERENCE STATION CONTROL NETWORK MAINTAINED AND OPERATED BY THE AUTOMATED GEOGRAPHIC REFERENCE CENTER

SURVEYOR'S CERTIFICATE

This is to certify that this plat was prepared from the field notes and electronic data collector files of an actual survey made by me, or under my personal supervision, of the pipeline shown hereon, and that this plat accurately represents said survey to the best of my knowledge.

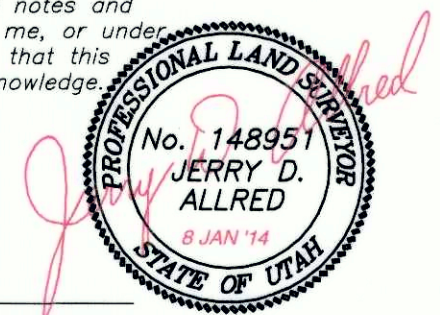

JERRY D. ALLRED, REGISTERED LAND SURVEYOR,
 CERTIFICATE NO. 148951 (UTAH)

COUNTY SURVEYOR'S FILE NUMBER 2932

JERRY D. ALLRED AND ASSOCIATES
 SURVEYING CONSULTANTS

1235 NORTH 700 EAST--P.O. BOX 975
 DUCHESNE, UTAH 84021
 (435) 738-5352