


**"AS BUILT"
RIGHT-OF-WAY SURVEY
IN SECTION 1, T2S, R4W, U.S.B.&M.
FOR
COASTAL OIL & GAS CORP./
ANR LIMITED INC.**

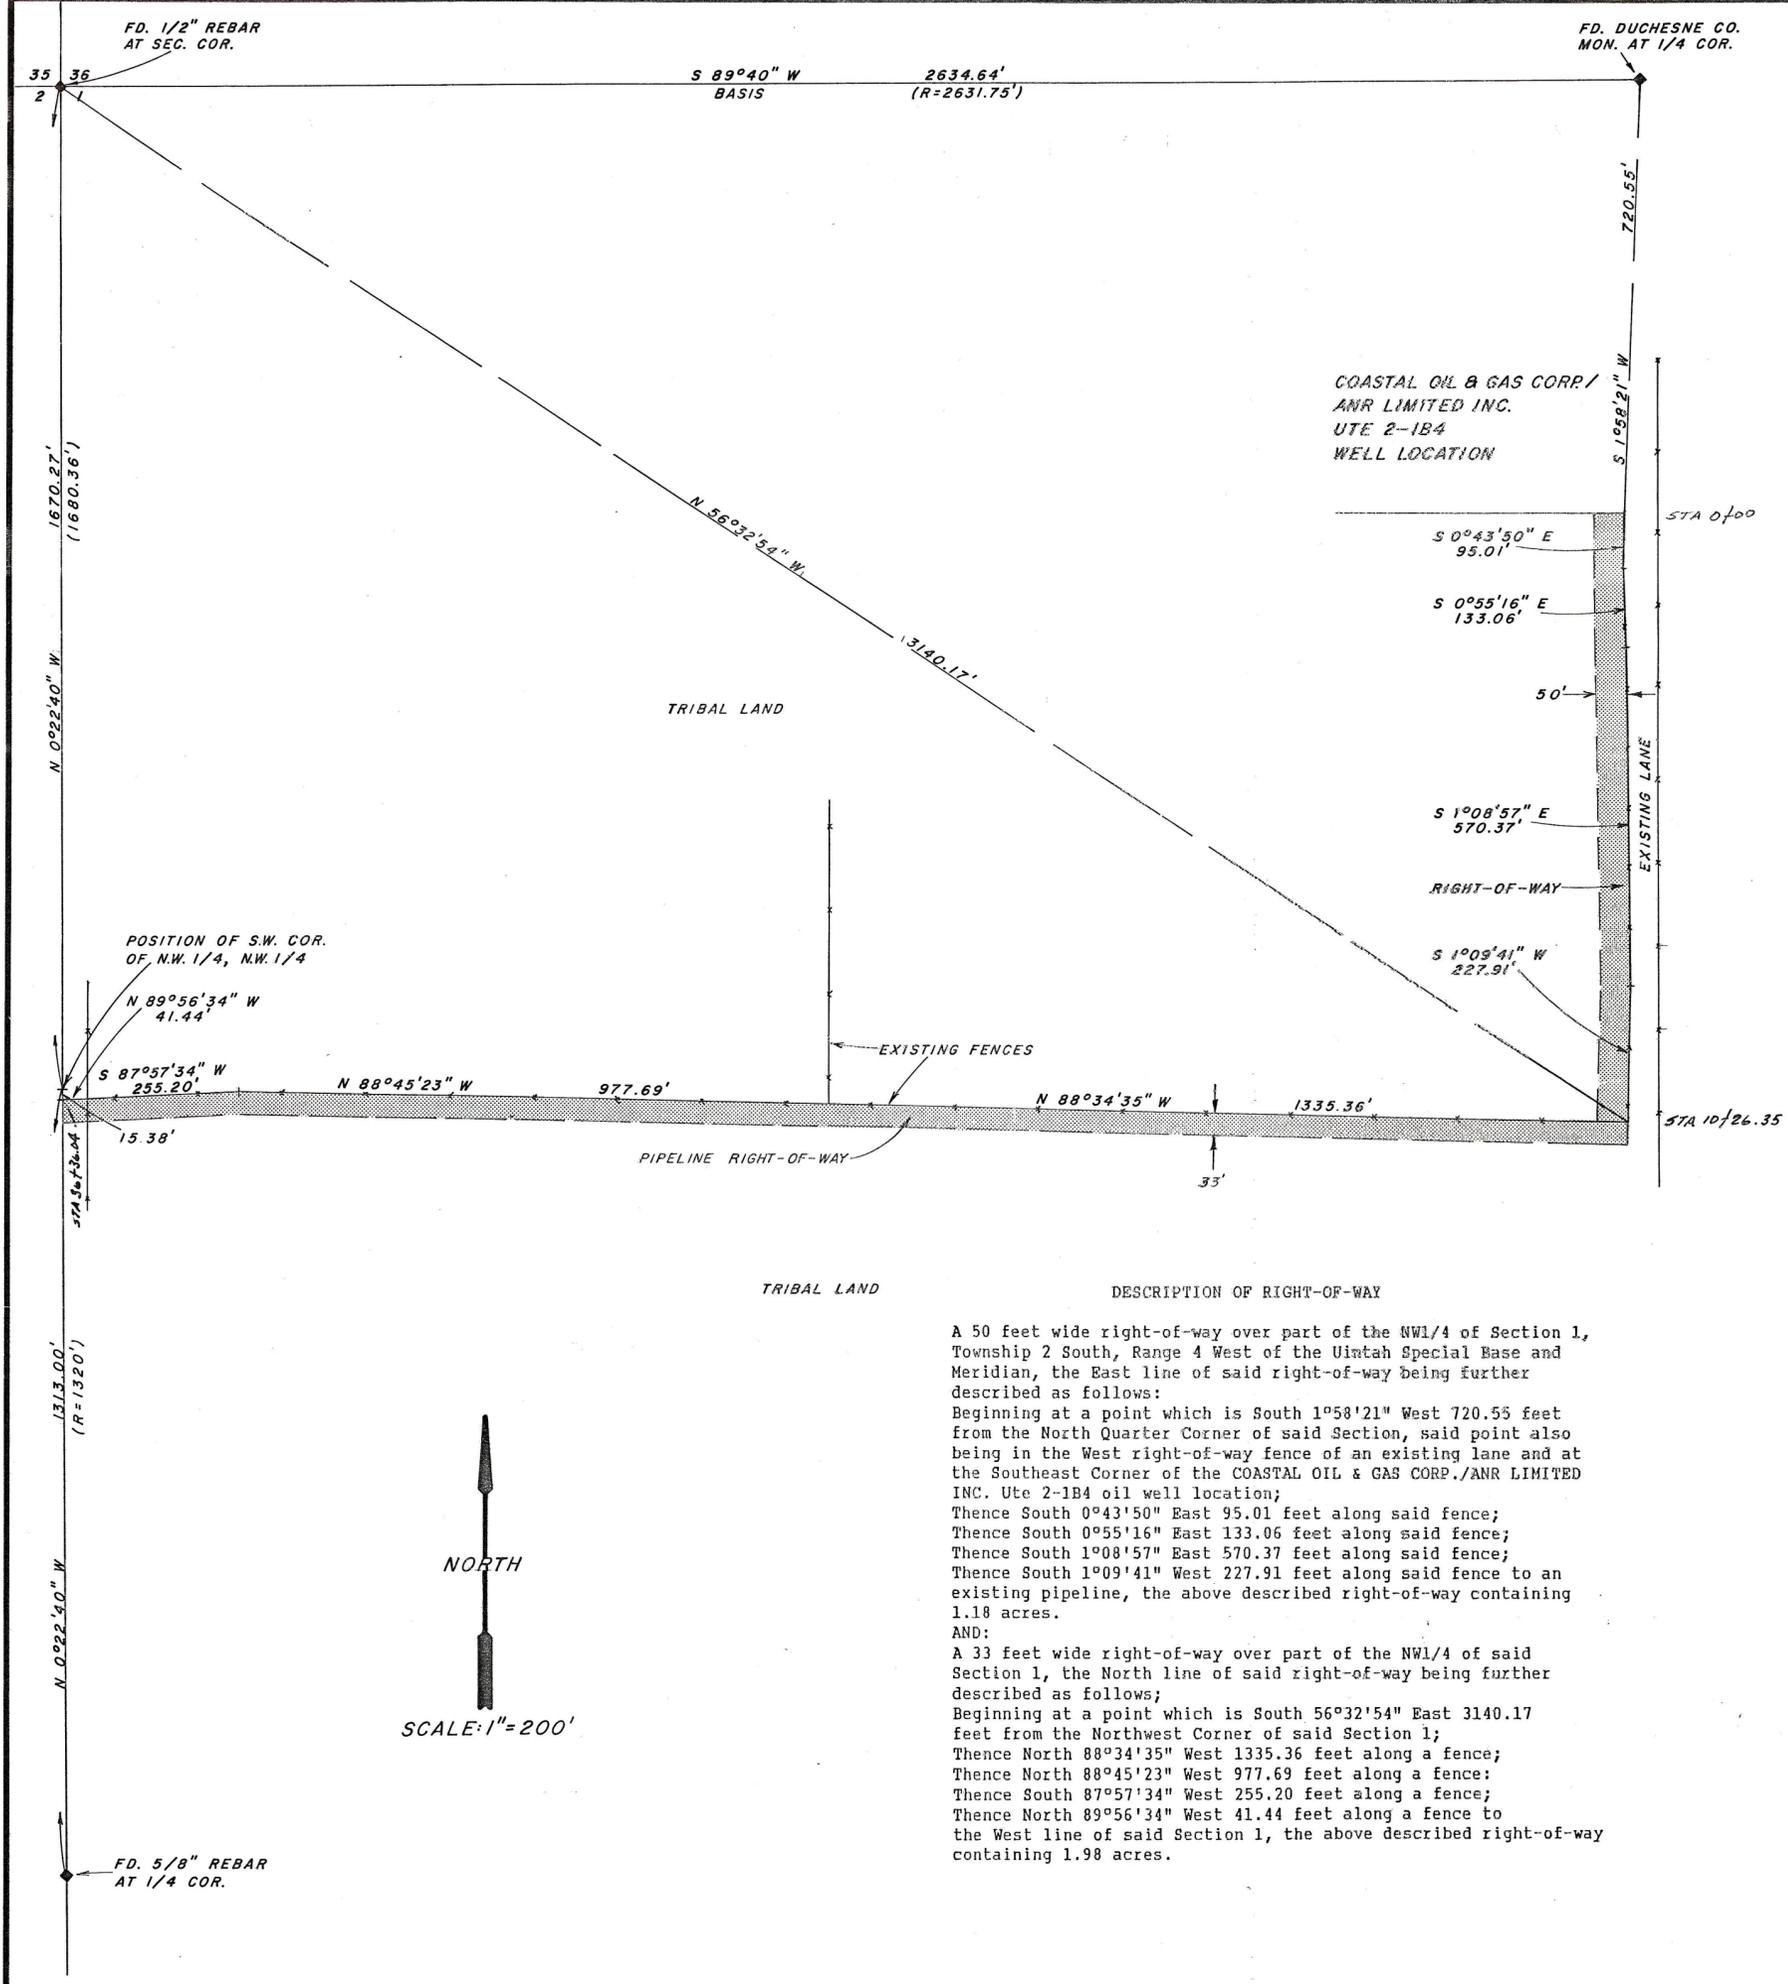

COASTAL OIL & GAS CORP./
ANR LIMITED INC.
UTE 2-1B4
WELL LOCATION

SURVEYOR'S AFFIDAVIT


STATE OF UTAH
COUNTY OF DUCHESNE

Jerry D. Allred being first duly sworn, deposes and states that he is the Registered Land Surveyor, for the COASTAL OIL & GAS CORP./ANR LTD.; that the survey was made by him (or under his direction), that he has examined the field notes of the survey for a PIPELINE right-of-way as described and shown on this plat; that this plat was prepared under his direction from said field notes; and that said right-of-way, 0.69 miles in length, beginning at STA 0+00 and ending at STA 10+26.35 is accurately located on this plat. CONTAINING 3.16 ACS.

Jerry D. Allred
Registered Land Surveyor

Subscribed and sworn to before me this 16th day of February, 1988.

Rogan K. Marrett
Notary Public.
Jan. 7, 1991
My commission expires

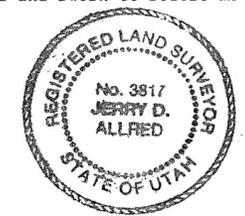


CERTIFICATION

I, _____, do hereby certify that I am the _____ for _____, hereinafter designated the "Grantee"; that Jerry D. Allred, who subscribed the foregoing affidavit, is employed by the "Grantee"; that in its construction the right-of-way does not deviate from the approved plans, notes, and maps filed _____ 198__; and that the "Grantee" has in all things complied with the requirements of the act of February 5, 1948, and applicable regulations pursuant to which the "Grantee" has been granted the right-of-way.

"Grantee"

DESCRIPTION OF RIGHT-OF-WAY

A 50 feet wide right-of-way over part of the NW1/4 of Section 1, Township 2 South, Range 4 West of the Uintah Special Base and Meridian, the East line of said right-of-way being further described as follows:
Beginning at a point which is South 1°58'21" West 720.55 feet from the North Quarter Corner of said Section, said point also being in the West right-of-way fence of an existing lane and at the Southeast Corner of the COASTAL OIL & GAS CORP./ANR LIMITED INC. Ute 2-1B4 oil well location;
Thence South 0°43'50" East 95.01 feet along said fence;
Thence South 0°55'16" East 133.06 feet along said fence;
Thence South 1°08'57" East 570.37 feet along said fence;
Thence South 1°09'41" West 227.91 feet along said fence to an existing pipeline, the above described right-of-way containing 1.18 acres.
AND:
A 33 feet wide right-of-way over part of the NW1/4 of said Section 1, the North line of said right-of-way being further described as follows:
Beginning at a point which is South 56°32'54" East 3140.17 feet from the Northwest Corner of said Section 1;
Thence North 88°34'35" West 1335.36 feet along a fence;
Thence North 88°45'23" West 977.69 feet along a fence;
Thence South 87°57'34" West 255.20 feet along a fence;
Thence North 89°56'34" West 41.44 feet along a fence to the West line of said Section 1, the above described right-of-way containing 1.98 acres.

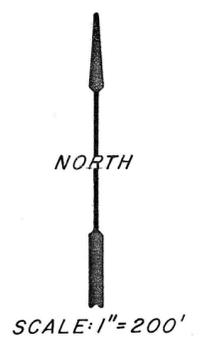

Du. Co. Sur #37 Filed 5 Jan '89

JERRY D. ALLRED & ASSOCIATES
Surveying & Engineering Consultants
121 North Center Street
P.O. Drawer C
DUCHESNE, UTAH 84021
(801) 738-5352