


EXHIBIT "A"

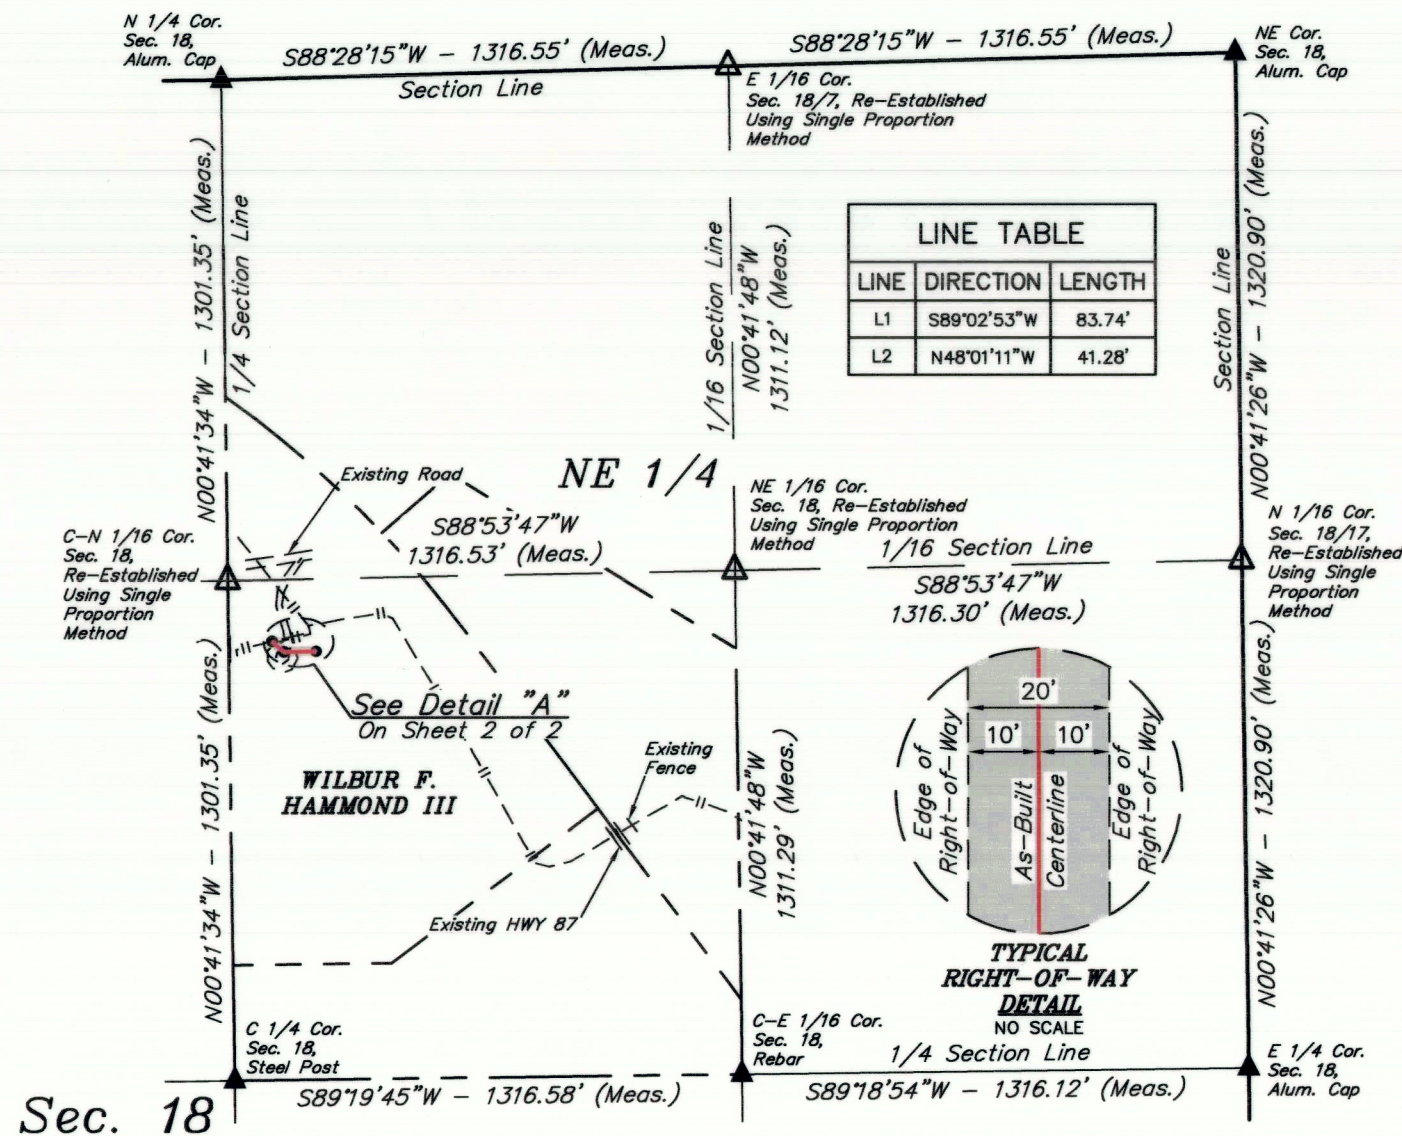

ACREAGE / LENGTH TABLE		
FEET	RODS	ACRES
125.02	7.58	0.057

▲ = SECTION CORNERS LOCATED.
 △ = SECTION CORNERS RE-ESTABLISHED.
 (Not Set on Ground.)

CERTIFICATE
 THIS IS TO CERTIFY THAT THE ABOVE PLAT WAS PREPARED FROM FIELD NOTES OF ACTUAL SURVEYS MADE BY ME OR UNDER MY SUPERVISION AND THAT THE SAME ARE TRUE AND CORRECT TO THE BEST OF MY KNOWLEDGE AND BELIEF.

Brandon R. Routhorpe
 REGISTERED LAND SURVEYOR
 REGISTRATION NO. 6631032
 STATE OF UTAH

SHEET 1 OF 2

REV: 1 09-12-22 J.I. (ALIGNMENT UPDATE)

KINDER MORGAN ALTAMONT LLC

OB 10280
 AS-BUILT POWER LINE RIGHT-OF-WAY ON
 WILBUR F. HAMMOND III LANDS
 SECTION 18, T2S, R4W, U.S.B.&M.
 DUCHESNE COUNTY, UTAH

SURVEYED BY	J.F.	08-24-22	SCALE
DRAWN BY	J.I.	08-31-22	1" = 500'
FILE:	K-2033-A1		

AS-BUILT POWER LINE RIGHT-OF-WAY




UELS, LLC
 Corporate Office * 85 South 200 East
 Vernal, UT 84078 * (435) 789-1017

EXHIBIT "A"

AS-BUILT POWER LINE RIGHT-OF-WAY DESCRIPTION

A 20' WIDE AS-BUILT RIGHT-OF-WAY 10' ON EACH SIDE OF THE FOLLOWING DESCRIBED CENTERLINE.

COMMENCING AT THE CENTER-EAST 1/16 CORNER OF SECTION 18, T2S, R4W, U.S.B.&M., THENCE N89°19'45"W 1316.58' ALONG THE SOUTH LINE OF THE SW 1/4 NE 1/4 OF SAID SECTION 18 TO THE CENTER 1/4 CORNER OF SAID SECTION 18; THENCE N10°49'40"E 1137.94' TO A POINT IN THE SW 1/4 NE 1/4 OF SAID SECTION 18 AND THE POINT OF BEGINNING; THENCE S89°02'53"W 83.74'; THENCE N48°01'11"W 41.28' TO A POINT IN THE SW 1/4 NE 1/4 OF SAID SECTION 18 AND THE POINT OF TERMINATION, WHICH BEARS N04°57'52"E 1148.21' FROM THE CENTER 1/4 CORNER OF SAID SECTION 18. THE SIDE LINES OF SAID DESCRIBED RIGHT-OF-WAY BEING SHORTENED OR ELONGATED TO MEET THE GRANTOR'S PROPERTY LINES. CONTAINS 0.057 ACRES MORE OR LESS.

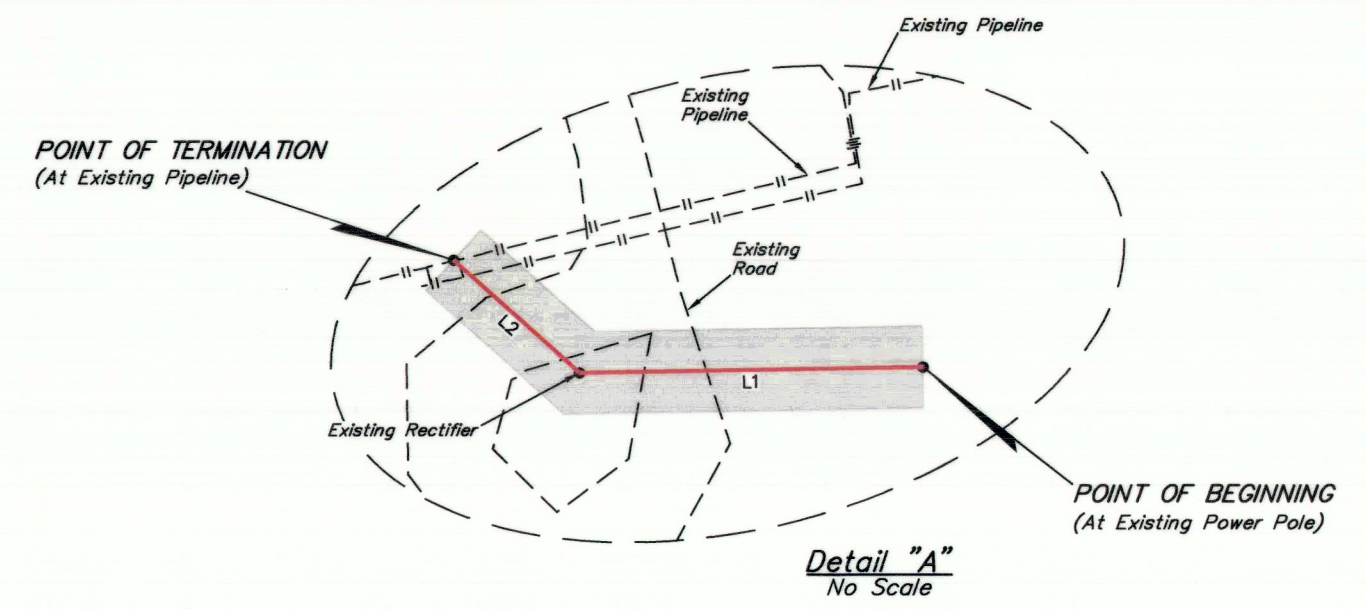

POINT OF BEGINNING BEARS N10°49'40"E 1137.94' FROM THE CENTER 1/4 CORNER OF SECTION 18, T2S, R4W, U.S.B.&M.

POINT OF TERMINATION BEARS N04°57'52"E 1148.21' FROM THE CENTER 1/4 CORNER OF SECTION 18, T2S, R4W, U.S.B.&M.

NOTES:

- Basis of Bearings are GRID bearings based on Utah State Plane Coordinate System, Central Zone, NAD83.
- Distances shown are GRID distances. To obtain ground distances multiply by the combination scale factor of 1.000375706.
- Vertical Datum is NAVD 88. Based on elevation derived from the OPUS.

CERTIFICATE
 THIS IS TO CERTIFY THAT THE ABOVE PLAT WAS PREPARED FROM FIELD NOTES OF ACTUAL SURVEYS MADE BY ME OR UNDER MY SUPERVISION AND THAT THE SAME ARE TRUE AND CORRECT TO THE BEST OF MY KNOWLEDGE AND BELIEF.

Brandon R. Routhorpe
 REGISTERED LAND SURVEYOR
 REGISTRATION NO. 6631032
 STATE OF UTAH

SHEET 2 OF 2

REV: 1 09-12-22 J.I. (ALIGNMENT UPDATE)

KINDER MORGAN ALTAMONT LLC

OB 10280
 AS-BUILT POWER LINE RIGHT-OF-WAY ON
 WILBUR F. HAMMOND III LANDS
 SECTION 18, T2S, R4W, U.S.B.&M.
 DUCHESNE COUNTY, UTAH

SURVEYED BY	J.F.	08-24-22	SCALE
DRAWN BY	J.I.	08-31-22	N/A
FILE:	K-2033-A2		

AS-BUILT POWER LINE RIGHT-OF-WAY



UELS, LLC
 Corporate Office * 85 South 200 East
 Vernal, UT 84078 * (435) 789-1017

County Surveyor's File # 5320