



EXHIBIT "A"

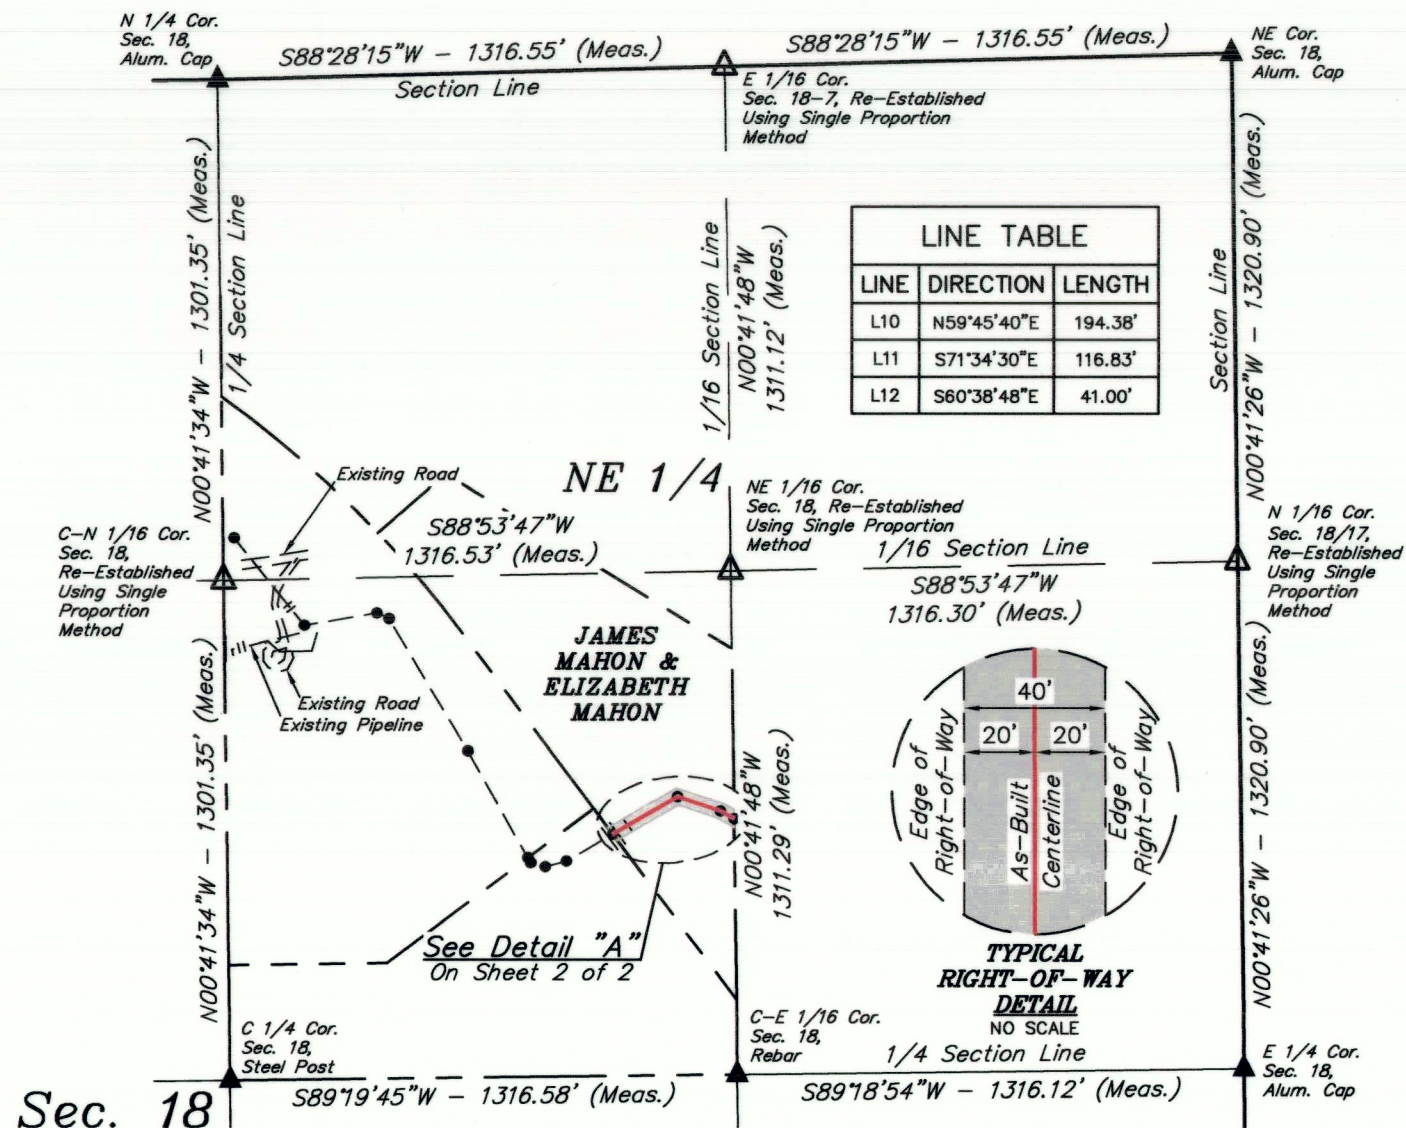

LINE TABLE		
LINE	DIRECTION	LENGTH
L10	N59°45'40"E	194.38'
L11	S71°34'30"E	116.83'
L12	S60°38'48"E	41.00'

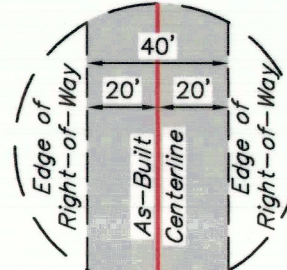


TYPICAL
RIGHT-OF-WAY
DETAIL
NO SCALE



ACREAGE / LENGTH TABLE		
FEET	RODS	ACRES
352.21	21.35	0.323

- ▲ = SECTION CORNERS LOCATED.
- △ = SECTION CORNERS RE-ESTABLISHED.
(Not Set on Ground.)

CERTIFICATE
THIS IS TO CERTIFY THAT THE ABOVE PLAT WAS PREPARED FROM FIELD
NOTES OF ACTUAL SURVEYS MADE BY ME OR UNDER MY SUPERVISION
AND THAT THE SAME ARE TRUE AND CORRECT TO THE BEST OF MY
KNOWLEDGE AND BELIEF.

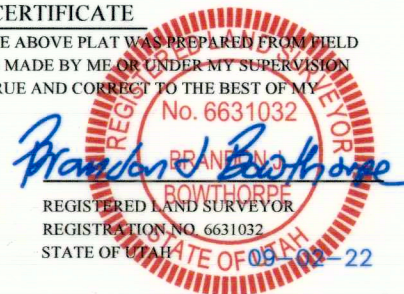

SHEET 1 OF 2

KINDER MORGAN ALTAMONT LLC

OB 10280
AS-BUILT PIPELINE RIGHT-OF-WAY ON
JAMES MAHON & ELIZABETH MAHON LANDS
SECTION 18, T2S, R4W, U.S.B.&M.
DUCESNE COUNTY, UTAH

SURVEYED BY	J.F.	08-24-22	SCALE
DRAWN BY	J.I.	08-31-22	1" = 500'
FILE:	K-2033-C1		

AS-BUILT PIPELINE RIGHT-OF-WAY




UELS, LLC
Corporate Office * 85 South 200 East
Vernal, UT 84078 * (435) 789-1017

EXHIBIT "A"

AS-BUILT PIPELINE RIGHT-OF-WAY DESCRIPTION

A 40' WIDE AS-BUILT RIGHT-OF-WAY 20' ON EACH SIDE OF THE FOLLOWING DESCRIBED CENTERLINE.

COMMENCING AT THE CENTER 1/4 CORNER OF SECTION 18, T2S, R4W, U.S.B.&M., THENCE N89°19'45"E 1316.58' ALONG THE SOUTH LINE OF THE SW 1/4 NE 1/4 OF SAID SECTION 18 TO THE CENTER-EAST 1/16 CORNER OF SAID SECTION 18; THENCE N27°17'33"W 703.58' TO A POINT IN THE SW 1/4 NE 1/4 OF SAID SECTION 18 AND THE POINT OF BEGINNING; THENCE N59°45'40"E 194.38'; THENCE S71°34'30"E 116.83'; THENCE S60°38'48"E 41.00' TO A POINT ON THE EAST LINE OF THE SW 1/4 NE 1/4 OF SAID SECTION 18 AND THE POINT OF TERMINATION, WHICH BEARS N00°41'48"W 666.17' FROM THE CENTER-EAST 1/16 CORNER OF SAID SECTION 18. THE SIDE LINES OF SAID DESCRIBED RIGHT-OF-WAY BEING SHORTENED OR ELONGATED TO MEET THE GRANTOR'S PROPERTY LINES. CONTAINS 0.323 ACRES MORE OR LESS.

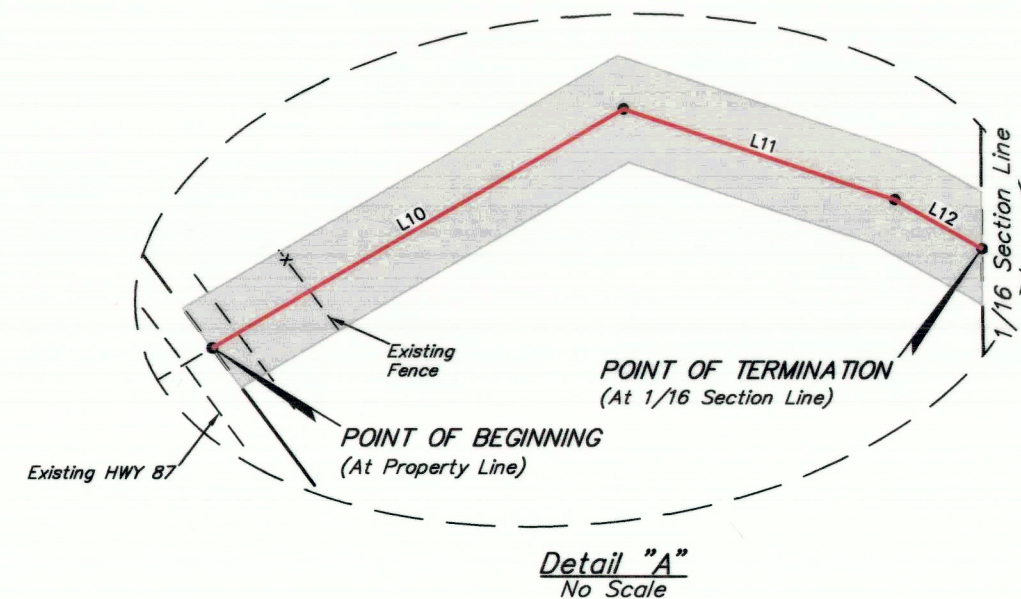


POINT OF BEGINNING BEARS N27°17'33"W
703.58' FROM THE CENTER-EAST 1/16
CORNER OF SECTION 18, T2S, R4W, U.S.B.&M.

POINT OF TERMINATION BEARS N00°41'48"W
666.17' FROM THE CENTER-EAST 1/16
CORNER OF SECTION 18, T2S, R4W, U.S.B.&M.

NOTES:

- Basis of Bearings are GRID bearings based on Utah State Plane Coordinate System, Central Zone, NAD83.
- Distances shown are GRID distances. To obtain ground distances multiply by the combination scale factor of 1.000375706.
- Vertical Datum is NAVD 88. Based on elevation derived from the OPUS.

CERTIFICATE
THIS IS TO CERTIFY THAT THE ABOVE PLAT WAS PREPARED FROM FIELD
NOTES OF ACTUAL SURVEYS MADE BY ME OR UNDER MY SUPERVISION
AND THAT THE SAME ARE TRUE AND CORRECT TO THE BEST OF MY
KNOWLEDGE AND BELIEF.

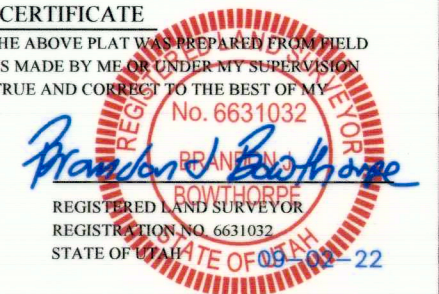

SHEET 2 OF 2

KINDER MORGAN ALTAMONT LLC

OB 10280
AS-BUILT PIPELINE RIGHT-OF-WAY ON
JAMES MAHON & ELIZABETH MAHON LANDS
SECTION 18, T2S, R4W, U.S.B.&M.
DUCESNE COUNTY, UTAH

SURVEYED BY	J.F.	08-24-22	SCALE
DRAWN BY	J.I.	08-31-22	N/A
FILE:	K-2033-C2		

AS-BUILT PIPELINE RIGHT-OF-WAY



UELS, LLC
Corporate Office * 85 South 200 East
Vernal, UT 84078 * (435) 789-1017

County Surveyor's File # 5322