
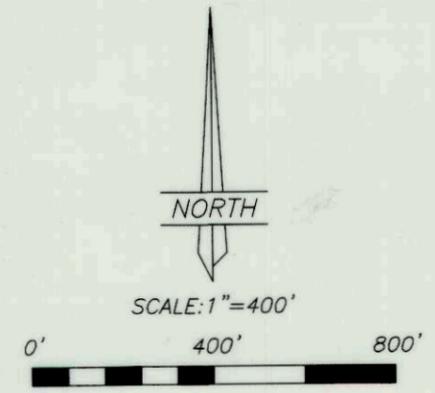
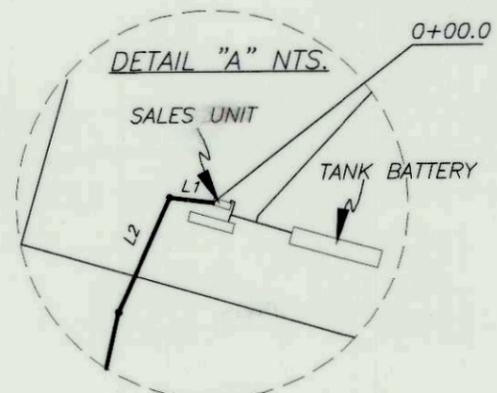



PIPELINE AS-BUILT SURVEY FOR
KINDER MORGAN ALTAMONT, LLC.
OCAMPO 4-9C4
 SECTION 8 & 9 T3S, R4W, U.S.B.&M.
 DUCHESNE COUNTY, UTAH

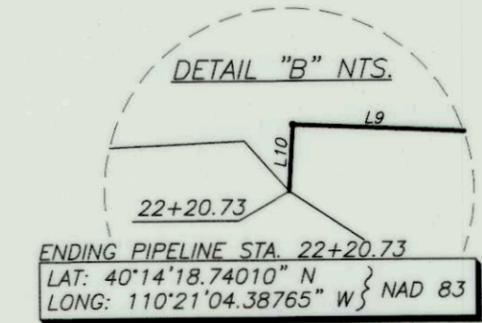

BEGINNING PIPELINE STA. 0+00.0
 LAT: 40°14'23.50253" N
 LONG: 110°20'39.86573" W } NAD 83

SURVEYOR'S CERTIFICATE

This is to certify that this plat was prepared from the field notes and electronic data collector files of an actual survey made by me, or under my personal supervision, of the pipeline shown hereon, and that this plat accurately represents said survey to the best of my knowledge.

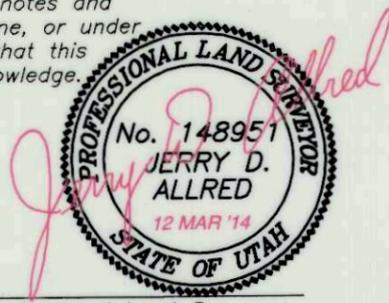


Jerry D. Allred, Professional Land Surveyor,
 Certificate 148951 (Utah)

THIS SURVEY WAS PERFORMED USING GLOBAL POSITIONING SYSTEM PROCEDURES AND EQUIPMENT
 THE BASIS OF BEARINGS IS GEODETIC NORTH DERIVED FROM G.P.S. OBSERVATIONS AT THE SECTION CORNER LOCATED AT LAT. 40°15'22.90258"N AND LONG. 110°23'21.19760"W USING THE UTAH STATE G.P.S. VIRTUAL REFERENCE STATION CONTROL NETWORK MAINTAINED AND OPERATED BY THE AUTOMATED GEOGRAPHIC REFERENCE CENTER

County Surveyor's File # 2947



LINE	BEARING	DISTANCE
L1	N 83°03'33" W	33.51'
L2	S 24°14'11" W	96.43'
L3	S 13°05'37" W	302.32'
L4	S 51°01'37" W	31.59'
L5	S 70°02'52" W	188.05'
L6	S 88°21'16" W	225.02'
L7	S 89°35'37" W	832.58'
L8	S 89°43'40" W	425.25'
L9	N 87°17'10" W	76.16'
L10	S 03°17'57" W	9.82'

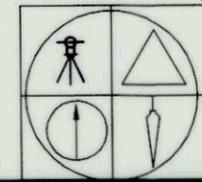

JERRY D. ALLRED AND ASSOCIATES
 SURVEYING CONSULTANTS

1235 NORTH 700 EAST--P.O. BOX 975
 DUCHESNE, UTAH 84021
 (435) 738-5352

PIPELINE "AS-BUILT" SURVEY FOR
KINDER MORGAN ALTAMONT, LLC.
ASKEW 1-19C4
 SECTION 19, T3S, R4W, U.S.B.&M.
 DUCHESNE COUNTY, UTAH

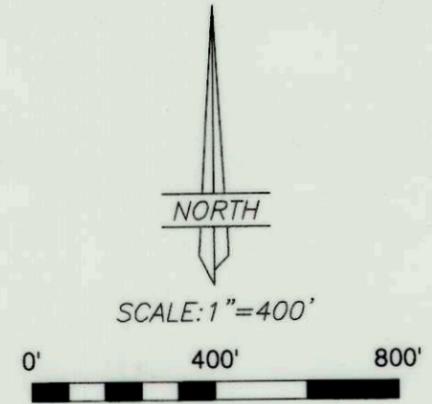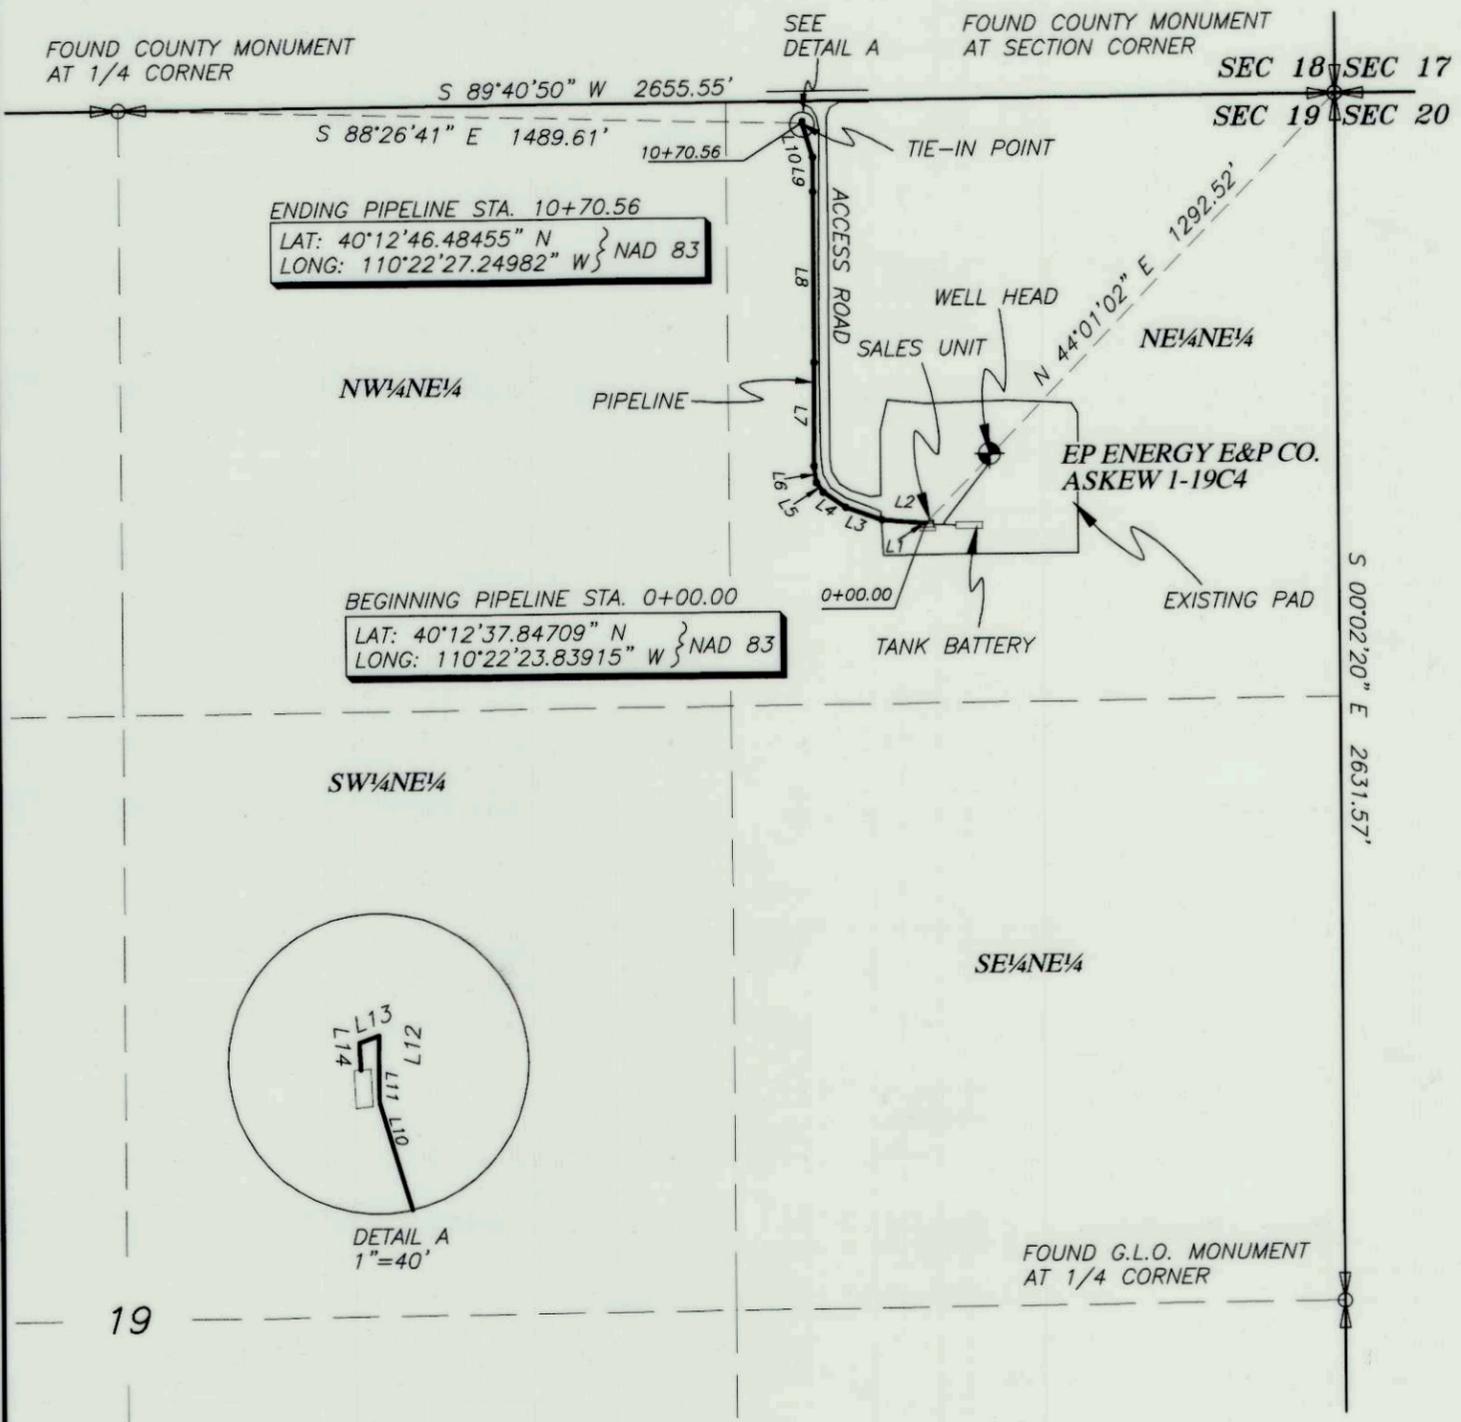

LINE	BEARING	DISTANCE
L1	N 89°45'52" W	7.79'
L2	N 84°58'04" W	88.62'
L3	N 70°23'45" W	84.19'
L4	N 55°47'34" W	59.39'
L5	N 34°12'50" W	25.96'
L6	N 06°41'46" W	35.50'
L7	N 00°25'42" E	225.95'
L8	N 00°05'29" E	372.61'
L9	N 00°05'29" E	75.33'
L10	N 16°41'18" W	70.11'
L11	N 00°22'47" W	8.45'
L12	N 01°30'55" E	6.13'
L13	S 69°38'01" W	4.63'
L14	S 03°29'06" E	5.91'

THIS SURVEY WAS PERFORMED USING GLOBAL POSITIONING SYSTEM PROCEDURES AND EQUIPMENT

THE BASIS OF BEARINGS IS GEODETIC NORTH DERIVED FROM G.P.S. OBSERVATIONS AT THE SECTION CORNER LOCATED AT LAT. 40°15'22.90258"N AND LONG. 110°23'21.19760"W USING THE UTAH STATE G.P.S. VIRTUAL REFERENCE STATION CONTROL NETWORK MAINTAINED AND OPERATED BY THE AUTOMATED GEOGRAPHIC REFERENCE CENTER


SURVEYOR'S CERTIFICATE

This is to certify that this plat was prepared from the field notes and electronic data collector files of an actual survey made by me, or under my personal supervision, of the pipeline shown hereon, and that this plat accurately represents said survey to the best of my knowledge.



Jerry D. Allred, Professional Land Surveyor,
 Certificate 148951 (Utah)

County Surveyor's File #2947

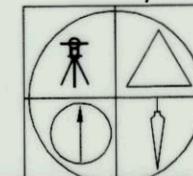


JERRY D. ALLRED AND ASSOCIATES
 SURVEYING CONSULTANTS

1235 NORTH 700 EAST--P.O. BOX 975
 DUCHESNE, UTAH 84021
 (435) 738-5352

10 MAR 2014 12-121-163

PIPELINE "AS-BUILT" SURVEY FOR
KINDER MORGAN ALTAMONT, LLC.
YOUNG 4-6C4
 SECTION 6, T3S, R4W, U.S.B.&M.
 DUCHESNE COUNTY, UTAH

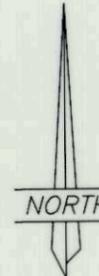

SCALE: 1"=400'




LINE	BEARING	DISTANCE
L1	S 62°56'26" E	73.17'
L2	S 88°04'27" E	211.06'
L3	N 89°29'24" E	208.57'
L4	S 88°22'15" E	130.95'
L5	S 35°56'05" E	48.89'
L6	S 05°05'38" E	14.72'
L7	S 01°53'43" E	23.34'
L8	S 00°04'27" E	273.19'
L9	S 01°21'19" E	234.01'
L10	S 17°52'57" E	34.80'
L11	S 65°24'50" E	50.85'
L12	S 84°25'50" E	3.47'

THIS SURVEY WAS PERFORMED USING GLOBAL POSITIONING SYSTEM PROCEDURES AND EQUIPMENT

THE BASIS OF BEARINGS IS GEODETIC NORTH DERIVED FROM G.P.S. OBSERVATIONS AT THE SECTION CORNER LOCATED AT LAT. 40°15'22.90258"N AND LONG. 110°23'21.19760"W USING THE UTAH STATE G.P.S. VIRTUAL REFERENCE STATION CONTROL NETWORK MAINTAINED AND OPERATED BY THE AUTOMATED GEOGRAPHIC REFERENCE CENTER

SURVEYOR'S CERTIFICATE

This is to certify that this plat was prepared from the field notes and electronic data collector files of an actual survey made by me, or under my personal supervision, of the pipeline shown hereon, and that the monuments indicated were found or set during said survey, and that this plat accurately represents said survey to the best of my knowledge.

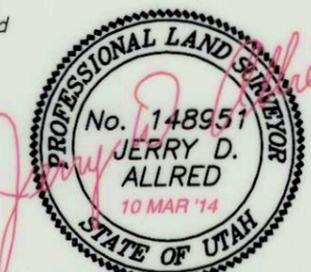

Jerry D. Allred, Professional Land Surveyor,
 Certificate 148951 (Utah)

County Surveyor's File #2947

JERRY D. ALLRED AND ASSOCIATES
 SURVEYING CONSULTANTS
 1235 NORTH 700 EAST--P.O. BOX 975
 DUCHESNE, UTAH 84021
 (435) 738-5352

10 MAR 2014 12-121-161

