



LINE	BEARING	DISTANCE
L1	S 88°23'15" E	40.05'
L2	N 80°46'38" E	63.75'
L3	S 88°15'41" E	22.64'
L4	S 64°09'43" E	20.93'
L5	S 51°10'56" E	29.44'
L6	S 49°50'09" E	89.84'
L7	S 54°30'12" E	29.14'
L8	S 73°01'41" E	20.31'
L9	N 85°30'47" E	62.05'
L10	N 83°00'58" E	39.11'
L11	N 86°54'53" E	8.23'
L12	S 05°34'39" W	4.28'

PIPELINE "AS-BUILT" SURVEY FOR
KINDER MORGAN ALTAMONT, LLC.
HISLOP 3-8C4
 SECTION 8, T3S, R4W, U.S.B.&M.
 DUCHESNE COUNTY, UTAH

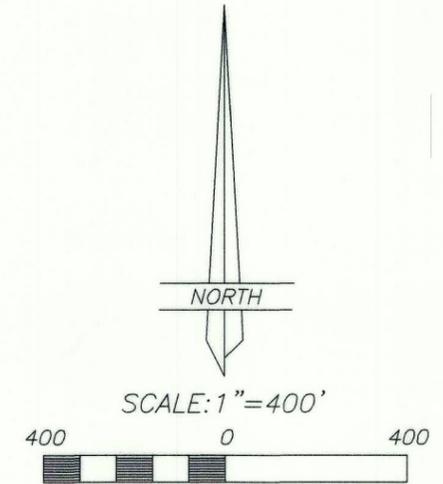

SURVEYOR'S CERTIFICATE


This is to certify that this plat was prepared from the field notes and electronic data collector files of an actual survey made by me, or under my personal supervision, of the pipeline shown hereon, and that this plat accurately represents said survey to the best of my knowledge.

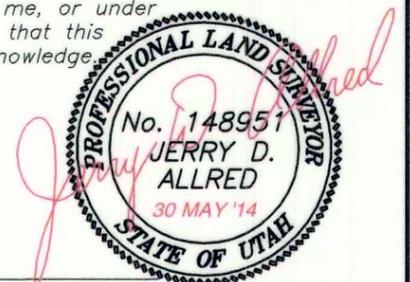

JERRY D. ALLRED, REGISTERED LAND SURVEYOR,
 CERTIFICATE NO. 148951 (UTAH)

THIS SURVEY WAS PERFORMED USING GLOBAL POSITIONING SYSTEM PROCEDURES AND EQUIPMENT


THE BASIS OF BEARINGS IS GEODETIC NORTH DERIVED FROM G.P.S. OBSERVATIONS AT THE SECTION CORNER LOCATED AT LAT. 40°15'22.90258"N AND LONG. 110°23'21.19760"W USING THE UTAH STATE G.P.S. VIRTUAL REFERENCE STATION CONTROL NETWORK MAINTAINED AND OPERATED BY THE AUTOMATED GEOGRAPHIC REFERENCE CENTER

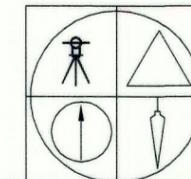

JERRY D. ALLRED AND ASSOCIATES
 SURVEYING CONSULTANTS

1235 NORTH 700 EAST--P.O. BOX 975
 DUCHESNE, UTAH 84021
 (435) 738-5352

30 MAY 2014 12-121-187

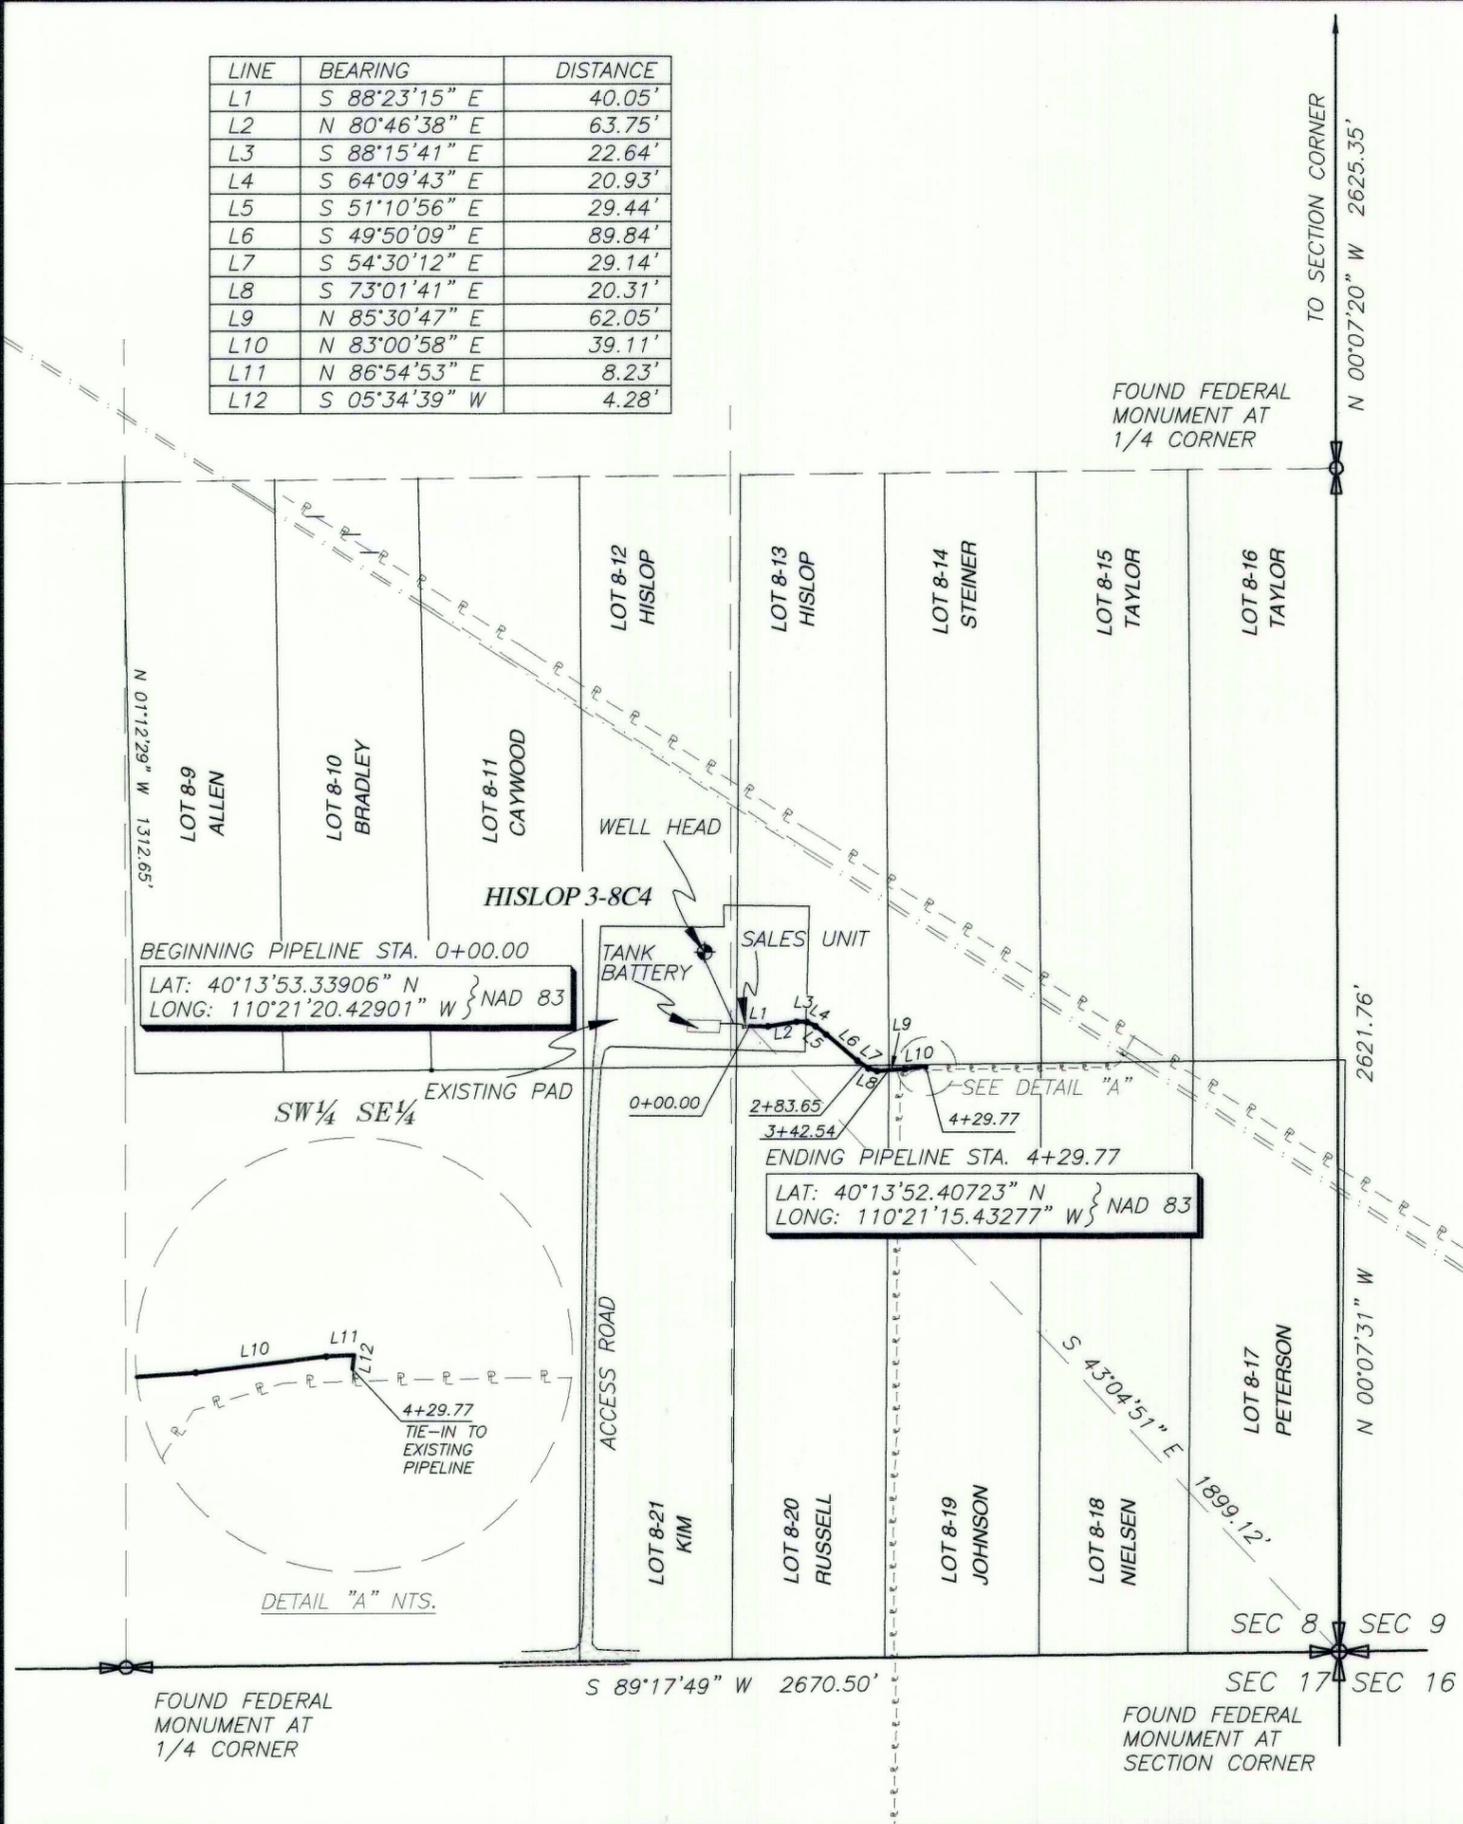

BEGINNING PIPELINE STA. 0+00.00
 LAT: 40°13'53.33906" N
 LONG: 110°21'20.42901" W } NAD 83

ENDING PIPELINE STA. 4+29.77
 LAT: 40°13'52.40723" N
 LONG: 110°21'15.43277" W } NAD 83

DETAIL "A" NTS.

FOUND FEDERAL MONUMENT AT 1/4 CORNER

FOUND FEDERAL MONUMENT AT 1/4 CORNER

FOUND FEDERAL MONUMENT AT SECTION CORNER

TO SECTION CORNER
 N 00°07'20" W 2625.35'

2621.76'

N 00°07'31" W

SEC 8 SEC 9

SEC 17 SEC 16

S 89°17'49" W 2670.50'

S 43°04'51" E 1899.12'


PIPELINE "AS-BUILT" SURVEY
KINDER MORGAN ALTAMONT, LLC.
DUCHESNE COUNTY 4-5C4

SECTIONS 4, 5, 8, AND 9, TOWNSHIP 3 SOUTH, RANGE 4 WEST
 UTAH SPECIAL BASE AND MERIDIAN

LINE	BEARING	DISTANCE	LINE	BEARING	DISTANCE
L1	S 85°47'24" E	23.02'	L15	S 26°59'52" E	7.64'
L2	S 79°25'27" E	41.65'	L16	S 00°05'33" E	251.37'
L3	S 68°23'20" E	83.14'	L17	S 00°35'55" E	179.89'
L4	S 63°56'24" E	54.84'	L18	S 00°18'58" E	400.23'
L5	S 78°58'23" E	42.64'	L19	S 00°26'32" E	298.55'
L6	N 89°49'49" E	275.35'	L20	S 00°17'25" E	305.34'
L7	N 89°23'57" E	224.56'	L21	S 00°07'16" E	586.18'
L8	N 88°55'51" E	156.37'	L22	S 00°08'37" W	161.72'
L9	N 88°22'10" E	48.36'	L23	S 00°01'55" E	159.24'
L10	N 81°51'56" E	94.55'	L24	S 00°38'53" W	203.78'
L11	N 89°42'44" E	162.65'	L25	S 06°55'59" W	37.61'
L12	N 89°34'59" E	184.56'	L26	S 42°44'37" W	12.84'
L13	N 89°28'38" E	111.60'	L27	S 78°39'33" W	56.07'
L14	S 83°47'05" E	15.95'	L28	S 03°09'57" W	7.75'

SURVEYOR'S CERTIFICATE

This is to certify that this plat was prepared from the field notes and electronic data collector files of an actual survey made by me, or under my personal supervision, of the pipeline shown hereon, and that this plat accurately represents said survey to the best of my knowledge.

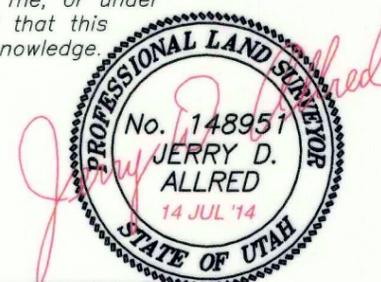


JERRY D. ALLRED, REGISTERED LAND SURVEYOR,
 CERTIFICATE NO. 148951 (UTAH)

THIS SURVEY WAS PERFORMED USING GLOBAL POSITIONING SYSTEM PROCEDURES AND EQUIPMENT

THE BASIS OF BEARINGS IS GEODETIC NORTH DERIVED FROM G.P.S. OBSERVATIONS AT THE SECTION CORNER LOCATED AT LAT. 40°15'22.90258"N AND LONG. 110°23'21.19760"W USING THE UTAH STATE G.P.S. VIRTUAL REFERENCE STATION CONTROL NETWORK MAINTAINED AND OPERATED BY THE AUTOMATED GEOGRAPHIC REFERENCE CENTER

COUNTY SURVEYOR'S FILE NUMBER

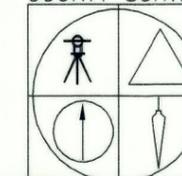



JERRY D. ALLRED AND ASSOCIATES
 SURVEYING CONSULTANTS

1235 NORTH 700 EAST--P.O. BOX 975
 DUCHESNE, UTAH 84021
 (435) 738-5352


14 JUL 2014

12-121-216

County Surveyor File # 3166

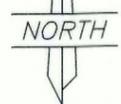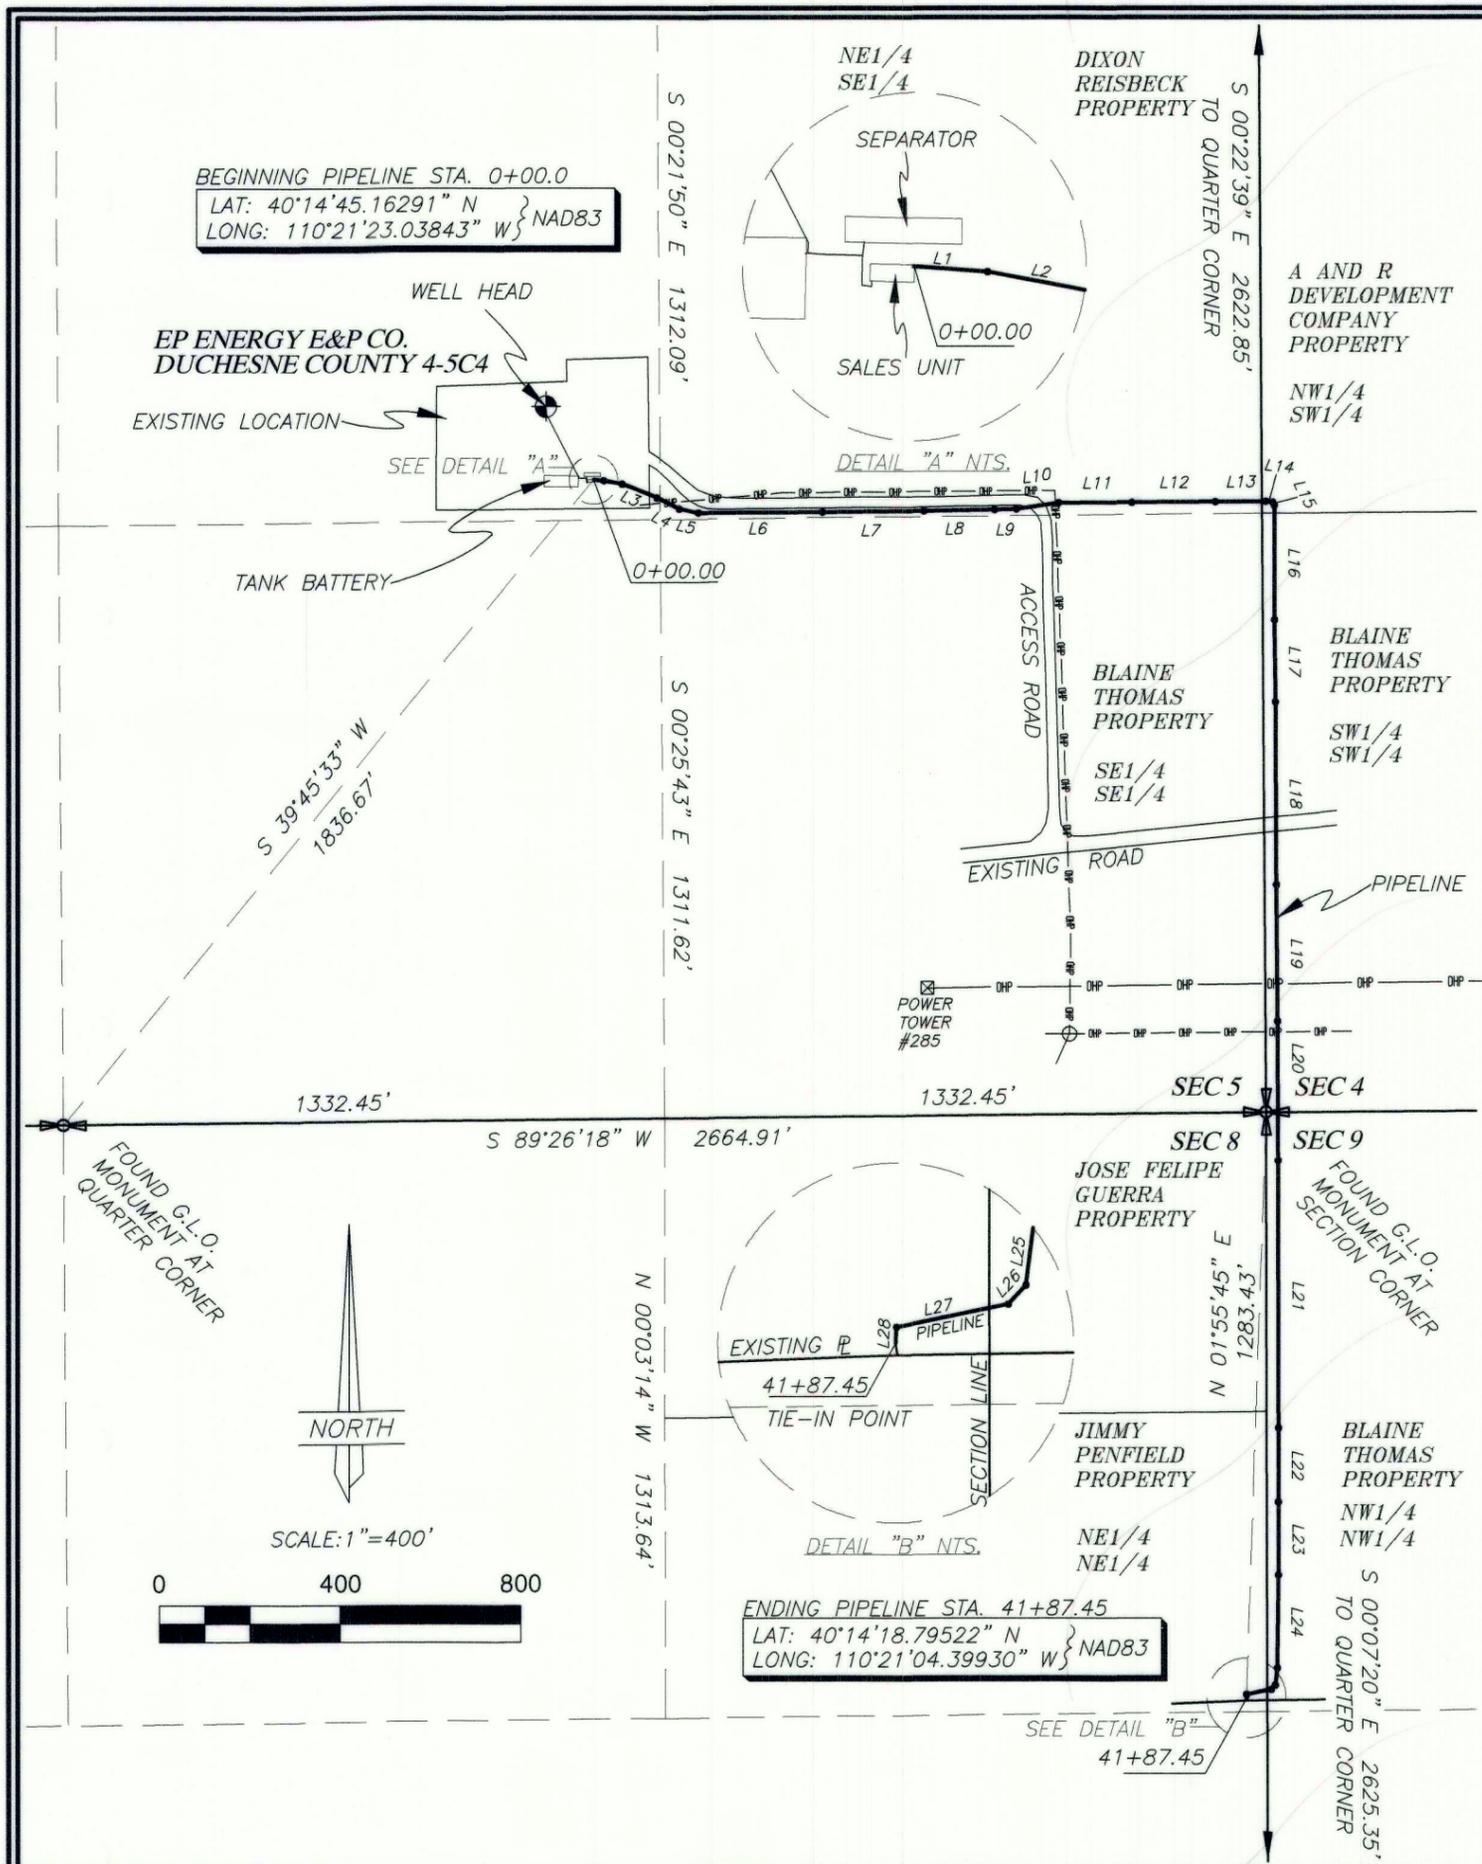


SCALE: 1"=400'

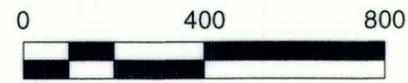

PIPELINE AS-BUILT SURVEY FOR
KINDER MORGAN ALTAMONT, LLC.
KOZAR 2-5C4


NE¼ SE¼,
 SECTION 6, T3S, R4W, U.S.B.&M.
 NW¼ SW¼,
 SECTION 5, T3S, R4W, U.S.B.&M.
 DUCHESNE COUNTY, UTAH

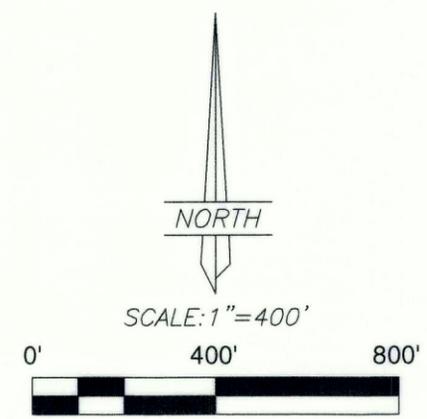

THIS SURVEY WAS PERFORMED USING GLOBAL POSITIONING SYSTEM PROCEDURES AND EQUIPMENT
 THE BASIS OF BEARINGS IS GEODETIC NORTH DERIVED FROM G.P.S. OBSERVATIONS AT THE SECTION CORNER LOCATED AT LAT. 40°15'22.90258"N AND LONG. 110°23'21.19760"W USING THE UTAH STATE G.P.S. VIRTUAL REFERENCE STATION CONTROL NETWORK MAINTAINED AND OPERATED BY THE AUTOMATED GEOGRAPHIC REFERENCE CENTER

SURVEYOR'S CERTIFICATE


This is to certify that this plat was prepared from the field notes and electronic data collector files of an actual survey made by me, or under my personal supervision, of the pipeline shown hereon, and that this plat accurately represents said survey to the best of my knowledge.

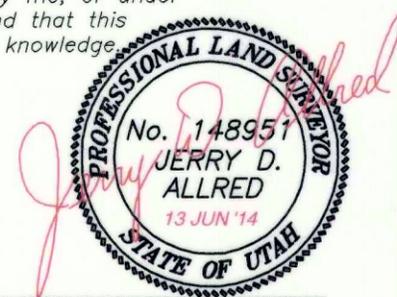

Jerry D. Allred, Professional Land Surveyor,
 Certificate 148951 (Utah)

COUNTY SURVEYORS FILE NUMBER: 3166


JERRY D. ALLRED AND ASSOCIATES
 SURVEYING CONSULTANTS
 1235 NORTH 700 EAST--P.O. BOX 975
 DUCHESNE, UTAH 84021
 (435) 738-5352

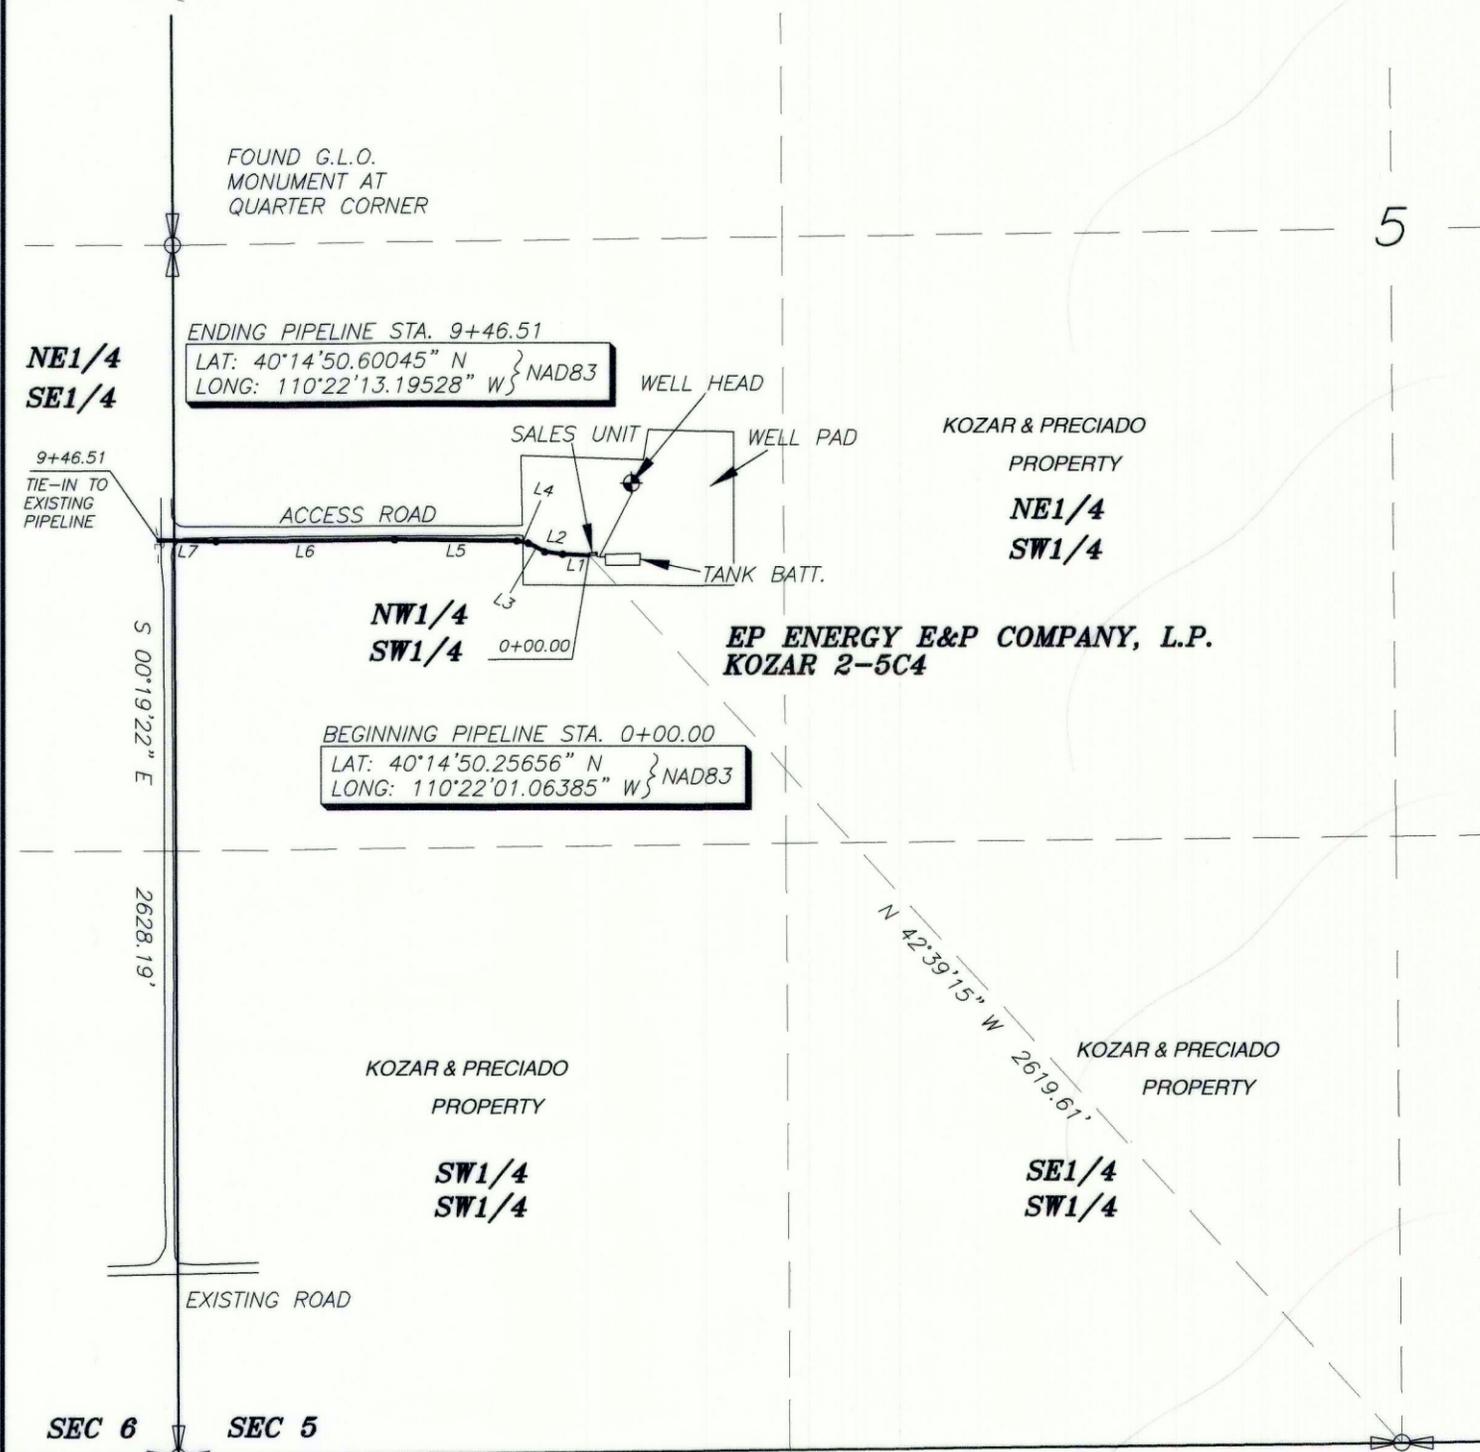

LINE	BEARING	DISTANCE
L1	N 87°37'25" W	58.15'
L2	N 82°43'34" W	39.45'
L3	N 62°22'47" W	40.14'
L4	N 78°09'03" W	25.42'
L5	N 89°24'53" W	267.25'
L6	S 89°42'45" W	390.00'
L7	N 88°49'35" W	126.10'


PIPELINE "AS-BUILT" SURVEY FOR
KINDER MORGAN ALTAMONT, LLC.
ADELMAN 2-4C4
 SECTIONS 4 & 9, T3S, R4W, U.S.B.&M.
 DUCHESNE COUNTY, UTAH

LINE	BEARING	DISTANCE	LINE	BEARING	DISTANCE
L1	S 08°53'00" E	9.03'	L14	S 09°04'37" E	14.01'
L2	S 28°32'38" E	7.71'	L15	S 01°22'08" E	90.55'
L3	S 37°51'34" E	15.53'	L16	S 00°47'50" E	131.08'
L4	S 69°32'51" E	13.79'	L17	S 00°25'15" E	224.58'
L5	S 79°34'55" E	19.38'	L18	S 00°19'27" E	303.66'
L6	N 89°58'29" E	56.73'	L19	S 00°31'42" E	314.98'
L7	N 87°14'38" E	94.98'	L20	S 00°07'04" E	276.36'
L8	S 88°04'19" E	146.29'	L21	S 00°21'39" E	53.85'
L9	S 88°27'01" E	179.51'	L22	S 19°31'38" E	9.77'
L10	S 84°07'46" E	56.38'	L23	S 64°31'35" E	11.03'
L11	S 32°12'41" E	21.53'	L24	S 62°48'51" E	14.49'
L12	S 24°25'15" E	53.01'	L25	S 01°08'11" E	3.28'
L13	S 18°50'23" E	32.73'			

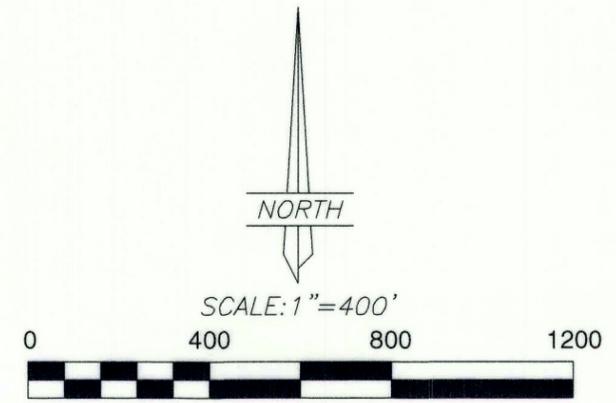


SURVEYOR'S CERTIFICATE

This is to certify that this plat was prepared from the field notes and electronic data collector files of an actual survey made by me, or under my personal supervision, of the pipeline shown hereon, and that this plat accurately represents said survey to the best of my knowledge.

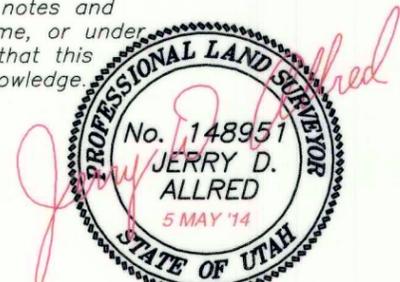

Jerry D. Allred, Professional Land Surveyor,
 Certificate 148951 (Utah)


THIS SURVEY WAS PERFORMED USING GLOBAL POSITIONING SYSTEM PROCEDURES AND EQUIPMENT
 THE BASIS OF BEARINGS IS GEODETIC NORTH DERIVED FROM G.P.S. OBSERVATIONS AT THE SECTION CORNER LOCATED AT LAT. 40°15'22.90258"N AND LONG. 110°23'21.19760"W USING THE UTAH STATE G.P.S. VIRTUAL REFERENCE STATION CONTROL NETWORK MAINTAINED AND OPERATED BY THE AUTOMATED GEOGRAPHIC REFERENCE CENTER

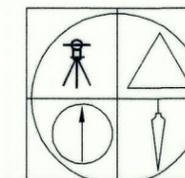

JERRY D. ALLRED AND ASSOCIATES
 SURVEYING CONSULTANTS

1235 NORTH 700 EAST--P.O. BOX 975
 DUCHESNE, UTAH 84021
 (435) 738-5352

29 MAY 2014 12-121-185

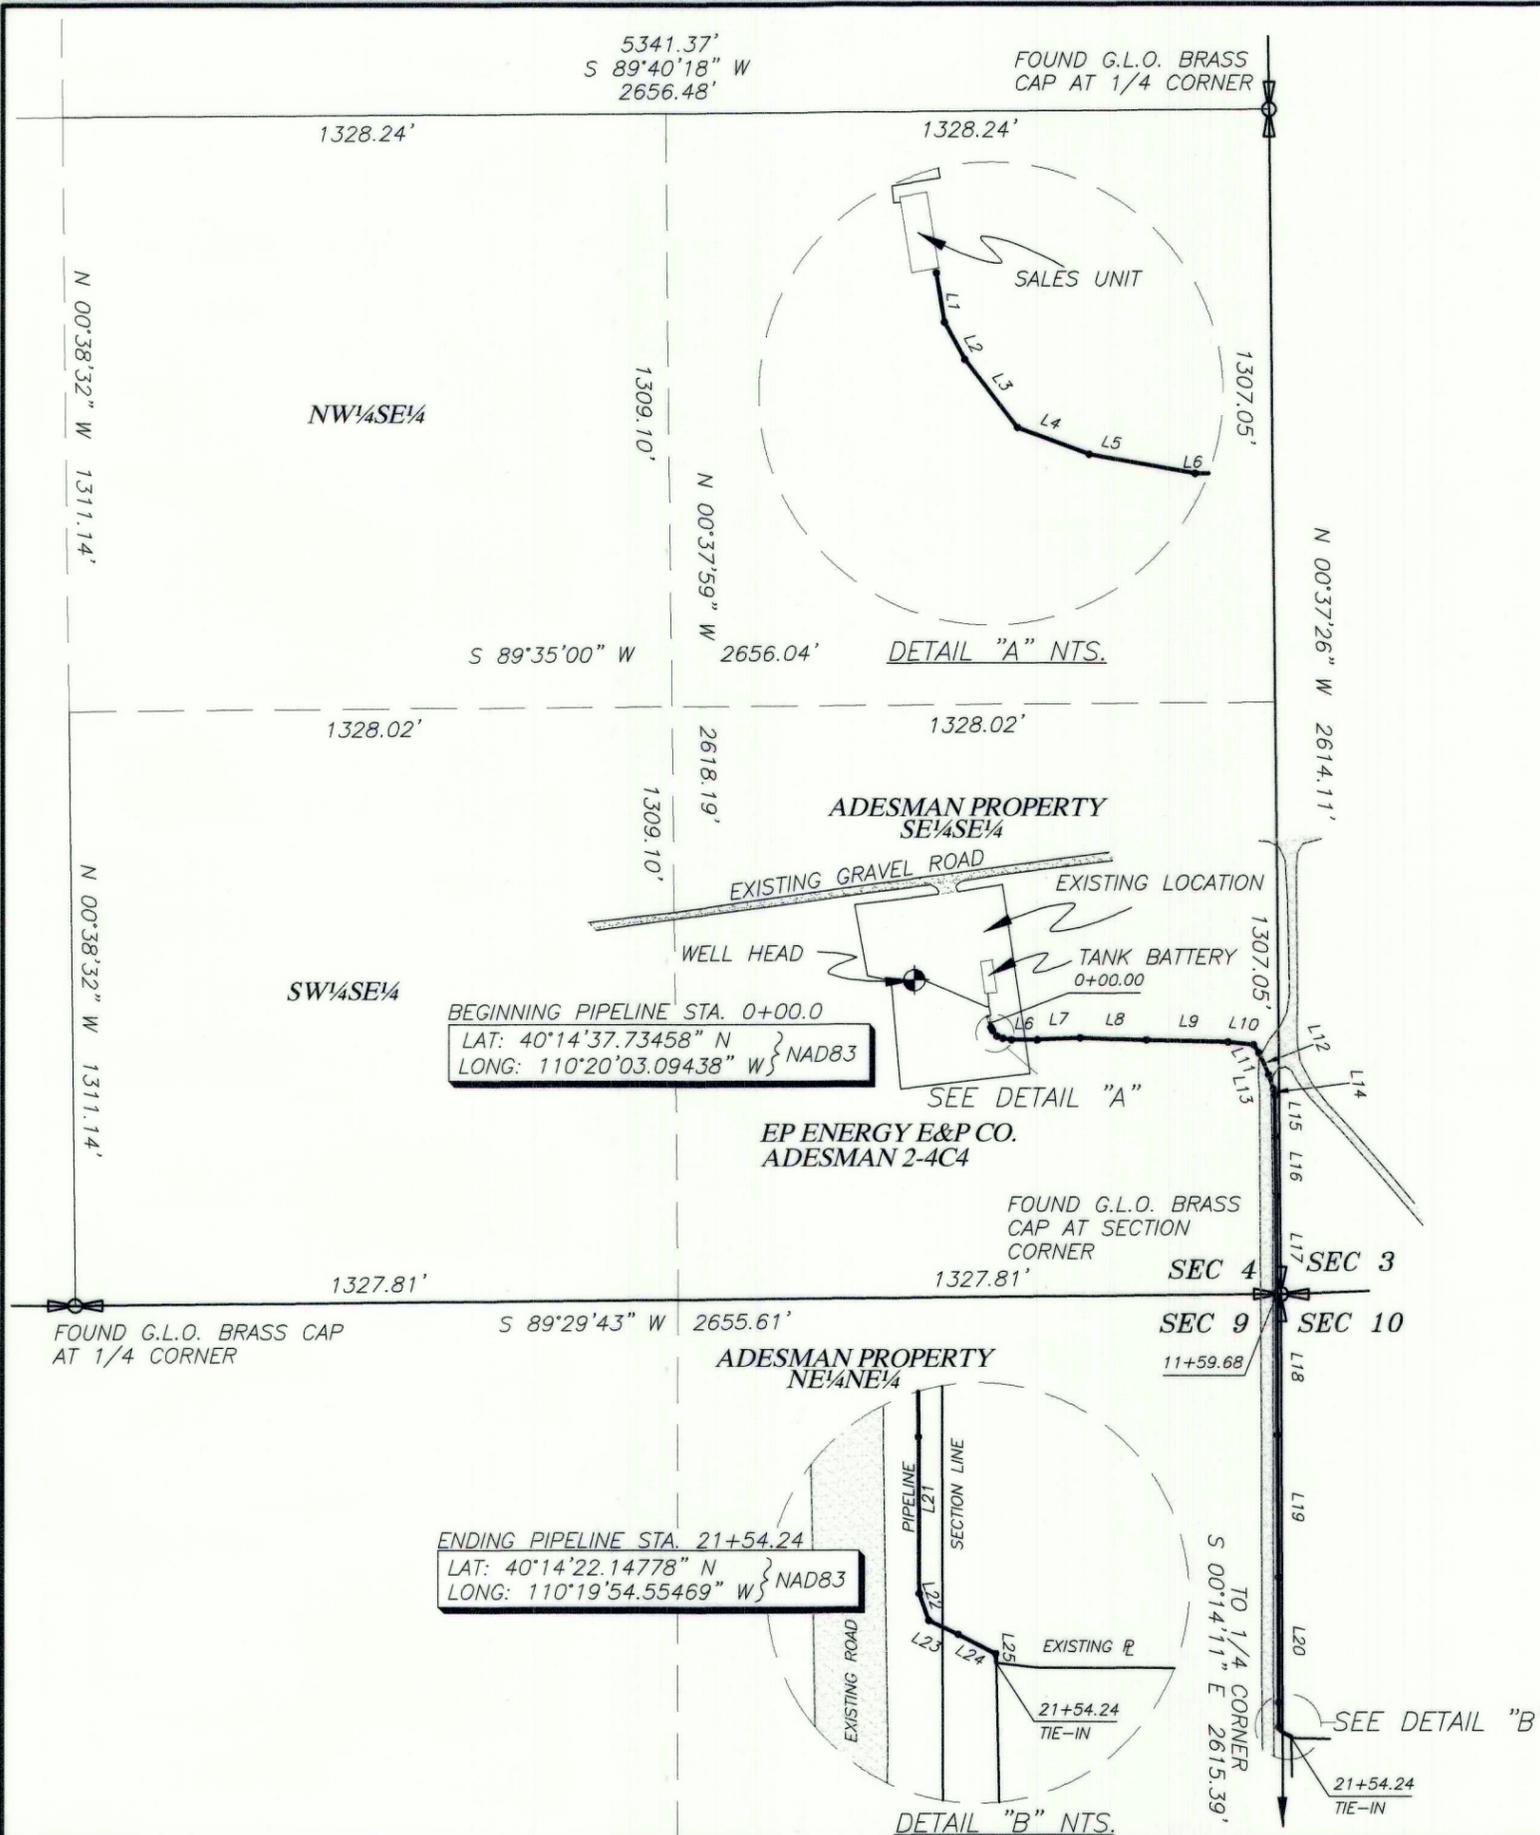

BEGINNING PIPELINE STA. 0+00.0
 LAT: 40°14'37.73458" N } NAD83
 LONG: 110°20'03.09438" W }

ENDING PIPELINE STA. 21+54.24
 LAT: 40°14'22.14778" N } NAD83
 LONG: 110°19'54.55469" W }

DETAIL "A" NTS.

DETAIL "B" NTS.