

"AS-BUILT" SURVEY FOR
EAST DUCHESNE WATER DISTRICT
 &
DUCHESNE COUNTY

SECTION 31, TOWNSHIP 3 SOUTH, RANGE 4 WEST
 SECTION 36, TOWNSHIP 3 SOUTH, RANGE 5 WEST
 UINTAH SPECIAL BASE AND MERIDIAN

SURVEYOR'S CERTIFICATE



This is to certify that I have surveyed the water lines shown on this plat, and that the monuments indicated were found or set during said survey, and that this plat accurately represents said survey to the best of my knowledge.

Jerry D. Allred
 Jerry D. Allred, Licensed Land Surveyor,
 Certificate 148951 (Utah)



EASEMENT DESCRIPTION OVER ALAN POULSON PROPERTY FOR EAST DUCHESNE CULINARY WATER IMPROVEMENT DISTRICT

A 30 feet wide waterline easement over the West 30 feet of the following described parcel; Commencing at the Southwest Corner of the NW1/4 of the SW1/4 of Section 31, Township 3 South, Range 4 West of the Uintah Special Base and Meridian:
 Thence North 88°45'05" East 701.67 feet along the South line of said NW1/4 and the TRUE POINT OF BEGINNING;
 Thence North 4°33'17" East 1807.77 feet to the South line of the Duchesne County property;
 Thence South 87°02'20" East 55.01 feet to the Southeast Corner of said County property;
 Thence South 3°09'02" East 916.66 feet;
 Thence South 88°45'05" West 65.88 feet;
 Thence South 0°20'05" East 646.92 feet, parallel with the East line of said NW1/4 to the North line of the Clair Poulson property;
 Thence South 38°24'30" West 300.66 feet to the TRUE POINT OF BEGINNING, containing 5.00 acres.

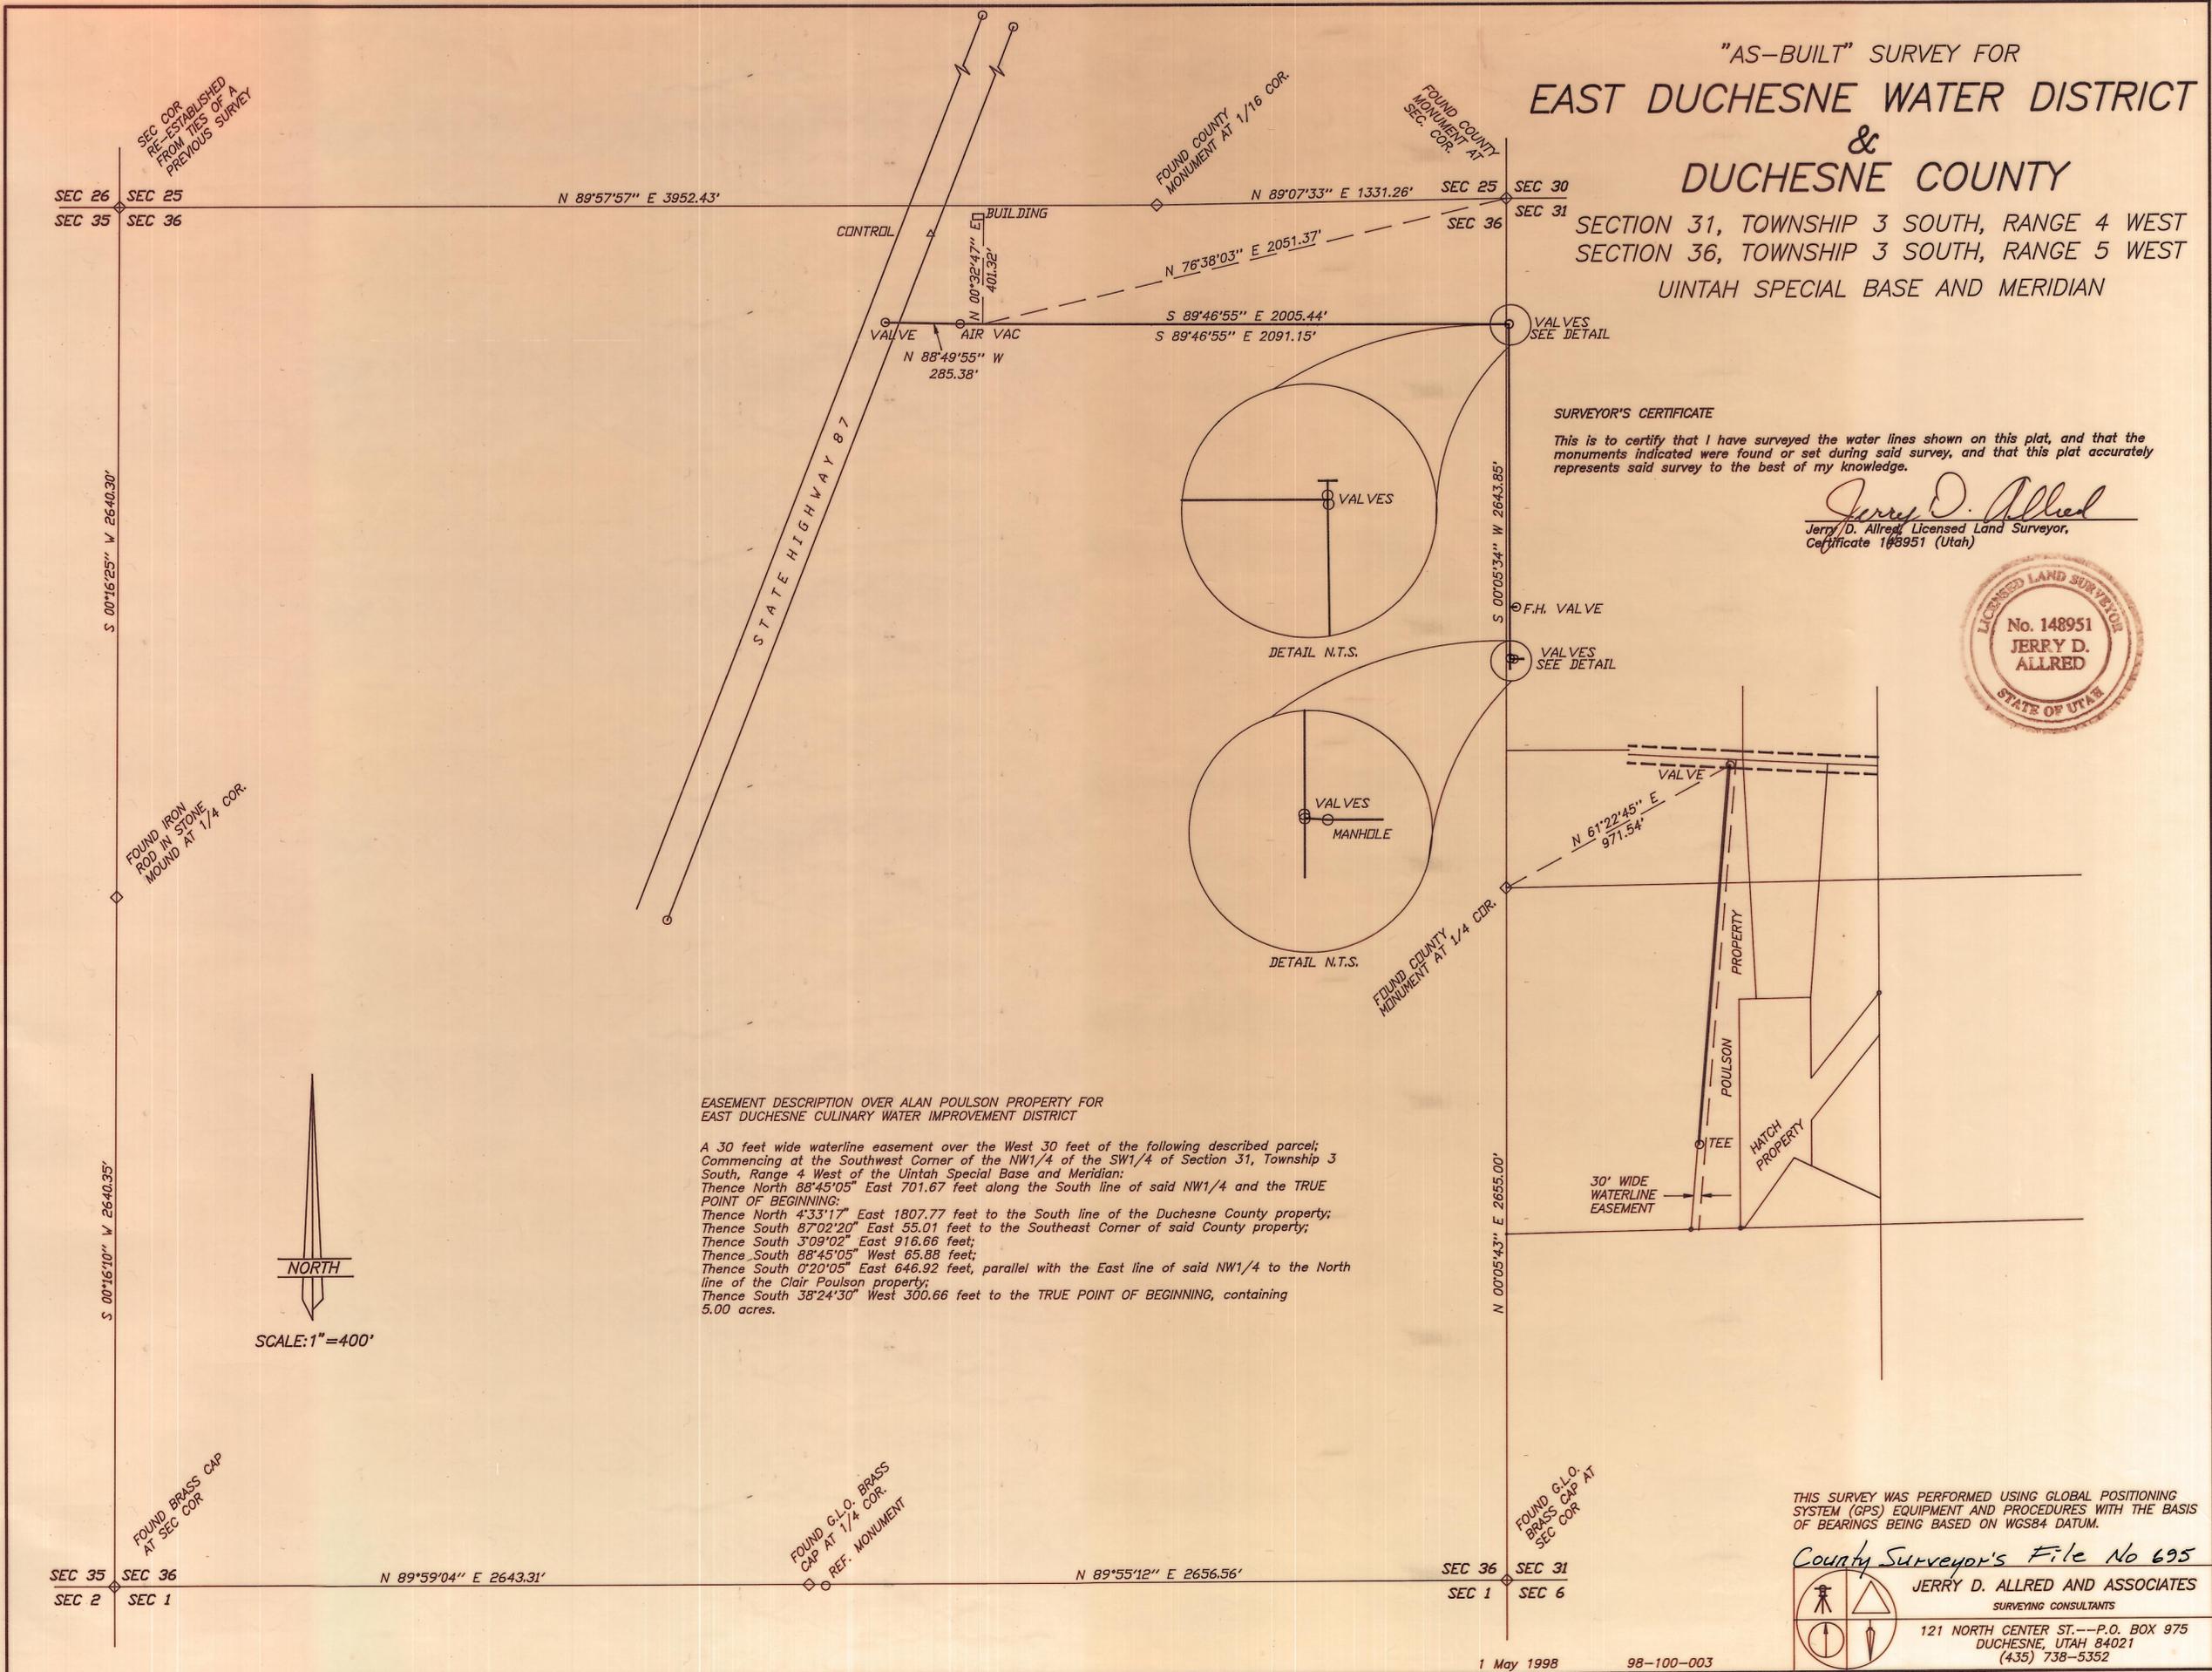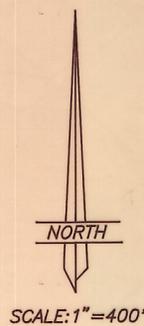

THIS SURVEY WAS PERFORMED USING GLOBAL POSITIONING SYSTEM (GPS) EQUIPMENT AND PROCEDURES WITH THE BASIS OF BEARINGS BEING BASED ON WGS84 DATUM.

County Surveyor's File No 695
JERRY D. ALLRED AND ASSOCIATES
 SURVEYING CONSULTANTS
 121 NORTH CENTER ST.--P.O. BOX 975
 DUCHESNE, UTAH 84021
 (435) 738-5352