ANR PRODUCTION CO.

AS-BUILT SURFACE USE, ROAD & PIPELINE RIGHTS-OF-WAY

(LINDSAY RUSSELL #1-32B4 & 2-32B4)

LOCATED IN
SECTION 32, T2S, R4W, U.S.B.&M.
DUCHESNE COUNTY, UTAH

T2S, R4W, U.S.B.&M.

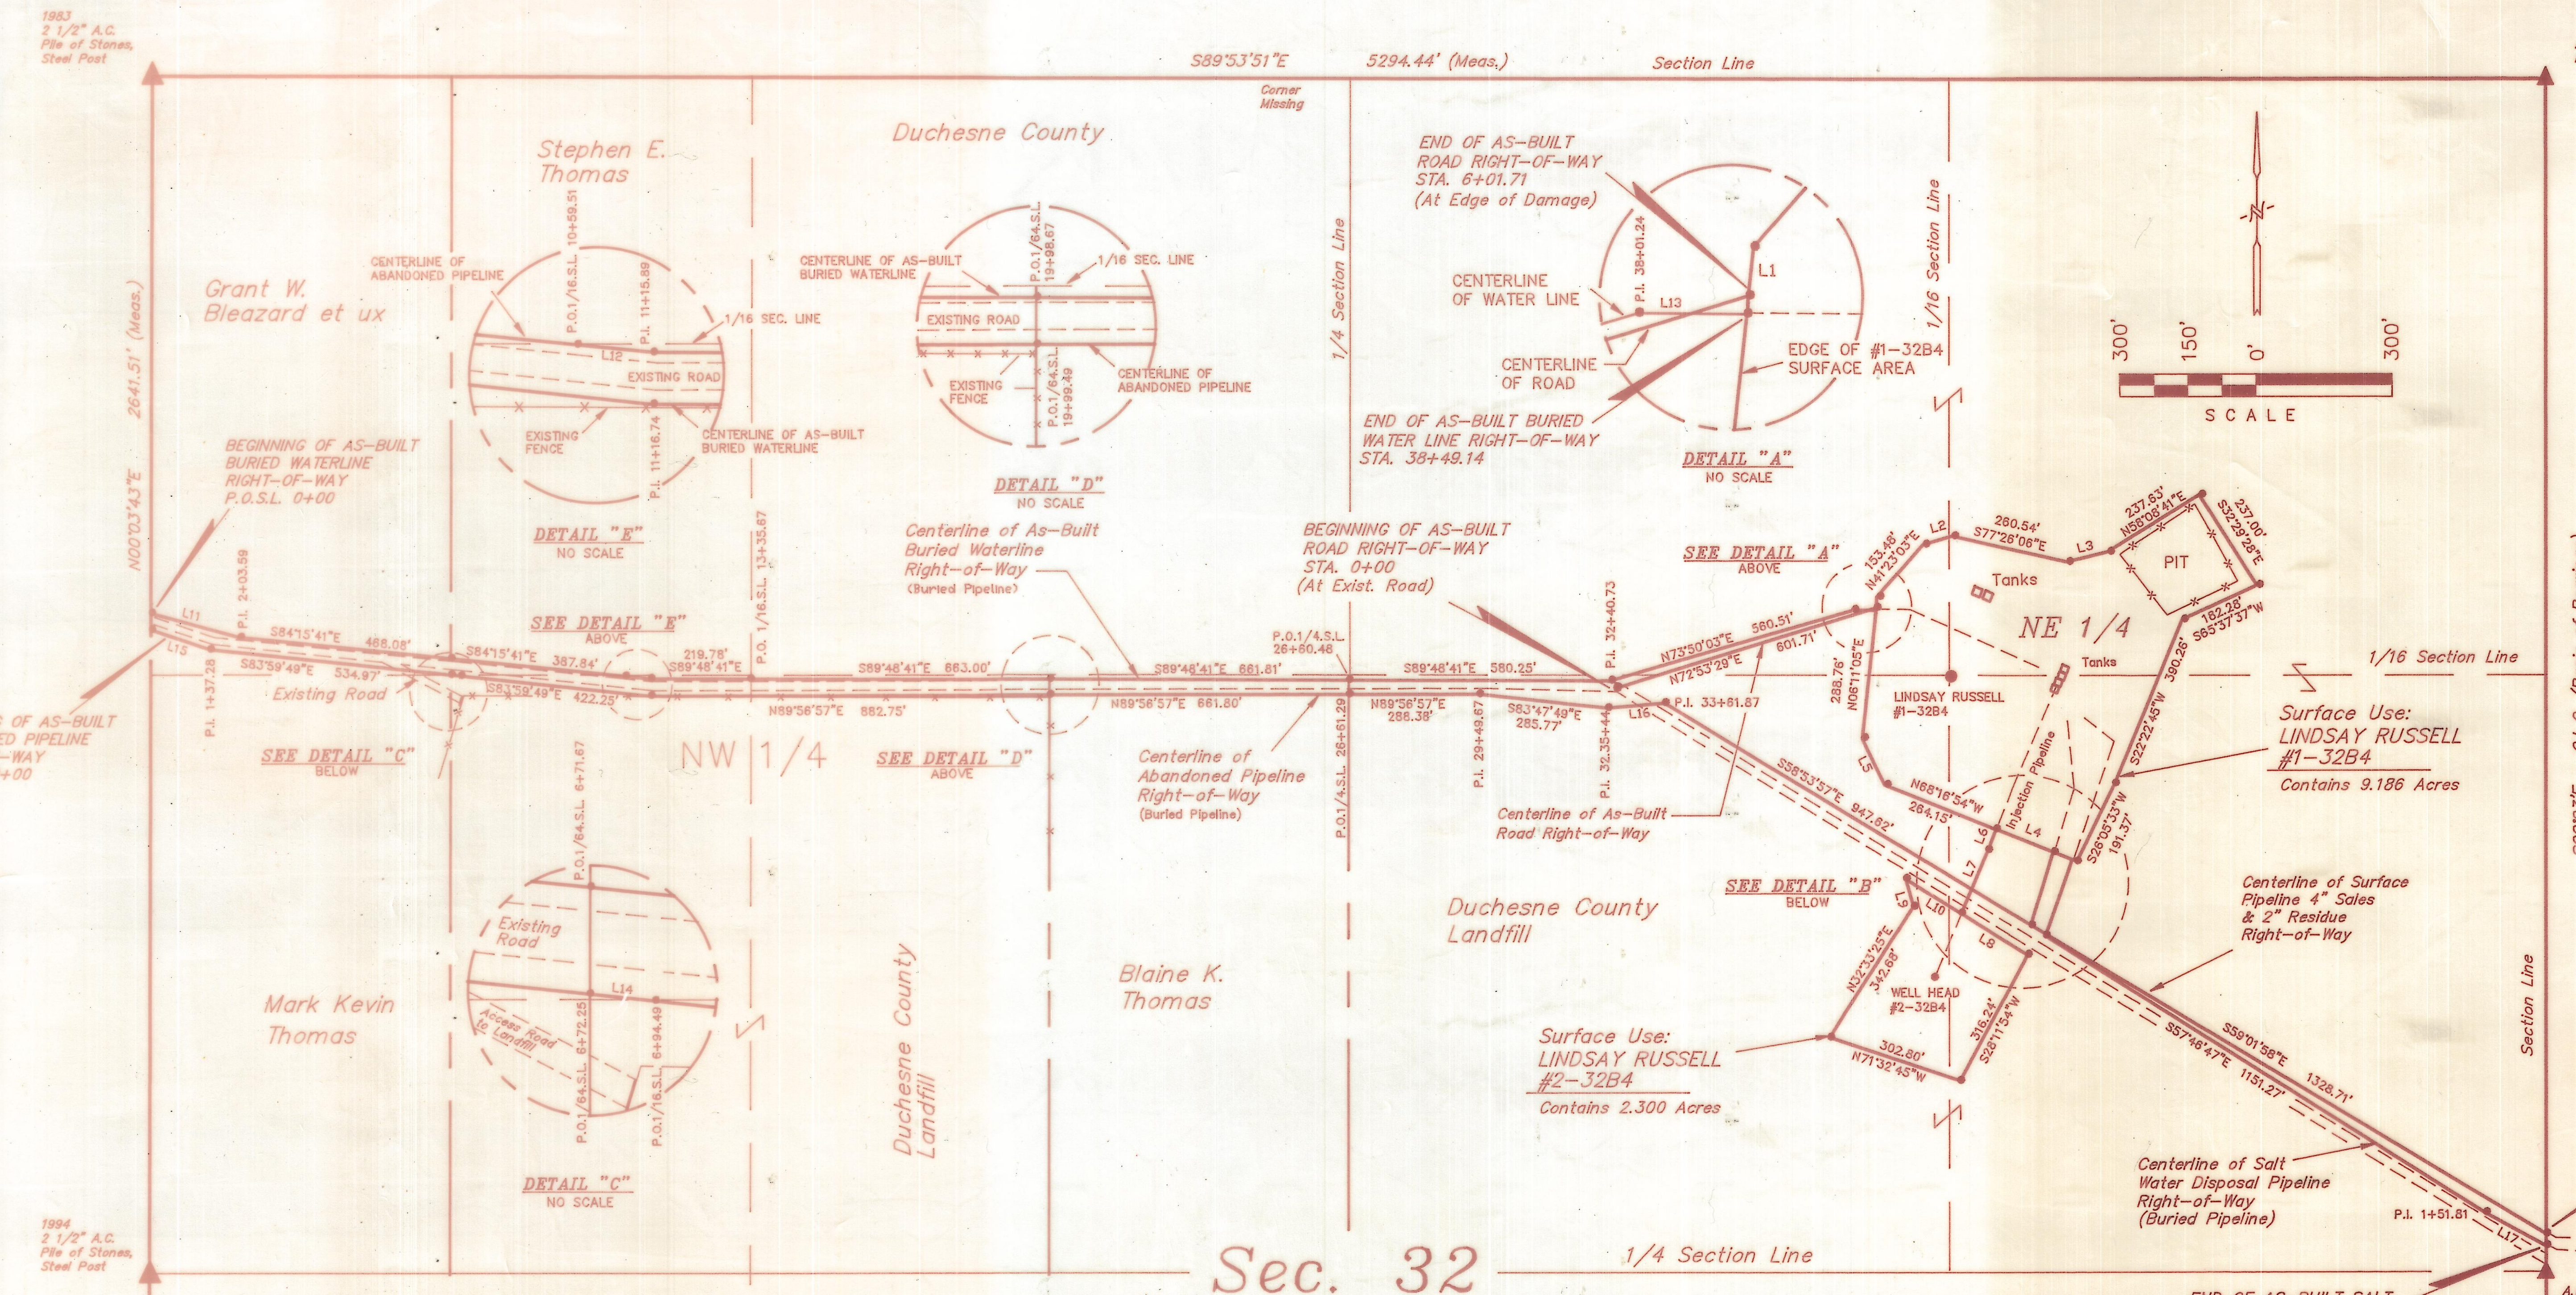

LINE	DIRECTION	DISTANCE
L1	N06°11'05"E	24.65'
L2	N73°56'44"E	66.28'
L3	N76°14'40"E	94.08'
L4	N68°16'54"W	192.42'
L5	N26°18'57"W	114.60'
L6	S21°15'30"W	49.13'
L7	S22°57'51"W	152.05'
L8	S58°12'26"E	173.06'
L9	N16°10'05"W	63.95'
L10	S58°12'26"E	144.67'
L11	S74°47'06"E	203.59'
L12	S84°15'41"E	56.38'
L13	S89°33'14"E	47.90'
L14	S83°59'49"E	22.24'
L15	S71°27'20"E	137.28'
L16	N85°04'06"E	126.43'
L17	S61°20'15"E	151.81'

UINTAH ENGINEETING & LAND SURVEYING WILL NOT BE RESPONSIBLE FOR LAND OWNER DISPUTES OR LAND OWNER'S PROPERTY LINES. THIS IS A CENTERLINE SURVEY ONLY, AND DOES CONSTITUTE A PROPERTY SURVEY IN ANY WAY.

AS-BUILT BURIED WATERLINE PIPELINE RIGHT-OF-WAY DESCRIPTION STEPHEN E. THOMAS PROPERTY

A 33' WIDE RIGHT-OF-WAY 16.5' ON EACH SIDE OF THE FOLLOWING DESCRIBED CENTERLINE.

BEGINNING AT A POINT ON THE WEST LINE OF THE EAST 1/2 OF THE NW 1/4 NW 1/4 OF SECTION 32, T2S, R4W, U.S.B.&M. WHICH BEARS S27°15'13"E 1443.23' FROM THE NORTHWEST CORNER OF SAID SECTION, THENCE S84°15'41"E 387.84' TO A POINT ON THE SOUTH LINE OF THE NW 1/4 NW 1/4 OF SAID SECTION, WHICH BEARS S38°22'39"E 1686.10' FROM THE NORTHWEST CORNER OF SAID SECTION. THE SIDE LINES OF SAID DESCRIBED RIGHT-OF-WAY BEING SHORTENED OR ELONGATED TO MEET THE GRANTOR'S PROPERTY LINES. BASIS OF BEARINGS IS THE EAST LINE OF THE NE 1/4 OF SECTION 32, WHICH IS ASSUMED FROM G.L.O. INFORMATION TO BEAR S0°03'E. CONTAINS 0.294 ACRES MORE OR LESS.

AS-BUILT BURIED WATERLINE PIPELINE RIGHT-OF-WAY DESCRIPTION GRANT W. BLEAZARD PROPERTY

A 33' WIDE RIGHT-OF-WAY 16.5' ON EACH SIDE OF THE FOLLOWING DESCRIBED CENTERLINE.

BEGINNING AT A POINT ON THE WEST LINE OF THE NW 1/4 OF SECTION 32, T2S, R4W, U.S.B.&M. WHICH BEARS S00°03'43"W 1182.79' FROM THE NORTHWEST CORNER OF SAID SECTION, THENCE S74°47'06"E 203.59'; THENCE S84°15'41"E 468.08' TO A POINT ON THE EAST LINE OF THE WEST 1/2 OF THE NW 1/4 NW 1/4 OF SECTION 32, WHICH BEARS S27°15'13"E 1443.23' FROM THE NORTHWEST CORNER OF SAID SECTION 32. SIDE LINES OF SAID DESCRIBED RIGHT-OF-WAY BEING SHORTENED OR ELONGATED TO MEET THE GRANTOR'S PROPERTY LINES. BASIS OF BEARINGS IS THE EAST LINE OF THE NE 1/4 OF SECTION 32, WHICH IS ASSUMED FROM G.L.O. INFORMATION TO BEAR S0°03'E. CONTAINS 0.509 ACRES MORE OR LESS.

AS-BUILT ABANDONED PIPELINE PIPELINE RIGHT-OF-WAY DESCRIPTION STEPHEN E. THOMAS PROPERTY

A 33' WIDE RIGHT-OF-WAY 16.5' ON EACH SIDE OF THE FOLLOWING DESCRIBED CENTERLINE.

BEGINNING AT A POINT ON THE WEST LINE OF THE EAST 1/2 OF THE NW 1/4 NW 1/4 OF SECTION 32, T2S, R4W, U.S.B.&M. WHICH BEARS S26°36'39"E 1475.40' FROM THE NORTHWEST CORNER OF SAID SECTION, THENCE S83°59'49"E 22.24' TO A POINT ON THE SOUTH LINE OF THE SAID NW 1/4 NW 1/4 OF SAID SECTION 32, WHICH BEARS S27°19'57"E 1487.50' FROM THE NORTHWEST CORNER OF SAID SECTION. THE SIDE LINES OF SAID DESCRIBED RIGHT-OF-WAY BEING SHORTENED OR ELONGATED TO MEET THE GRANTOR'S PROPERTY LINES. BASIS OF BEARINGS IS THE EAST LINE OF THE NE 1/4 OF SECTION 32, WHICH IS ASSUMED FROM G.L.O. INFORMATION TO BEAR S0°03'E. CONTAINS 0.017 ACRES MORE OR LESS.

AS-BUILT ABANDONED PIPELINE RIGHT-OF-WAY DESCRIPTION GRANT W. BLEAZARD PROPERTY

A 33' WIDE RIGHT-OF-WAY 16.5' ON EACH SIDE OF THE FOLLOWING DESCRIBED CENTERLINE.

BEGINNING AT A POINT ON THE WEST LINE OF THE NW 1/4 OF SECTION 32, T2S, R4W, U.S.B.&M. WHICH BEARS S00°03'43"W 1219.50' FROM THE NORTHWEST CORNER OF SAID SECTION, THENCE S71°27'20"E 137.28'; THENCE S83°59'49"E 534.97' TO A POINT ON THE EAST LINE OF THE WEST 1/2 OF THE NW 1/4 NW 1/4 OF SECTION 32, WHICH BEARS S26°36'39"E 1475.40' FROM THE NORTHWEST CORNER OF SAID SECTION 32. SIDE LINES OF SAID DESCRIBED RIGHT-OF-WAY BEING SHORTENED OR ELONGATED TO MEET THE GRANTOR'S PROPERTY LINES. BASIS OF BEARINGS IS THE EAST LINE OF THE NE 1/4 OF SECTION 32, WHICH IS ASSUMED FROM G.L.O. INFORMATION TO BEAR S0°03'E. CONTAINS 0.509 ACRES MORE OR LESS.

Note:
OWNERSHIP SHOWN ON THIS PLAT WERE OBTAINED FROM THE DUCHESNE COUNTY RECORDER'S OFFICE ON THE DATE OF THIS PLAT.

BEGINNING OF ROAD STA. 0+00 BEARS N57°52'37"W 2429.20' FROM THE EAST 1/4 CORNER OF SECTION 32, T2S, R4W, U.S.B.&M.

ROAD STA 6+01.71 BEARS S51°48'17"W 1883.08' FROM THE NORTHEAST CORNER OF SECTION 32, T2S, R4W, U.S.B.&M.

WATER INJECTION PIPELINE STA. 0+00 BEARS N51°07'36"W 1563.36' FROM THE EAST 1/4 CORNER OF SECTION 32, T2S, R4W, U.S.B.&M.

WATER INJECTION PIPELINE STA. 2+01.18 BEARS N58°25'39"W 1519.13' FROM THE EAST 1/4 CORNER OF SECTION 32, T2S, R4W, U.S.B.&M.

BURIED WATERLINE P.O.S.L. 0+00 BEARS S00°03'43"W 1182.79' FROM THE NORTHWEST CORNER OF SECTION 32, T2S, R4W, U.S.B.&M.

BURIED WATERLINE STA. 6+71.67 BEARS S27°15'13"E 1443.23' FROM THE NORTHWEST CORNER OF SECTION 32, T2S, R4W, U.S.B.&M.

BURIED WATERLINE STA. 10+59.51 BEARS S38°22'39"E 1686.10' FROM THE NORTHWEST CORNER OF SECTION 32, T2S, R4W, U.S.B.&M.

BURIED WATERLINE STA. 13+35.67 BEARS S44°52'53"E 1874.42' FROM THE NORTHWEST CORNER OF SECTION 32, T2S, R4W, U.S.B.&M.

BURIED WATERLINE STA. 19+98.67 BEARS S56°10'45"E 2390.12' FROM THE NORTHWEST CORNER OF SECTION 32, T2S, R4W, U.S.B.&M.

BURIED WATERLINE STA. 26+60.48 BEARS S63°26'32"W 2959.20' FROM THE NORTHEAST CORNER OF SECTION 32, T2S, R4W, U.S.B.&M.

BURIED WATERLINE STA. 38+49.14 BEARS S51°41'53"W 1886.52' FROM THE NORTHEAST CORNER OF SECTION 32, T2S, R4W, U.S.B.&M.

ABANDONED PIPELINE P.O.S.L. 0+00 BEARS S00°03'43"W 1219.50' FROM THE NORTHWEST CORNER OF SECTION 32, T2S, R4W, U.S.B.&M.

ABANDONED PIPELINE STA. 6+72.25 BEARS S26°36'39"E 1475.40' FROM THE NORTHWEST CORNER OF SECTION 32, T2S, R4W, U.S.B.&M.

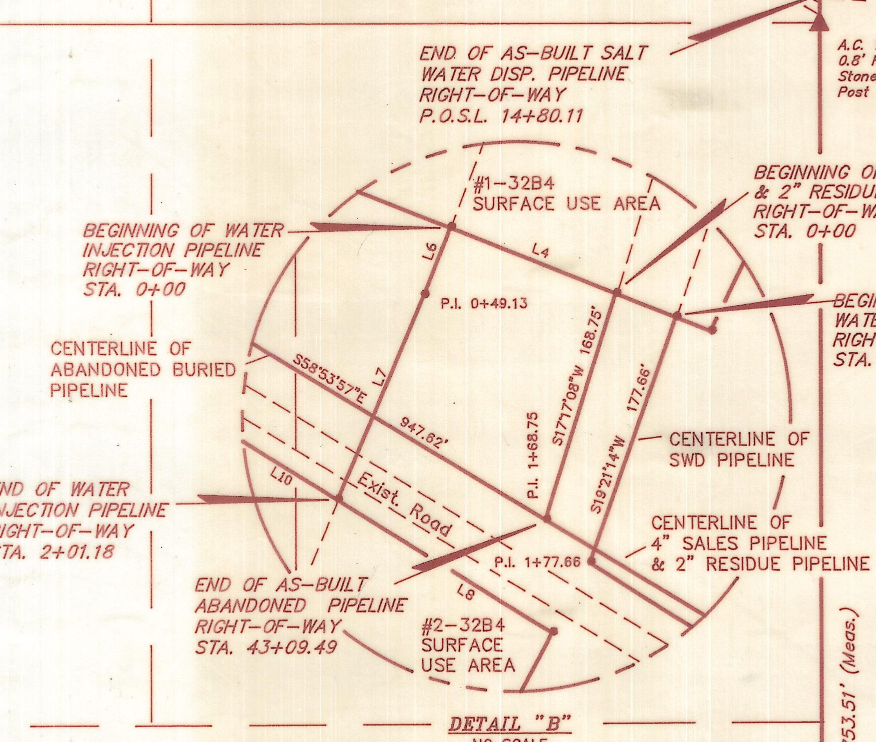

ABANDONED PIPELINE STA. 6+94.49 BEARS S27°19'57"E 1487.50' FROM THE NORTHWEST CORNER OF SECTION 32, T2S, R4W, U.S.B.&M.

ABANDONED PIPELINE STA. 19+99.49 BEARS S55°29'53"E 2409.48' FROM THE NORTHWEST CORNER OF SECTION 32, T2S, R4W, U.S.B.&M.

ABANDONED PIPELINE STA. 26+61.29 BEARS S64°14'29"W 2941.54' FROM THE EAST 1/4 CORNER OF SECTION 32, T2S, R4W, U.S.B.&M.

ABANDONED PIPELINE STA. 43+09.49 BEARS N55°58'50"W 1374.67 FROM THE EAST 1/4 CORNER OF SECTION 32, T2S, R4W, U.S.B.&M.

SALT WATER DISPOSAL STA. 0+00 BEARS N48°55'08"W 1390.81' FROM THE WEST 1/4 CORNER OF SECTION 32, T2S, R4W, U.S.B.&M.

SALT WATER DISPOSAL STA. 14+80.74 BEARS N00°03'00"W 59.67' FROM THE EAST 1/4 CORNER OF SECTION 32, T2S, R4W, U.S.B.&M.

4" SALES 2" RESIDUE LINE STA. 0+00 BEARS N49°30'09"W 1432.41' FROM THE WEST 1/4 CORNER OF SECTION 32, T2S, R4W, U.S.B.&M.

4" SALES 2" RESIDUE LINE STA. 14+97.46 BEARS N00°03'00"W 85.41' FROM THE EAST 1/4 CORNER OF SECTION 32, T2S, R4W, U.S.B.&M.

ROAD RIGHT-OF-WAY LENGTHS

PROPERTY OWNER	FEET	RODS
Duchesne County Land Fill	601.71'	36.47

ABANDONED PIPELINE RIGHT-OF-WAY LENGTHS

PROPERTY OWNER	FEET	RODS
Duchesne County Land Fill	2,953.20'	178.98
Grant W. Bleazard	672.25'	40.74
Stephen E. Thomas	22.24'	1.35
Blain K Thomas	661.80'	40.11

BURIED WATERLINE RIGHT-OF-WAY LENGTHS

PROPERTY OWNER	FEET	RODS
Duchesne County Land Fill	2,127.82'	128.96
Grant W. Bleazard	671.67'	40.71
Stephen E. Thomas	387.84'	23.51
Blain K Thomas	661.81'	40.11

SALT WATER DISPOSAL LINE RIGHT-OF-WAY LENGTHS

PROPERTY OWNER	FEET	RODS
Duchesne County Land Fill	1,480.11'	89.70

WATER INJECTION LINE RIGHT-OF-WAY LENGTHS

PROPERTY OWNER	FEET	RODS
Duchesne County Land Fill	201.18'	12.19

4" SALES - 2" RESIDUE PIPELINE RIGHT-OF-WAY LENGTHS

PROPERTY OWNER	FEET	RODS
Duchesne County Land Fill	1,497.46'	90.78

C.C. 1994 2 1/2" A.C. Set Stones, Metal Post

1914 4" Brass Cap, Green Fence Post

N89°23'42"E 2667.32' (Meas.)

N89°34'15"E 5314.03'

N 1/4 COR. SECTION 5 Brass Cap

N89°47'57"E 2666.42' (Meas.)

2794.35' (Meas.) N00°07'10"E

2753.51' (Meas.) N00°10'35"W

C.C. 1994 2 1/2" A.C. Pile of Stones, Steel Post

4" Brass Cap 1' High, Pile of Stones, Cedar Post

▲ = SECTION CORNERS LOCATED.
P.O.1/16.S.L. = POINT ON 1/16 SECTION LINE
P.O.1/64.S.L. = POINT ON 1/64 SECTION LINE

AS-BUILT ABANDONED PIPELINE RIGHT-OF-WAY DESCRIPTION DUCHESNE COUNTY LANDFILL PROPERTY

A 33' WIDE RIGHT-OF-WAY 16.5' ON EACH SIDE OF THE FOLLOWING DESCRIBED CENTERLINE.

BEGINNING AT A POINT ON THE NORTH LINE OF THE EAST 1/2 OF THE SW 1/4 NW 1/4 OF SECTION 32, T2S, R4W, U.S.B.&M. WHICH BEARS S27°19'57"E 1487.50' FROM THE THE NORTHWEST CORNER OF SAID SECTION 32, THENCE S83°59'49"E 422.25; THENCE N89°56'57"E 882.75' TO A POINT ON THE EAST LINE OF THE WEST 1/2 OF THE SE 1/4 NW 1/4 OF SAID SECTION, WHICH BEARS S55°29'53"E 2409.48' FROM THE NORTHWEST CORNER OF SAID SECTION.
ALSO, BEGINNING AT A POINT ON THE WEST LINE OF THE SW 1/4 NE 1/4 OF SECTION 32, T2S, R4W, U.S.B.&M. WHICH BEARS S64°14'29"W 2941.54' FROM THE EAST 1/4 CORNER OF SAID SECTION, THENCE N89°56'57"E 288.38'; THENCE S83°47'49"E 285.77'; THENCE N85°04'06"E 126.43'; THENCE S58°53'57"E 947.62' TO A POINT IN THE NE 1/4 OF SAID SECTION 32, WHICH BEARS N55°58'50"W 1374.67' FROM THE EAST 1/4 CORNER OF SAID SECTION. THE SIDE LINES OF SAID DESCRIBED RIGHT-OF-WAY BEING SHORTENED OR ELONGATED TO MEET THE GRANTOR'S PROPERTY LINES. BASIS OF BEARINGS IS THE EAST LINE OF THE NE 1/4 OF SECTION 32, WHICH IS ASSUMED FROM G.L.O. INFORMATION TO BEAR S0°03'E. CONTAINS 2.237 ACRES MORE OR LESS.

AS-BUILT WATER INJECTION PIPELINE RIGHT-OF-WAY DESCRIPTION DUCHESNE COUNTY LANDFILL PROPERTY

A 33' WIDE RIGHT-OF-WAY 16.5' ON EACH SIDE OF THE FOLLOWING DESCRIBED CENTERLINE.

BEGINNING AT A POINT IN THE NE 1/4 OF SECTION 32, T2S, R4W, U.S.B.&M. WHICH BEARS N51°07'36"W 1563.36' FROM THE EAST 1/4 CORNER OF SAID SECTION, THENCE S21°15'30"W 49.13'; THENCE S22°57'51"W 152.05' TO A POINT IN THE NE 1/4 OF SAID SECTION 32, WHICH BEARS N58°25'39"W 1519.13' FROM THE EAST 1/4 CORNER OF SAID SECTION. THE SIDE LINES OF SAID DESCRIBED RIGHT-OF-WAY BEING SHORTENED OR ELONGATED TO MEET THE GRANTOR'S PROPERTY LINES. BASIS OF BEARINGS IS THE EAST LINE OF THE NE 1/4 OF SECTION 32, WHICH IS ASSUMED FROM G.L.O. INFORMATION TO BEAR S0°03'E. CONTAINS 0.152 ACRES MORE OR LESS.

AS-BUILT BURIED WATERLINE RIGHT-OF-WAY DESCRIPTION DUCHESNE COUNTY LANDFILL PROPERTY

A 33' WIDE RIGHT-OF-WAY 16.5' ON EACH SIDE OF THE FOLLOWING DESCRIBED CENTERLINE.

BEGINNING AT A POINT ON THE NORTH LINE OF THE EAST 1/2 OF THE SW 1/4 NW 1/4 OF SECTION 32, T2S, R4W, U.S.B.&M. WHICH BEARS S38°22'39"E 1686.10' FROM THE NORTHWEST CORNER OF SAID SECTION 32, THENCE S84°15'41"E 56.38'; THENCE S89°48'41"E 219.78'; THENCE S89°48'41"E 663.00' TO A POINT ON THE WEST LINE OF THE EAST 1/2 OF THE SE 1/4 NW 1/4 OF SAID SECTION, WHICH BEARS S56°10'45"E 2390.12' FROM THE NORTHWEST CORNER OF SAID SECTION 32.
ALSO, BEGINNING AT A POINT ON THE WEST LINE OF THE SW 1/4 NE 1/4 OF SECTION 32, T2S, R4W, U.S.B.&M. WHICH BEARS S63°26'32"W 2959.20' FROM THE NORTHEAST CORNER OF SAID SECTION, THENCE S89°48'41"E 580.25'; THENCE N73°50'03"E 560.51'; THENCE S89°33'14"E 47.90' TO A POINT IN THE NE 1/4 OF SAID SECTION 32, WHICH BEARS S51°41'53"W 1886.52' FROM THE NORTHEAST CORNER OF SAID SECTION 32. THE SIDE LINES OF SAID DESCRIBED RIGHT-OF-WAY BEING SHORTENED OR ELONGATED TO MEET THE GRANTOR'S PROPERTY LINES. BASIS OF BEARINGS IS THE EAST LINE OF THE NE 1/4 OF SECTION 32, WHICH IS ASSUMED FROM G.L.O. INFORMATION TO BEAR S0°03'E. CONTAINS 1.612 ACRES MORE OR LESS.

AS-BUILT BURIED WATERLINE PIPELINE RIGHT-OF-WAY DESCRIPTION BLAINE K. THOMAS PROPERTY

A 33' WIDE RIGHT-OF-WAY 16.5' ON EACH SIDE OF THE FOLLOWING DESCRIBED CENTERLINE.

BEGINNING AT A POINT ON THE WEST LINE OF THE EAST 1/2 OF THE SE 1/4 NW 1/4 OF SECTION 32, T2S, R4W, U.S.B.&M. WHICH BEARS S56°10'45"E 2390.12' FROM THE NORTHWEST CORNER OF SAID SECTION 32, THENCE S89°48'41"E 661.81' TO A POINT ON THE EAST LINE OF THE EAST 1/2 OF THE SE 1/4 NW 1/4 OF SAID SECTION, WHICH BEARS S63°26'32"W 2959.20' FROM THE NORTHEAST CORNER OF SAID SECTION 32. THE SIDE LINES OF SAID DESCRIBED RIGHT-OF-WAY BEING SHORTENED OR ELONGATED TO MEET THE GRANTOR'S PROPERTY LINES. BASIS OF BEARINGS IS THE EAST LINE OF THE NE 1/4 OF SECTION 32, WHICH IS ASSUMED FROM G.L.O. INFORMATION TO BEAR S0°03'E. CONTAINS 0.501 ACRES MORE OR LESS.

AS-BUILT ABANDONED PIPELINE RIGHT-OF-WAY DESCRIPTION BLAINE K. THOMAS PROPERTY

A 33' WIDE RIGHT-OF-WAY 16.5' ON EACH SIDE OF THE FOLLOWING DESCRIBED CENTERLINE.

BEGINNING AT A POINT ON THE WEST LINE OF THE EAST 1/2 OF THE SE 1/4 NW 1/4 OF SECTION 32, T2S, R4W, U.S.B.&M. WHICH BEARS S55°29'53"E 2409.48' FROM THE NORTHWEST CORNER OF SAID SECTION 32, THENCE N89°56'57"E 661.80' TO A POINT ON THE EAST LINE OF THE EAST 1/2 OF THE SE 1/4 NW 1/4 OF SAID SECTION, WHICH BEARS S64°14'29"W 2941.54' FROM THE EAST 1/4 CORNER OF SAID SECTION 32. THE SIDE LINES OF SAID DESCRIBED RIGHT-OF-WAY BEING SHORTENED OR ELONGATED TO MEET THE GRANTOR'S PROPERTY LINES. BASIS OF BEARINGS IS THE EAST LINE OF THE NE 1/4 OF SECTION 32, WHICH IS ASSUMED FROM G.L.O. INFORMATION TO BEAR S0°03'E. CONTAINS 0.501 ACRES MORE OR LESS.

ROAD RIGHT-OF-WAY DESCRIPTION DUCHESNE COUNTY LANDFILL PROPERTY

A 33' WIDE RIGHT-OF-WAY 16.5' ON EACH SIDE OF THE FOLLOWING DESCRIBED CENTERLINE.

BEGINNING AT A POINT IN THE NE 1/4 OF SECTION 32, T2S, R4W, U.S.B.&M. WHICH BEARS N57°52'37"W 2429.20' FROM THE EAST 1/4 CORNER OF SAID SECTION, THENCE N72°53'29"E 601.71' TO A POINT IN THE NE 1/4 OF SAID SECTION 32 WHICH BEARS S51°48'17"W 1883.08' FROM THE NORTHEAST CORNER OF SAID SECTION 32. THE SIDE LINES OF SAID DESCRIBED RIGHT-OF-WAY BEING SHORTENED OR ELONGATED TO MEET THE GRANTOR'S PROPERTY LINES. BASIS OF BEARINGS IS THE EAST LINE OF THE NE 1/4 OF SECTION 32, WHICH IS ASSUMED FROM G.L.O. INFORMATION TO BEAR S0°03'E. CONTAINS 0.456 ACRES MORE OR LESS.

AS-BUILT 4" SALES & 2" RESIDUE PIPELINE RIGHT-OF-WAY DESCRIPTION DUCHESNE COUNTY LANDFILL PROPERTY

A 33' WIDE RIGHT-OF-WAY 16.5' ON EACH SIDE OF THE FOLLOWING DESCRIBED CENTERLINE.

BEGINNING AT A POINT IN THE NE 1/4 OF SECTION 32, T2S, R4W, U.S.B.&M. WHICH BEARS N49°30'09"W 1432.41' FROM THE EAST 1/4 CORNER OF SAID SECTION, THENCE S17°17'08"W 168.75'; THENCE S59°01'58"E 1328.71' TO A POINT ON THE EAST LINE OF THE NE 1/4 OF SAID SECTION 32, WHICH BEARS N00°03'00"W 85.41' FROM THE EAST 1/4 CORNER OF SAID SECTION. THE SIDE LINES OF SAID DESCRIBED RIGHT-OF-WAY BEING SHORTENED OR ELONGATED TO MEET THE GRANTOR'S PROPERTY LINES. BASIS OF BEARINGS IS THE EAST LINE OF THE NE 1/4 OF SECTION 32, WHICH IS ASSUMED FROM G.L.O. INFORMATION TO BEAR S0°03'E. CONTAINS 1.134 ACRES MORE OR LESS.

AS-BUILT SALT WATER DISPOSAL PIPELINE RIGHT-OF-WAY DESCRIPTION DUCHESNE COUNTY LANDFILL PROPERTY

A 33' WIDE RIGHT-OF-WAY 16.5' ON EACH SIDE OF THE FOLLOWING DESCRIBED CENTERLINE.

BEGINNING AT A POINT IN THE NE 1/4 OF SECTION 32, T2S, R4W, U.S.B.&M. WHICH BEARS N48°55'08"W 1390.81' FROM THE EAST 1/4 CORNER OF SAID SECTION 32, THENCE S19°21'14"W 177.66'; THENCE S57°46'47"E 1151.27'; THENCE S61°20'15"E 151.81' TO A POINT ON THE EAST LINE OF THE NE 1/4 OF SAID SECTION 32, WHICH BEARS N00°03'00"W 59.67' FROM THE EAST 1/4 CORNER OF SAID SECTION. THE SIDE LINES OF SAID DESCRIBED RIGHT-OF-WAY BEING SHORTENED OR ELONGATED TO MEET THE GRANTOR'S PROPERTY LINES. BASIS OF BEARINGS IS THE EAST LINE OF THE NE 1/4 OF SECTION 32, WHICH IS ASSUMED FROM G.L.O. INFORMATION TO BEAR S0°03'E. CONTAINS 1.121 ACRES MORE OR LESS.

SURFACE USE DESCRIPTION LINDSAY RUSSELL #1-32B4

BEGINNING AT A POINT IN THE NE 1/4 OF SECTION 32, T2S, R4W, U.S.B.&M. WHICH BEARS S51°48'17"W 1883.08' FROM THE NORTHEAST CORNER OF SAID SECTION 32, THENCE N06°11'05"E 24.65'; THENCE N41°23'03"E 153.48'; THENCE N73°56'44"E 66.28'; THENCE S77°26'06"E 260.54'; THENCE N76°14'40"E 94.08'; THENCE N58°08'41"E 237.63'; THENCE S32°29'28"E 237.00'; THENCE S65°37'37"W 182.28'; THENCE S22°22'45"W 390.26'; THENCE S26°05'33"W 191.37'; THENCE N68°16'54"W 456.57'; THENCE N26°18'57"W 114.60'; THENCE N06°11'05"E 288.76' TO THE POINT OF BEGINNING. BASIS OF BEARINGS IS THE EAST LINE OF THE NE 1/4 OF SECTION 32, WHICH IS ASSUMED FROM G.L.O. INFORMATION TO BEAR S0°03'E. CONTAINS 9.186 ACRES MORE OR LESS.

SURFACE USE DESCRIPTION LINDSAY RUSSELL #2-32B4

BEGINNING AT A POINT IN THE NE 1/4 OF SECTION 32, T2S, R4W, U.S.B.&M. WHICH BEARS N58°25'39"W 1519.13' FROM THE EAST 1/4 CORNER OF SAID SECTION, THENCE S58°12'26"E 173.06'; THENCE S28°11'54"W 316.24'; THENCE N71°32'45"W 302.80'; THENCE N32°33'25"E 342.68'; THENCE N16°10'05"W 63.95'; THENCE S58°12'26"E 144.67' TO THE POINT OF BEGINNING. BASIS OF BEARINGS IS THE EAST LINE OF THE NE 1/4 OF SECTION 32, WHICH IS ASSUMED FROM G.L.O. INFORMATION TO BEAR S0°03'E. CONTAINS 2.300 ACRES MORE OR LESS.

CERTIFICATE

THIS IS TO CERTIFY THAT THE ABOVE PLAT WAS PREPARED FROM FIELD NOTES OF ACTUAL SURVEYS MADE BY ME OR UNDER MY SUPERVISION AND THAT THE SAME ARE TRUE AND CORRECT TO THE BEST OF MY KNOWLEDGE AND BELIEF.

REGISTERED LAND SURVEYOR
REGISTRATION NO. 161319
STATE OF UTAH

Duchesne County Surveyor's File # 476

REVISED: 3-22-95 D.R.B.

UELS UINTAH ENGINEERING & LAND SURVEYING
PHONE: (801) 789-1017
85 SOUTH 200 EAST - VERNAL, UTAH 84078

SCALE: 1" = 300'	DATE SURVEYED: 2-2-95	DATE DRAWN: 2-7-95
SURVEYED BY: G.S. J.F.	DRAWN BY: D.R.B.	
WEATHER: COOL	FILE: 31360	

DRAWING NUMBER 476
SAFCO PRODUCTS • NEW HOPE, MINNESOTA REORDER BY PART NUMBER 6551