"AS-BUILT" PIPELINE RIGHT-OF-WAY CORRIDOR SURVEY FOR

EL PASO MIDSTREAM INVESTMENT COMPANY, LLC

HARVEST PIPELINE
PHASE 4 EXTENSION
SECTION 17
TOWNSHIP 3 SOUTH, RANGE 2 WEST
UINTAH SPECIAL BASE AND MERIDIAN

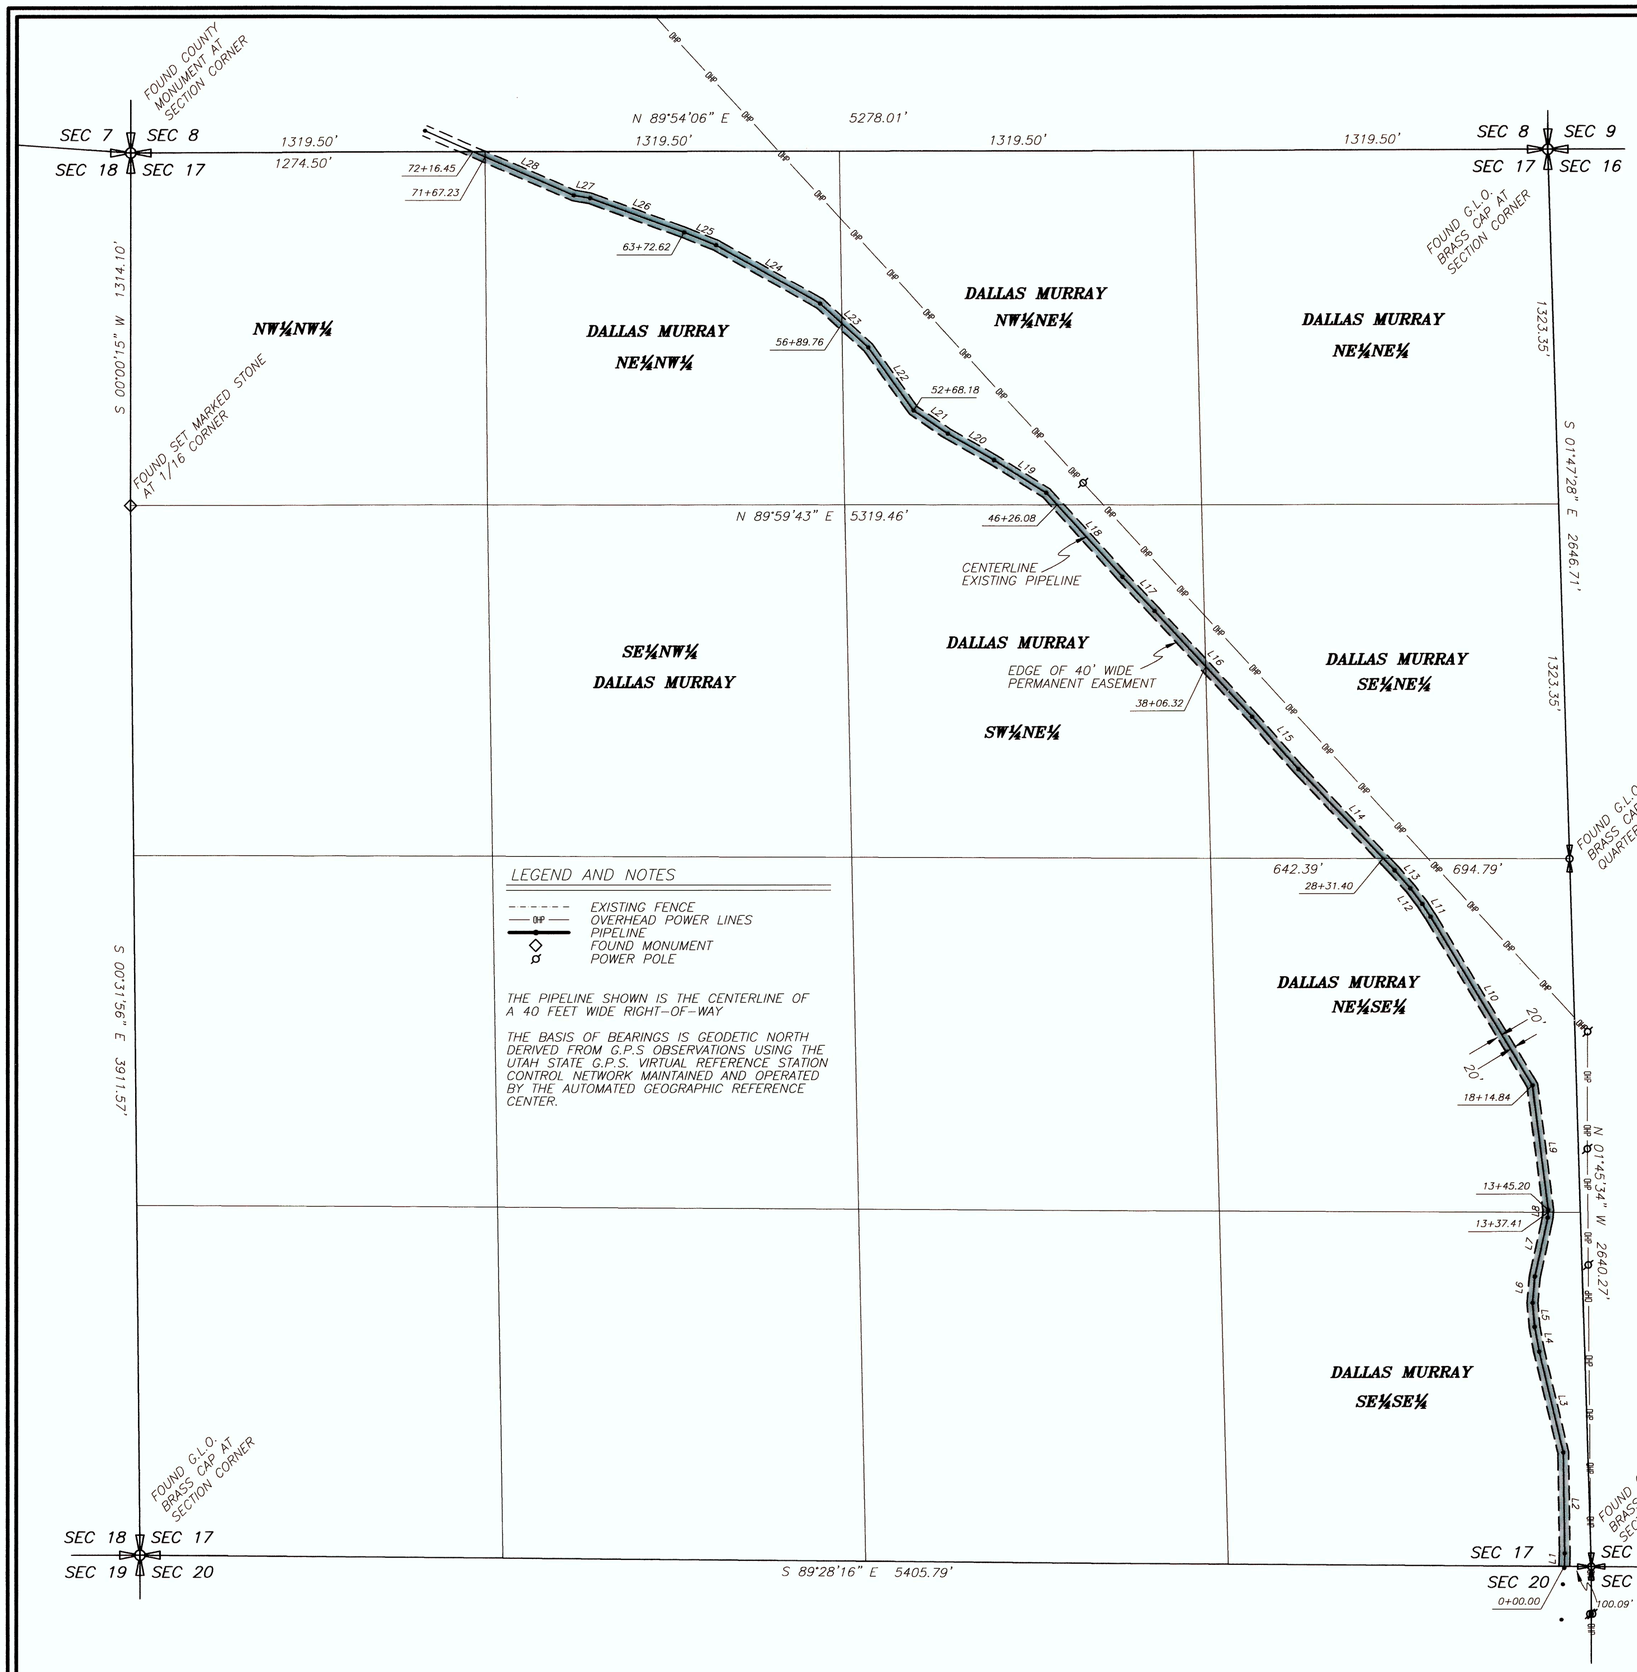

LINE	BEARING	DISTANCE
L1	N 01°47'25" E	47.79'
L2	N 00°51'36" W	376.11'
L3	N 13°24'09" W	386.54'
L4	N 10°28'26" W	94.44'
L5	N 04°45'58" W	90.09'
L6	N 04°56'48" E	98.31'
L7	N 12°19'34" E	223.71'
L8	N 04°16'00" E	28.21'
L9	N 07°12'29" W	469.64'
L10	N 31°04'20" W	734.96'
L11	N 33°11'03" W	56.28'
L12	N 37°40'27" W	73.70'
L13	N 41°06'35" W	89.27'
L14	N 43°28'21" W	520.97'
L15	N 41°20'33" W	260.47'
L16	N 42°37'43" W	537.57'
L17	N 43°11'38" W	174.32'
L18	N 42°15'37" W	423.81'
L19	N 57°55'07" W	228.98'
L20	N 60°17'00" W	198.33'
L21	N 55°46'52" W	154.68'
L22	N 35°45'15" W	289.43'
L23	N 47°37'04" W	242.30'
L24	N 60°41'25" W	444.42'
L25	N 68°08'24" W	128.29'
L26	N 69°59'40" W	372.67'
L27	N 80°04'11" W	61.87'
L28	N 66°32'48" W	409.28'

LEGEND AND NOTES

- EXISTING FENCE
- OHP — OVERHEAD POWER LINES
- PIPELINE
- FOUND MONUMENT
- POWER POLE

THE PIPELINE SHOWN IS THE CENTERLINE OF A 40 FEET WIDE RIGHT-OF-WAY

THE BASIS OF BEARINGS IS GEODETIC NORTH DERIVED FROM G.P.S OBSERVATIONS USING THE UTAH STATE G.P.S. VIRTUAL REFERENCE STATION CONTROL NETWORK MAINTAINED AND OPERATED BY THE AUTOMATED GEOGRAPHIC REFERENCE CENTER.

NORTH

SCALE: 1"=400'

0' 400' 800' 1200'

SURVEYOR'S CERTIFICATE

This is to certify that this plat was prepared from the field notes and electronic data collector files of an actual survey made by me, or under my personal supervision, of the pipeline corridor right-of-way shown hereon, and that the monuments indicated were found or set during said survey, and that this plat accurately represents said survey to the best of my knowledge.

PROFESSIONAL LAND SURVEYOR
No. 148951
JERRY D. ALLRED
9 AUG 12
STATE OF UTAH

Jerry D. Allred, Professional Land Surveyor, Certificate 148951 (Utah)

COUNTY SURVEYOR'S FILE NO. 2624

JERRY D. ALLRED AND ASSOCIATES
SURVEYING CONSULTANTS
1235 NORTH 700 EAST--P.O. BOX 975
DUCHESNE, UTAH 84021
(435) 738-5352

HARVEST 5
9 AUG 2012 12-121-011