REORDER BY PART NUMBER 6551
FOUR INCH ZONE OF FROM L OR I INCH LINE

BOUNDARY LINE AGREEMENT FOR

CRAIG NACCARATO

SECTION 4 TOWNSHIP 1 SOUTH, RANGE 8 WEST, UINTAH SPECIAL BASE AND MERIDIAN

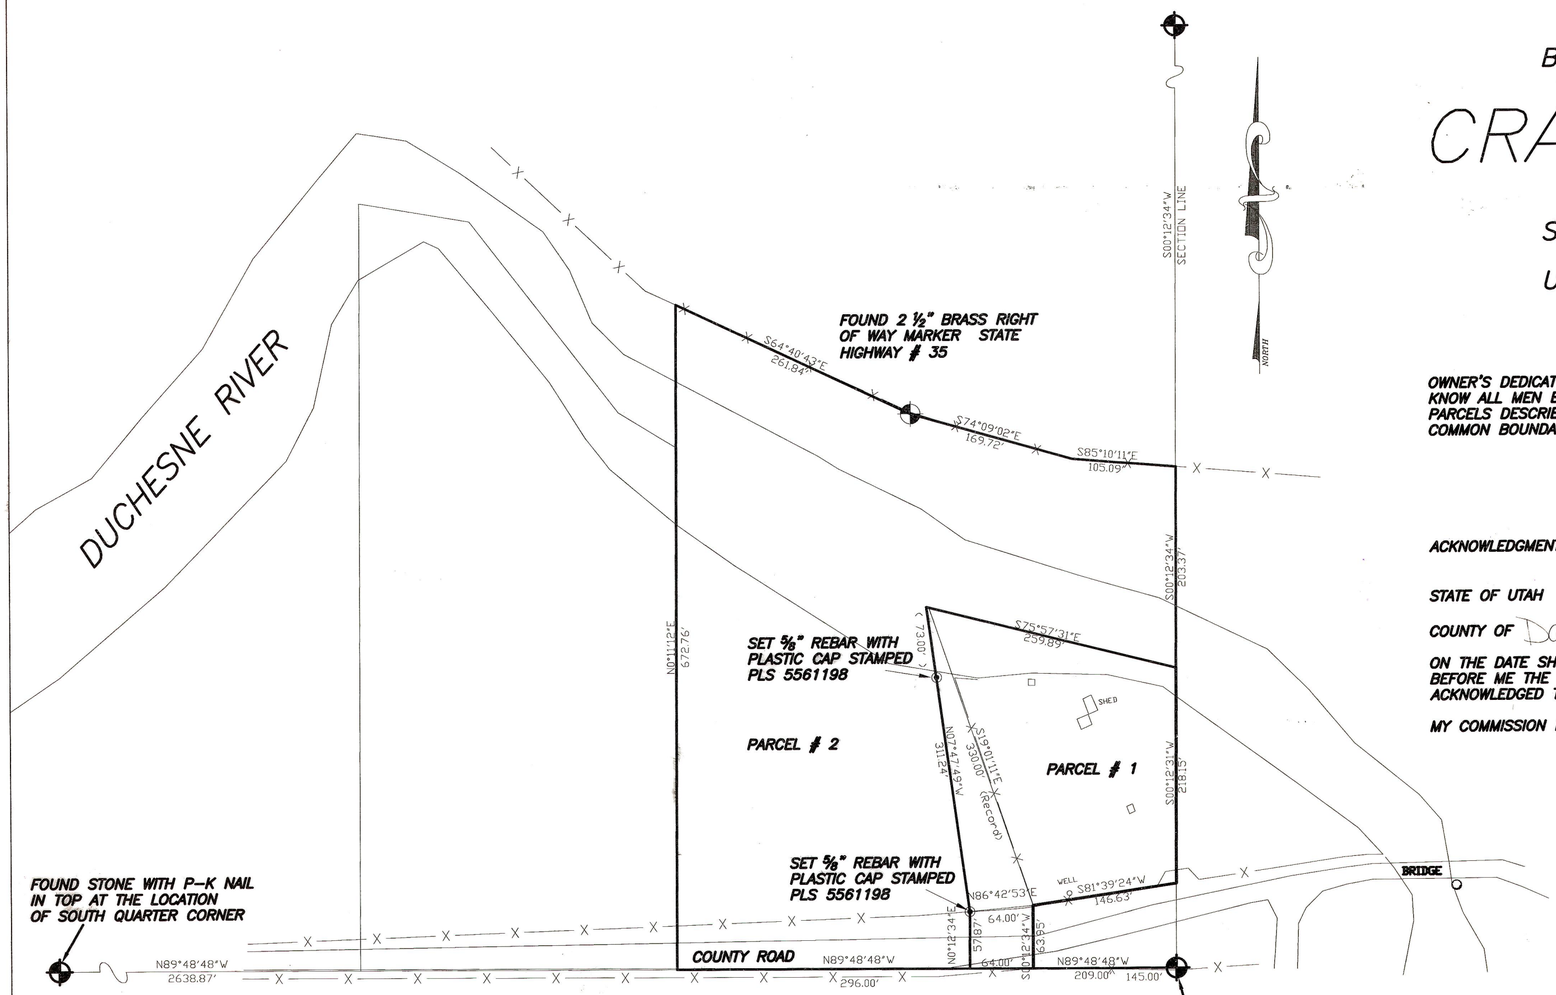

OWNER'S DEDICATION
KNOW ALL MEN BY THESE PRESENTED: THAT WE THE UNDERSIGNED, WARRANT OWNERSHIP OF PARCELS DESCRIBED BELOW, AND DO HEREBY ESTABLISH AND AGREE ON AND PLACE OUR COMMON BOUNDARY LINE BETWEEN OUR INDIVIDUAL PROPERTIES AS SHOWN ON THIS PLAT.

ACKNOWLEDGMENT

STATE OF UTAH }
COUNTY OF Davis } SS

ON THE DATE SHOWN BY EACH SIGNATURE, PERSONALLY APPEARED BEFORE ME THE SIGNER OF THE ABOVE DEDICATION WHO DULY ACKNOWLEDGED TO ME THAT THEY DID EXECUTE THE SAME.

MY COMMISSION EXPIRES June 25 2007

Dean C Romney
NOTARY PUBLIC

Craig Naccarato
CRAIG NACCARATO

Mark Lowell Michie
MARK LOWELL MICHIE, TRUSTEE

PARCEL # 1
BEGINNING AT A POINT WHICH IS 145.00 FEET, N 89°48'48" W; FROM THE SOUTHEAST SECTION CORNER OF SECTION 4, THENCE N 89°48'48" W, 64.00 FEET; THENCE N 0°12'34"E, 57.87 FEET; THENCE N 7°47'49"W, 311.24 FEET TO THE CENTER OF THE DUCHESNE RIVER; THENCE S 75°57'31" E, 259.89 FEET ALONG THE RIVER; THENCE S 0°12'34" W, 218.16 FEET ALONG THE EAST SECTION LINE OF SAID SECTION 4; THENCE S 81°39'24" W, 146.63 FEET; THENCE S 0°12'34" W, 63.95 FEET TO THE POINT OF BEGINNING.
CONTAINING ~~57,965~~ 48 SQUARE FEET, 1.~~33~~ 34 ACRES

PARCEL # 2
BEGINNING AT A POINT WHICH IS 209.00 FEET N 89°48'48" W, FROM THE SOUTHEAST SECTION CORNER OF SECTION 4, THENCE N 89°48'48"W, 296.00 FEET; THENCE N 0°11'12" E, 672.76 FEET TO THE SOUTH RIGHT WAY LINE OF STATE ROAD # 35; THENCE S 64°40'43" E, 261.84 FEET TO A 2 ½"BRASS RIGHT OF WAY MARKER; THENCE S 74°09'02" E, 169.72 FEET; THENCE S 85°10'11" E, 105.09 FEET ALONG RIGHT OF WAY LINE OF SAID HIGHWAY; THENCE S 0°12'34" W, 203.37 FEET ALONG THE EAST SECTION LINE TO THE DUCHESNE RIVER; THENCE N 75°57'31" W, 259.89 FEET; THENCE S 7°47'49" E, 311.24 FEET; THENCE S 0°12'34" W, 57.87 FEET TO THE POINT OF BEGINNING;
CONTAINING ~~240,975~~ SQUARE FEET. ~~5.53~~ ACRES 4.88

NARRATIVE
THIS SURVEY WAS PREFORMED AT THE REQUEST OF MR. CRAIG NACCARATO FOR THE PURPOSE OF PLACING A TRAILER IN THE ACQUIRED PROPERTY FROM MR. MICHIE,

Michael A. Hyde
DUCHESNE COUNTY PLANNING DIRECTOR

SURVEYOR'S CERTIFICATE

This is to certify that I have surveyed the parcel of land shown on this plat, and that the monuments indicated were found or set during said survey, and that this plat accurately represents said survey to the best of my knowledge.

PROFESSIONAL LAND SURVEYOR
No. 5561198
RODNEY N. ROWLEY
STATE OF UTAH

RODNEY N ROWLEY , PLS
Certificate No. 5561198 , (Utah)

COUNTY RECORDER CERTIFICATE

STATE OF UTAH }
COUNTY OF DUCHESNE } SS

THIS IS TO CERTIFY THAT THIS PLAT WAS FILED FOR RECORDING IN THE COUNTY RECORDER'S OFFICE ON THE _____ DAY OF _____ 20 _____ AT _____ O'CLOCK AND IS DULY RECORDED

BOOK _____ PAGE _____

FILING NUMBER _____

DUCHESNE COUNTY RECORDER

County Surveyor File # 1682

R.N.R. LAND SURVEYING
P.O. Box 250
Duchesne, Utah 84021
435-823-5556 435-738-2607

DRAWN BY:	RR
SCALE:	1" = 100
DATE:	09 MAY 2005
JOB NUMBER	2005-03