KINDER MORGAN ALTAMONT LLC.

AS-BUILT PIPELINE RIGHT-OF-WAY ON ALLRED CONSTRUCTION AND LANDSCAPING LLC.

(FEE GAP #18E)

Located in the SW 1/4 SE 1/4 of Section 9, T2S, R1W, U.S.B.&M. Duchesne County, Utah

EXHIBIT A

SCALE: 80' 40' 0' 80'

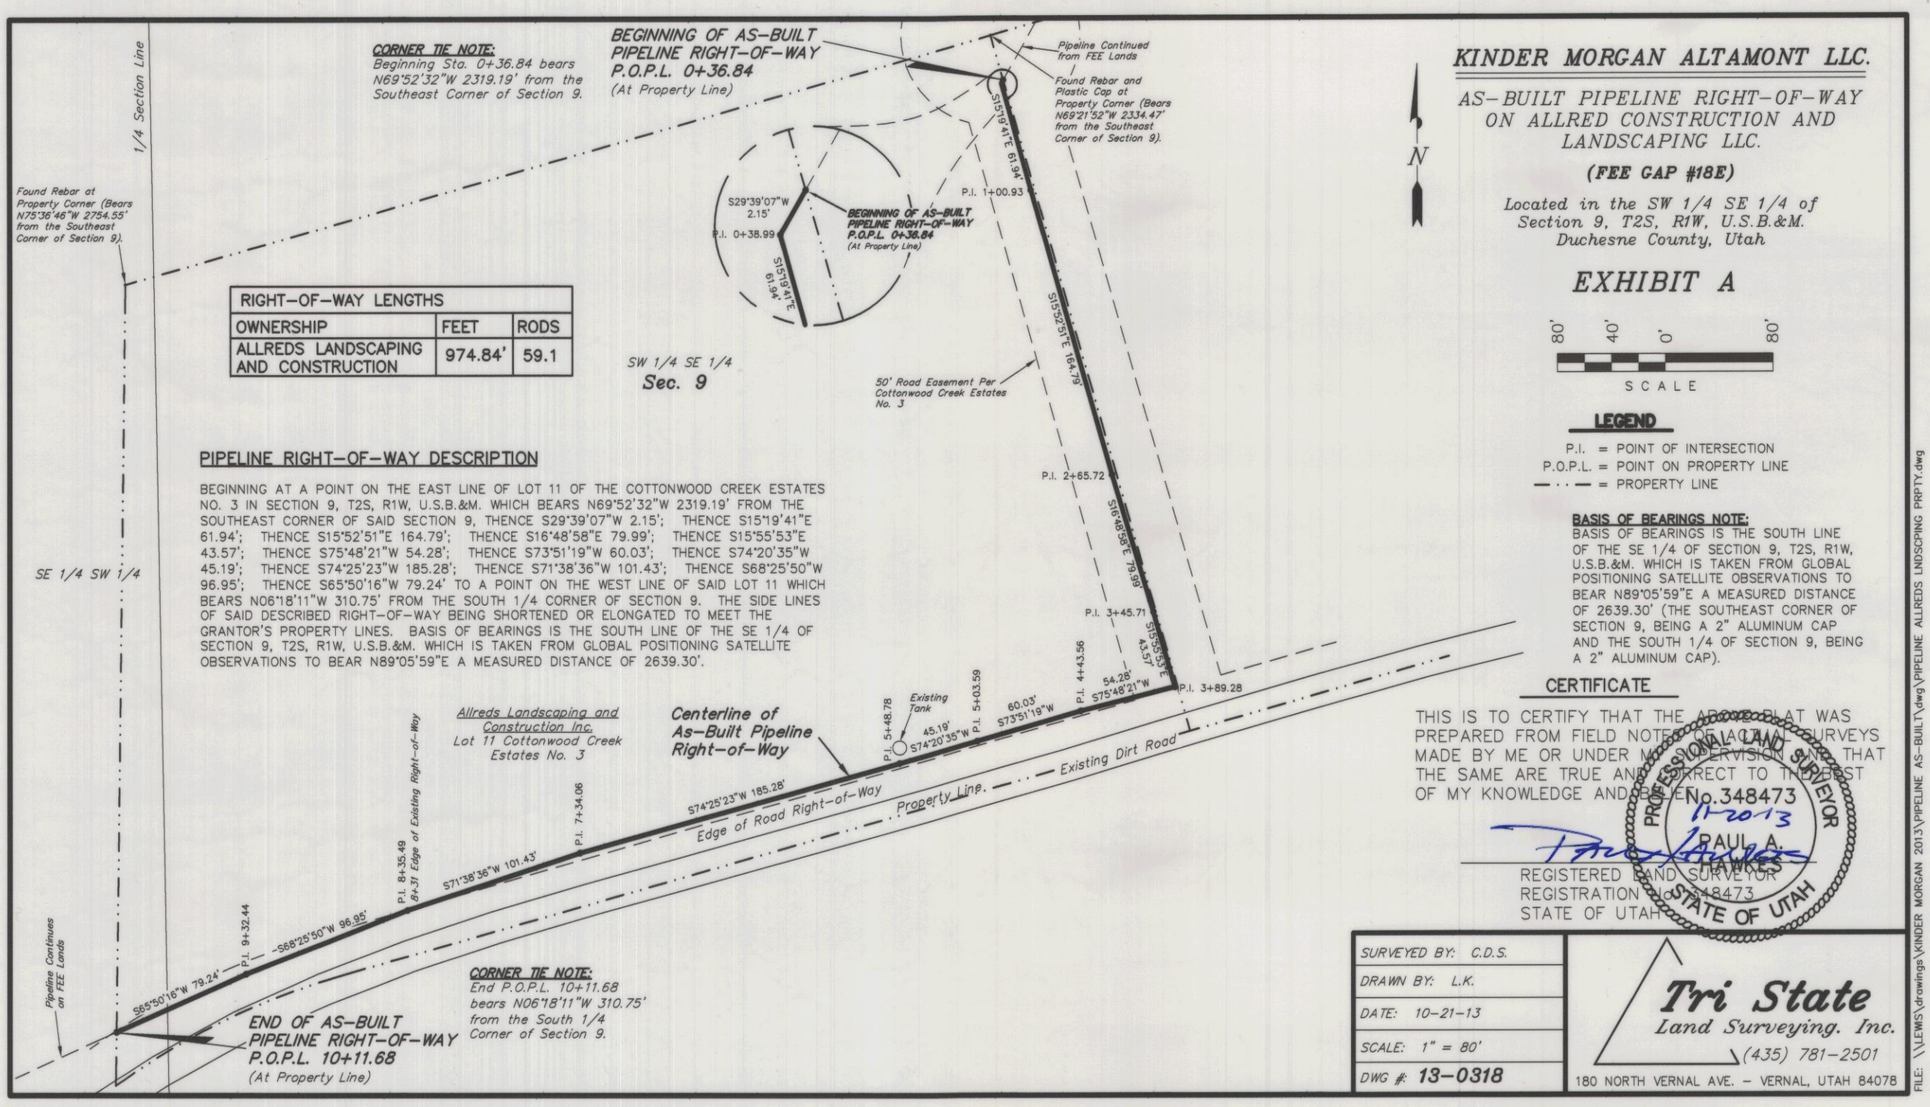

RIGHT-OF-WAY LENGTHS		
OWNERSHIP	FEET	RODS
ALLREDS LANDSCAPING AND CONSTRUCTION	974.84'	59.1

PIPELINE RIGHT-OF-WAY DESCRIPTION

BEGINNING AT A POINT ON THE EAST LINE OF LOT 11 OF THE COTTONWOOD CREEK ESTATES NO. 3 IN SECTION 9, T2S, R1W, U.S.B.&M. WHICH BEARS N69°52'32"W 2319.19' FROM THE SOUTHEAST CORNER OF SAID SECTION 9, THENCE S29°39'07"W 2.15'; THENCE S15°19'41"E 61.94'; THENCE S15°52'51"E 164.79'; THENCE S16°48'58"E 79.99'; THENCE S15°55'53"E 43.57'; THENCE S75°48'21"W 54.28'; THENCE S73°51'19"W 60.03'; THENCE S74°20'35"W 45.19'; THENCE S74°25'23"W 185.28'; THENCE S71°38'36"W 101.43'; THENCE S68°25'50"W 96.95'; THENCE S65°50'16"W 79.24' TO A POINT ON THE WEST LINE OF SAID LOT 11 WHICH BEARS N06°18'11"W 310.75' FROM THE SOUTH 1/4 CORNER OF SECTION 9. THE SIDE LINES OF SAID DESCRIBED RIGHT-OF-WAY BEING SHORTENED OR ELONGATED TO MEET THE GRANTOR'S PROPERTY LINES. BASIS OF BEARINGS IS THE SOUTH LINE OF THE SE 1/4 OF SECTION 9, T2S, R1W, U.S.B.&M. WHICH IS TAKEN FROM GLOBAL POSITIONING SATELLITE OBSERVATIONS TO BEAR N89°05'59"E A MEASURED DISTANCE OF 2639.30'.

LEGEND

P.I. = POINT OF INTERSECTION
P.O.P.L. = POINT ON PROPERTY LINE
— · · — = PROPERTY LINE

BASIS OF BEARINGS NOTE:
BASIS OF BEARINGS IS THE SOUTH LINE OF THE SE 1/4 OF SECTION 9, T2S, R1W, U.S.B.&M. WHICH IS TAKEN FROM GLOBAL POSITIONING SATELLITE OBSERVATIONS TO BEAR N89°05'59"E A MEASURED DISTANCE OF 2639.30' (THE SOUTHEAST CORNER OF SECTION 9, BEING A 2" ALUMINUM CAP AND THE SOUTH 1/4 OF SECTION 9, BEING A 2" ALUMINUM CAP).

CERTIFICATE

THIS IS TO CERTIFY THAT THE ABOVE PLAT WAS PREPARED FROM FIELD NOTES OF ACTUAL SURVEYS MADE BY ME OR UNDER MY SUPERVISION AND THAT THE SAME ARE TRUE AND CORRECT TO THE BEST OF MY KNOWLEDGE AND BELIEF.

PROFESSIONAL LAND SURVEYOR No. 348473 11-20-13 PAUL A. LAWKES STATE OF UTAH

REGISTERED LAND SURVEYOR
REGISTRATION No. 348473
STATE OF UTAH

SURVEYED BY: C.D.S.	
DRAWN BY: L.K.	
DATE: 10-21-13	
SCALE: 1" = 80'	
DWG #: 13-0318	

Tri State Land Surveying, Inc.
(435) 781-2501
180 NORTH VERNAL AVE. - VERNAL, UTAH 84078

FILE: \\LEWS\drawings\KINDER MORGAN 2013\PIPELINE AS-BUILT\dwg\PIPELINE ALLREDS LNDSCPING PRPTY.dwg

KINDER MORGAN ALTAMONT LLC.

AS-BUILT PIPELINE RIGHT-OF-WAY ON ROOSEVELT CITY

(FEE GAP #21B)

Located in Section 16, T2S, R1W, U.S.B.&M. Duchesne County, Utah

EXHIBIT A

SCALE: 200' 100' 0' 200'

BASIS OF BEARINGS NOTE:
BASIS OF BEARINGS IS THE NORTH LINE OF THE NE 1/4 OF SECTION 16, T2S, R1W, U.S.B.&M. WHICH IS TAKEN FROM GLOBAL POSITIONING SATELLITE OBSERVATIONS TO BEAR S89°05'59"W A MEASURED DISTANCE OF 2639.30' (THE NORTHEAST CORNER OF SECTION 16, BEING A 2" ALUMINUM CAP AND THE NORTH 1/4 OF SECTION 9, BEING A 2" ALUMINUM CAP).

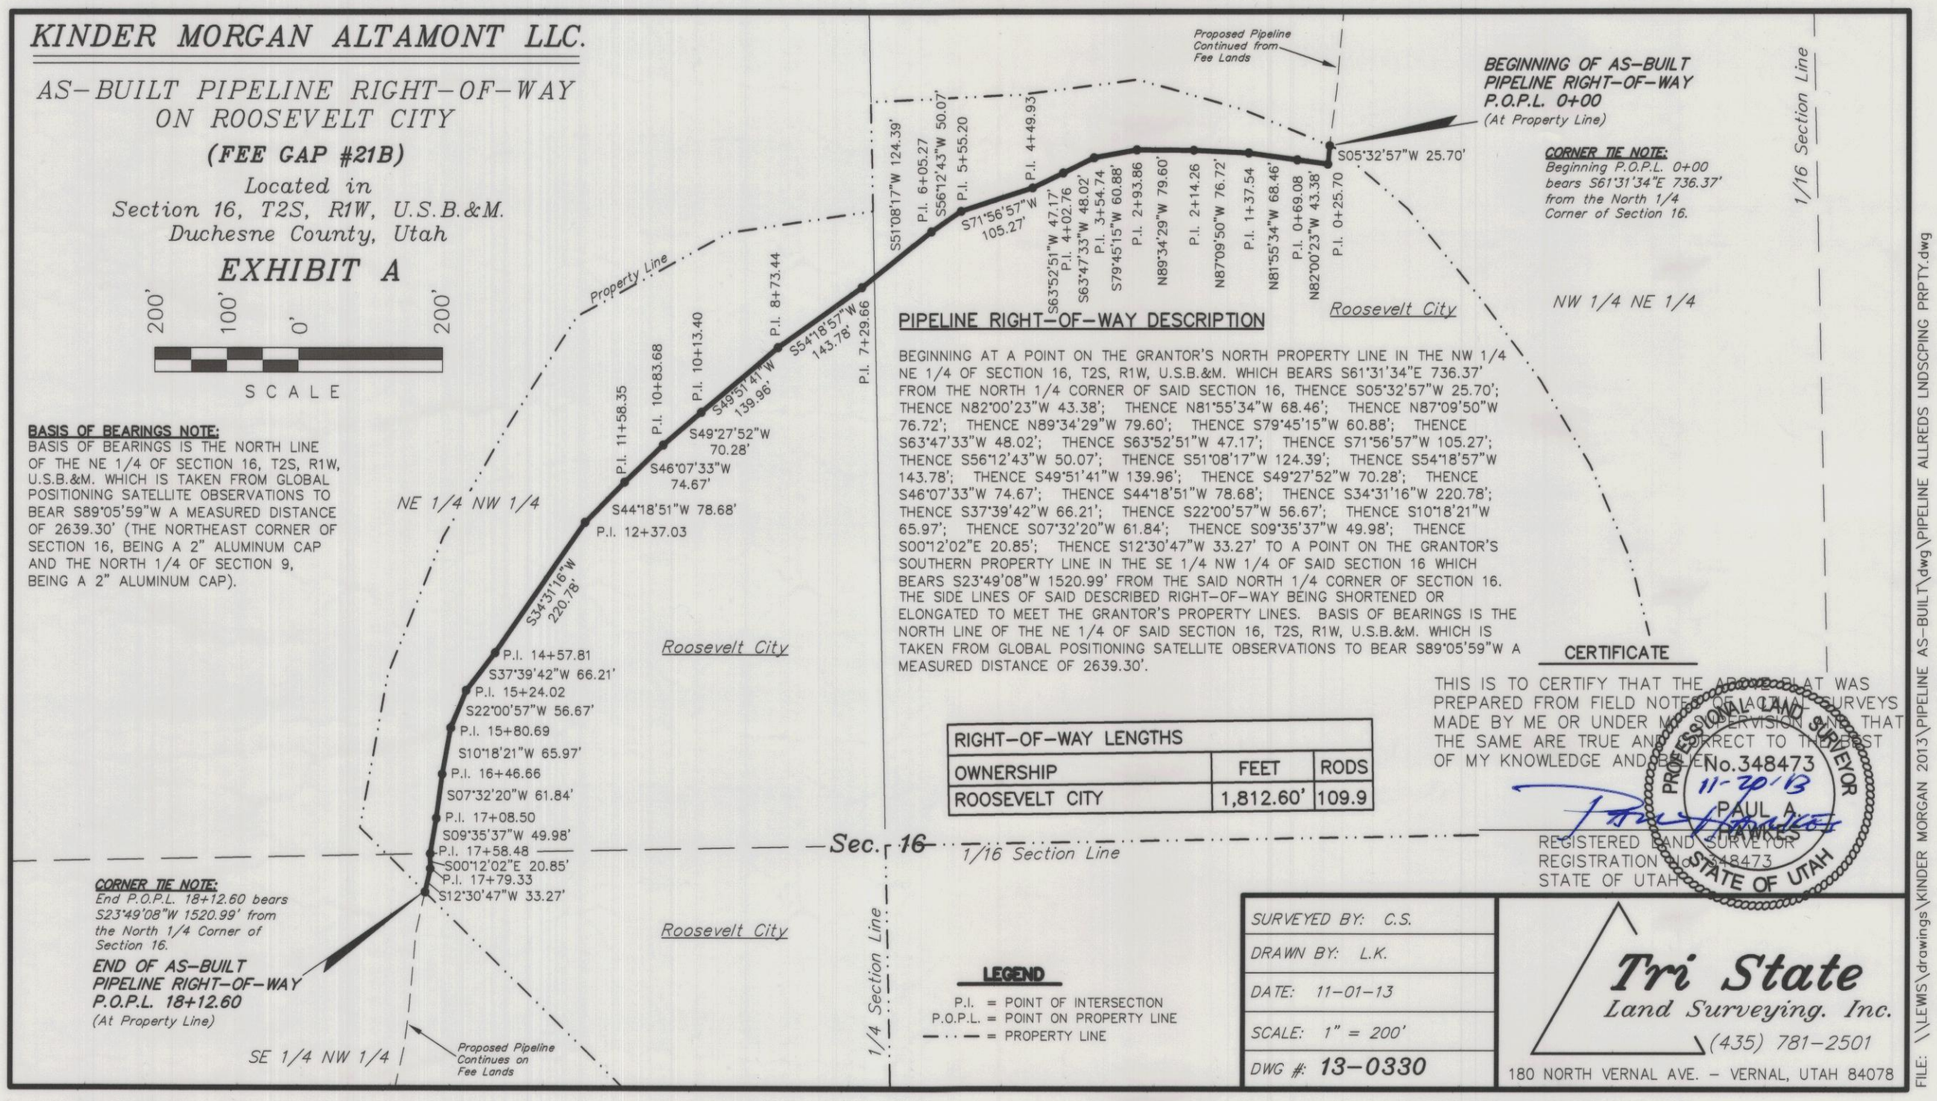

RIGHT-OF-WAY LENGTHS		
OWNERSHIP	FEET	RODS
ROOSEVELT CITY	1,812.60'	109.9

PIPELINE RIGHT-OF-WAY DESCRIPTION

BEGINNING AT A POINT ON THE GRANTOR'S NORTH PROPERTY LINE IN THE NW 1/4 NE 1/4 OF SECTION 16, T2S, R1W, U.S.B.&M. WHICH BEARS S61°31'34"E 736.37' FROM THE NORTH 1/4 CORNER OF SAID SECTION 16, THENCE S05°32'57"W 25.70'; THENCE N82°00'23"W 43.38'; THENCE N81°55'34"W 68.46'; THENCE N87°09'50"W 76.72'; THENCE N89°34'29"W 79.60'; THENCE S79°45'15"W 60.88'; THENCE S63°47'33"W 48.02'; THENCE S63°52'51"W 47.17'; THENCE S71°56'57"W 105.27'; THENCE S56°12'43"W 50.07'; THENCE S51°08'17"W 124.39'; THENCE S54°18'57"W 143.78'; THENCE S49°51'41"W 139.96'; THENCE S49°27'52"W 70.28'; THENCE S46°07'33"W 74.67'; THENCE S44°18'51"W 78.68'; THENCE S34°31'16"W 220.78'; THENCE S37°39'42"W 66.21'; THENCE S22°00'57"W 56.67'; THENCE S10°18'21"W 65.97'; THENCE S07°32'20"W 61.84'; THENCE S09°35'37"W 49.98'; THENCE S00°12'02"E 20.85'; THENCE S12°30'47"W 33.27' TO A POINT ON THE GRANTOR'S SOUTHERN PROPERTY LINE IN THE SE 1/4 NW 1/4 OF SAID SECTION 16 WHICH BEARS S23°49'08"W 1520.99' FROM THE SAID NORTH 1/4 CORNER OF SECTION 16. THE SIDE LINES OF SAID DESCRIBED RIGHT-OF-WAY BEING SHORTENED OR ELONGATED TO MEET THE GRANTOR'S PROPERTY LINES. BASIS OF BEARINGS IS THE NORTH LINE OF THE NE 1/4 OF SAID SECTION 16, T2S, R1W, U.S.B.&M. WHICH IS TAKEN FROM GLOBAL POSITIONING SATELLITE OBSERVATIONS TO BEAR S89°05'59"W A MEASURED DISTANCE OF 2639.30'.

LEGEND

P.I. = POINT OF INTERSECTION
P.O.P.L. = POINT ON PROPERTY LINE
— · · — = PROPERTY LINE

CERTIFICATE

THIS IS TO CERTIFY THAT THE ABOVE PLAT WAS PREPARED FROM FIELD NOTES OF ACTUAL SURVEYS MADE BY ME OR UNDER MY SUPERVISION AND THAT THE SAME ARE TRUE AND CORRECT TO THE BEST OF MY KNOWLEDGE AND BELIEF.

PROFESSIONAL LAND SURVEYOR No. 348473 11-20-13 PAUL A. LAWKES STATE OF UTAH

REGISTERED LAND SURVEYOR
REGISTRATION No. 348473
STATE OF UTAH

SURVEYED BY: C.S.	
DRAWN BY: L.K.	
DATE: 11-01-13	
SCALE: 1" = 200'	
DWG #: 13-0330	

Tri State Land Surveying, Inc.
(435) 781-2501
180 NORTH VERNAL AVE. - VERNAL, UTAH 84078

FILE: \\LEWS\drawings\KINDER MORGAN 2013\PIPELINE AS-BUILT\dwg\PIPELINE ALLREDS LNDSCPING PRPTY.dwg

COUNTY SURVEYOR'S FILE # 2872