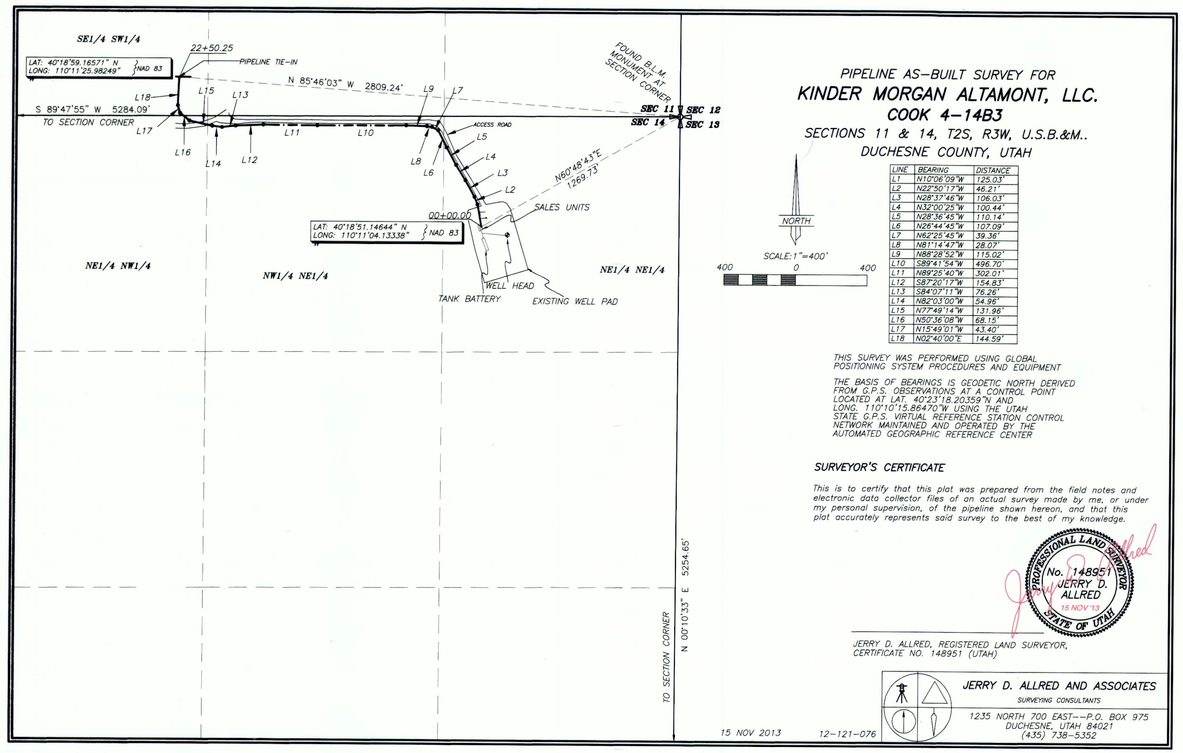

PIPELINE AS-BUILT SURVEY FOR

KINDER MORGAN ALTAMONT, LLC.

COOK 4-14B3

SECTIONS 11 & 14, T2S, R3W, U.S.B.&M..

DUCHESNE COUNTY, UTAH

LINE	BEARING	DISTANCE
L2	N22°50'17"W	46.21'
L4	N32°00'25"W	100.44'
L5	N28°36'45"W	110.14'
L6	N26°44'45"W	107.09'
L7	N62°25'45"W	39.36'
L8	N81°14'47"W	28.07'
L9	N88°28'52"W	115.02'
L10	S89°41'54"W	496.70'
L11	N89°25'40"W	302.01'
L12	S87°20'17"W	154.83'
L13	S84°07'11"W	75.26'
L14	N82°03'00"W	54.96'
L15	N77°49'14"W	131.96'
L16	N50°36'08"W	68.15'
L17	N15°49'01"W	43.40'
L18	N02°40'00"E	144.59'

THIS SURVEY WAS PERFORMED USING GLOBAL POSITIONING SYSTEM PROCEDURES AND EQUIPMENT

THE BASIS OF BEARINGS IS GEODETIC NORTH DERIVED FROM G.P.S. OBSERVATIONS AT A CONTROL POINT LOCATED AT LAT. 40°2'3"18.20359"N AND LONG. 110°10'15.86470"W USING THE UTAH STATE G.P.S. VIRTUAL REFERENCE STATION CONTROL NETWORK MAINTAINED AND OPERATED BY THE AUTOMATED GEOGRAPHIC REFERENCE CENTER

SURVEYOR'S CERTIFICATE

This is to certify that this plat was prepared from the field notes and electronic data collector files of an actual survey made by me, or under my personal supervision, of the pipeline shown hereon, and that this plat accurately represents said survey to the best of my knowledge.

PROFESSIONAL LAND SURVEYOR No. 148951 JERRY D. ALLRED 15 NOV '13 STATE OF UTAH

JERRY D. ALLRED, REGISTERED LAND SURVEYOR, CERTIFICATE NO. 148951 (UTAH)

JERRY D. ALLRED AND ASSOCIATES
SURVEYING CONSULTANTS
1235 NORTH 700 EAST--P.O. BOX 975
DUCHESNE, UTAH 84021
(435) 738-5352

15 NOV 2013 12-121-076

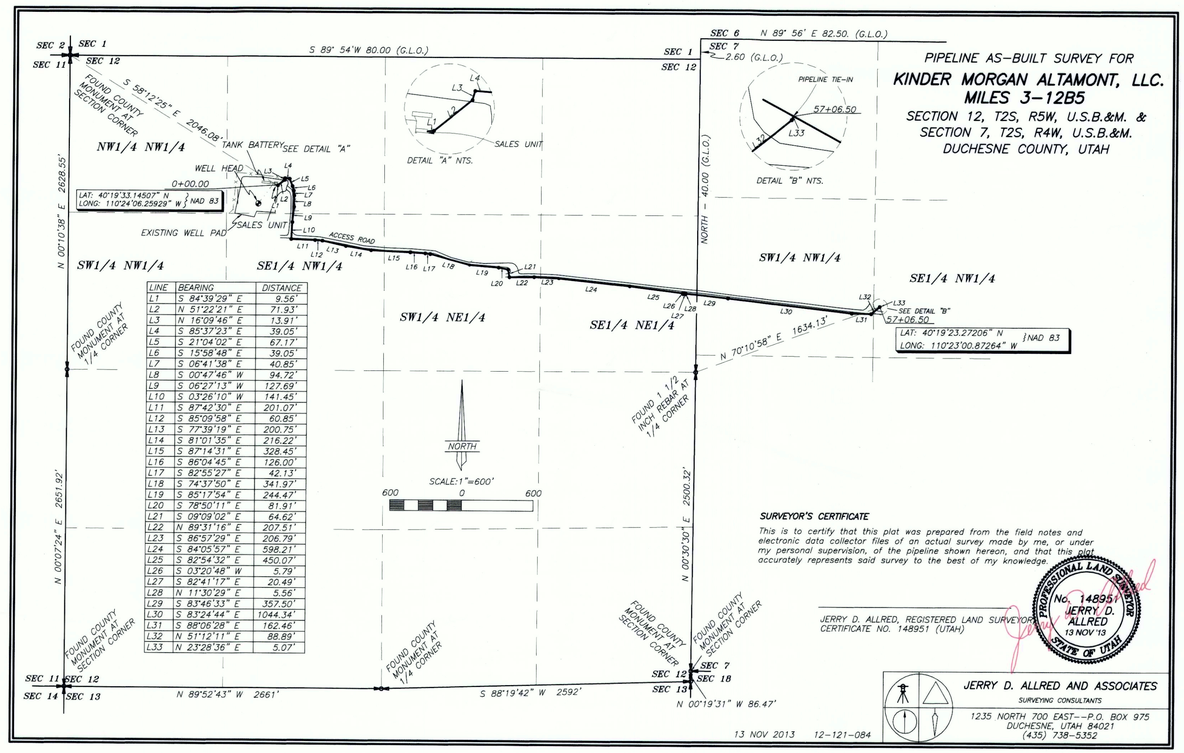

LINE	BEARING	DISTANCE
L1	S 84°39'29" E	9.56'
L2	N 51°22'21" E	71.93'
L3	N 16°09'46" E	13.91'
L4	S 85°37'23" E	39.05'
L5	S 21°04'02" E	67.17'
L6	S 15°58'48" E	39.05'
L7	S 06°41'38" E	40.85'
L8	S 00°47'46" W	94.72'
L9	S 06°27'13" W	127.69'
L10	S 03°26'10" W	141.45'
L11	S 87°42'30" E	201.07'
L12	S 85°09'58" E	60.85'
L13	S 77°39'19" E	200.75'
L14	S 81°01'35" E	216.22'
L15	S 87°14'31" E	328.45'
L16	S 86°04'45" E	126.00'
L17	S 82°55'27" E	42.13'
L18	S 74°37'50" E	341.97'
L19	S 85°17'54" E	244.47'
L20	S 78°50'11" E	81.91'
L21	S 09°09'02" E	64.62'
L22	N 89°31'16" E	207.51'
L23	S 86°57'29" E	206.79'
L24	S 84°05'57" E	598.21'
L25	S 82°54'32" E	450.07'
L26	S 03°20'48" W	5.79'
L27	S 82°41'17" E	20.49'
L28	N 11°30'29" E	5.56'
L29	S 83°46'33" E	357.50'
L30	S 83°24'44" E	1044.34'
L31	S 88°06'28" E	162.46'
L32	N 51°12'11" E	88.89'
L33	N 23°28'36" E	5.07'

PIPELINE AS-BUILT SURVEY FOR

KINDER MORGAN ALTAMONT, LLC.

MILES 3-12B5

SECTION 12, T2S, R5W, U.S.B.&M. & SECTION 7, T2S, R4W, U.S.B.&M.

DUCHESNE COUNTY, UTAH

SURVEYOR'S CERTIFICATE

This is to certify that this plat was prepared from the field notes and electronic data collector files of an actual survey made by me, or under my personal supervision, of the pipeline shown hereon, and that this plat accurately represents said survey to the best of my knowledge.

PROFESSIONAL LAND SURVEYOR No. 148951 JERRY D. ALLRED 13 NOV '13 STATE OF UTAH

JERRY D. ALLRED, REGISTERED LAND SURVEYOR, CERTIFICATE NO. 148951 (UTAH)

JERRY D. ALLRED AND ASSOCIATES
SURVEYING CONSULTANTS
1235 NORTH 700 EAST--P.O. BOX 975
DUCHESNE, UTAH 84021
(435) 738-5352

13 NOV 2013 12-121-084

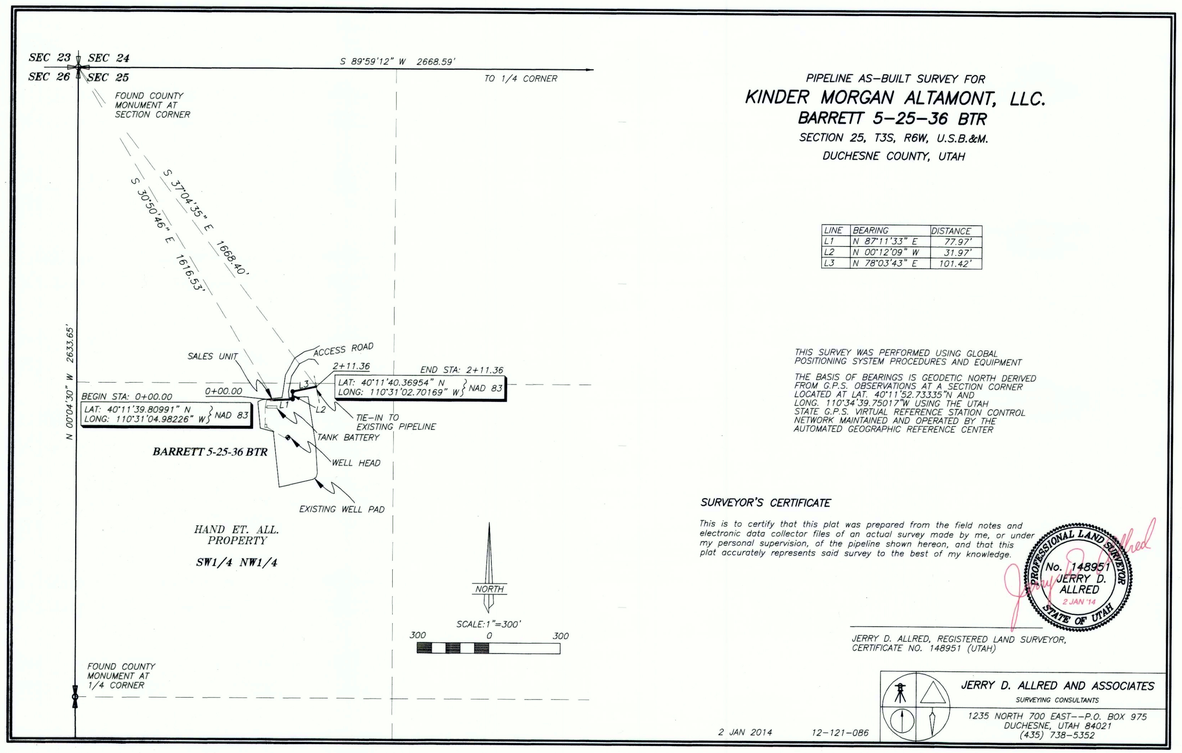

PIPELINE AS-BUILT SURVEY FOR

KINDER MORGAN ALTAMONT, LLC.

BARRETT 5-25-36 BTR

SECTION 25, T3S, R6W, U.S.B.&M.

DUCHESNE COUNTY, UTAH

LINE	BEARING	DISTANCE
L1	N 87°11'33" E	77.97'
L2	N 00°12'09" W	31.97'
L3	N 78°03'43" E	101.42'

THIS SURVEY WAS PERFORMED USING GLOBAL POSITIONING SYSTEM PROCEDURES AND EQUIPMENT

THE BASIS OF BEARINGS IS GEODETIC NORTH DERIVED FROM G.P.S. OBSERVATIONS AT A SECTION CORNER LOCATED AT LAT. 40°11'52.73335"N AND LONG. 110°34'39.75017"W USING THE UTAH STATE G.P.S. VIRTUAL REFERENCE STATION CONTROL NETWORK MAINTAINED AND OPERATED BY THE AUTOMATED GEOGRAPHIC REFERENCE CENTER

SURVEYOR'S CERTIFICATE

This is to certify that this plat was prepared from the field notes and electronic data collector files of an actual survey made by me, or under my personal supervision, of the pipeline shown hereon, and that this plat accurately represents said survey to the best of my knowledge.

PROFESSIONAL LAND SURVEYOR No. 148951 JERRY D. ALLRED 2 JAN '14 STATE OF UTAH

JERRY D. ALLRED, REGISTERED LAND SURVEYOR, CERTIFICATE NO. 148951 (UTAH)

JERRY D. ALLRED AND ASSOCIATES
SURVEYING CONSULTANTS
1235 NORTH 700 EAST--P.O. BOX 975
DUCHESNE, UTAH 84021
(435) 738-5352

2 JAN 2014 12-121-086

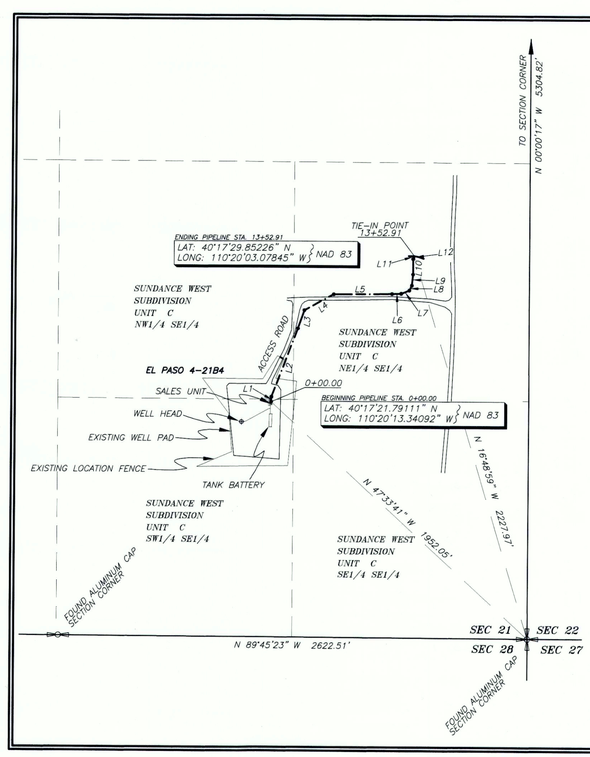

PIPELINE AS-BUILT SURVEY FOR

KINDER MORGAN ALTAMONT, LLC.

EL PASO 4-21B4

SECTION 21, T2S, R4W, U.S.B.&M.

DUCHESNE COUNTY, UTAH

LINE	BEARING	DISTANCE
L1	N 03°39'17" E	27.94'
L2	N 20°59'07" E	407.95'
L3	N 19°12'23" E	107.90'
L4	N 61°07'04" E	186.91'
L5	N 89°30'53" E	325.30'
L6	N 87°49'22" E	51.04'
L7	N 68°04'21" E	48.92'
L8	N 27°03'16" E	30.68'
L9	N 05°47'24" E	62.18'
L10	N 00°00'02" W	86.09'
L11	N 29°22'04" E	13.93'
L12	N 04°02'50" E	4.15'

SURVEYOR'S CERTIFICATE

This is to certify that this plat was prepared from the field notes and electronic data collector files of an actual survey made by me, or under my personal supervision, of the pipeline shown hereon, and that this plat accurately represents said survey to the best of my knowledge.

THIS SURVEY WAS PERFORMED USING GLOBAL POSITIONING SYSTEM PROCEDURES AND EQUIPMENT

THE BASIS OF BEARINGS IS GEODETIC NORTH DERIVED FROM G.P.S. OBSERVATIONS AT A SECTION CORNER LOCATED AT LAT. 40°21'33.56882"N AND LONG. 110°16'31.53266"W USING THE UTAH STATE G.P.S. VIRTUAL REFERENCE STATION CONTROL NETWORK MAINTAINED AND OPERATED BY THE AUTOMATED GEOGRAPHIC REFERENCE CENTER

PROFESSIONAL LAND SURVEYOR No. 148951 JERRY D. ALLRED 7 JAN '14 STATE OF UTAH

Jerry D. Allred, Professional Land Surveyor, Certificate 148951 (Utah)

JERRY D. ALLRED AND ASSOCIATES
SURVEYING CONSULTANTS
1235 NORTH 700 EAST--P.O. BOX 975
DUCHESNE, UTAH 84021
(435) 738-5352

7 JAN 2014 12-121-102

County Surveyors File # 2926