"AS-BUILT" SURVEY FOR

ELPASO E&P, CO.

KATHERINE 3-29B4

SECTIONS 29 AND 32, TOWNSHIP 2 SOUTH, RANGE 4 WEST

UINTAH SPECIAL BASE AND MERIDIAN

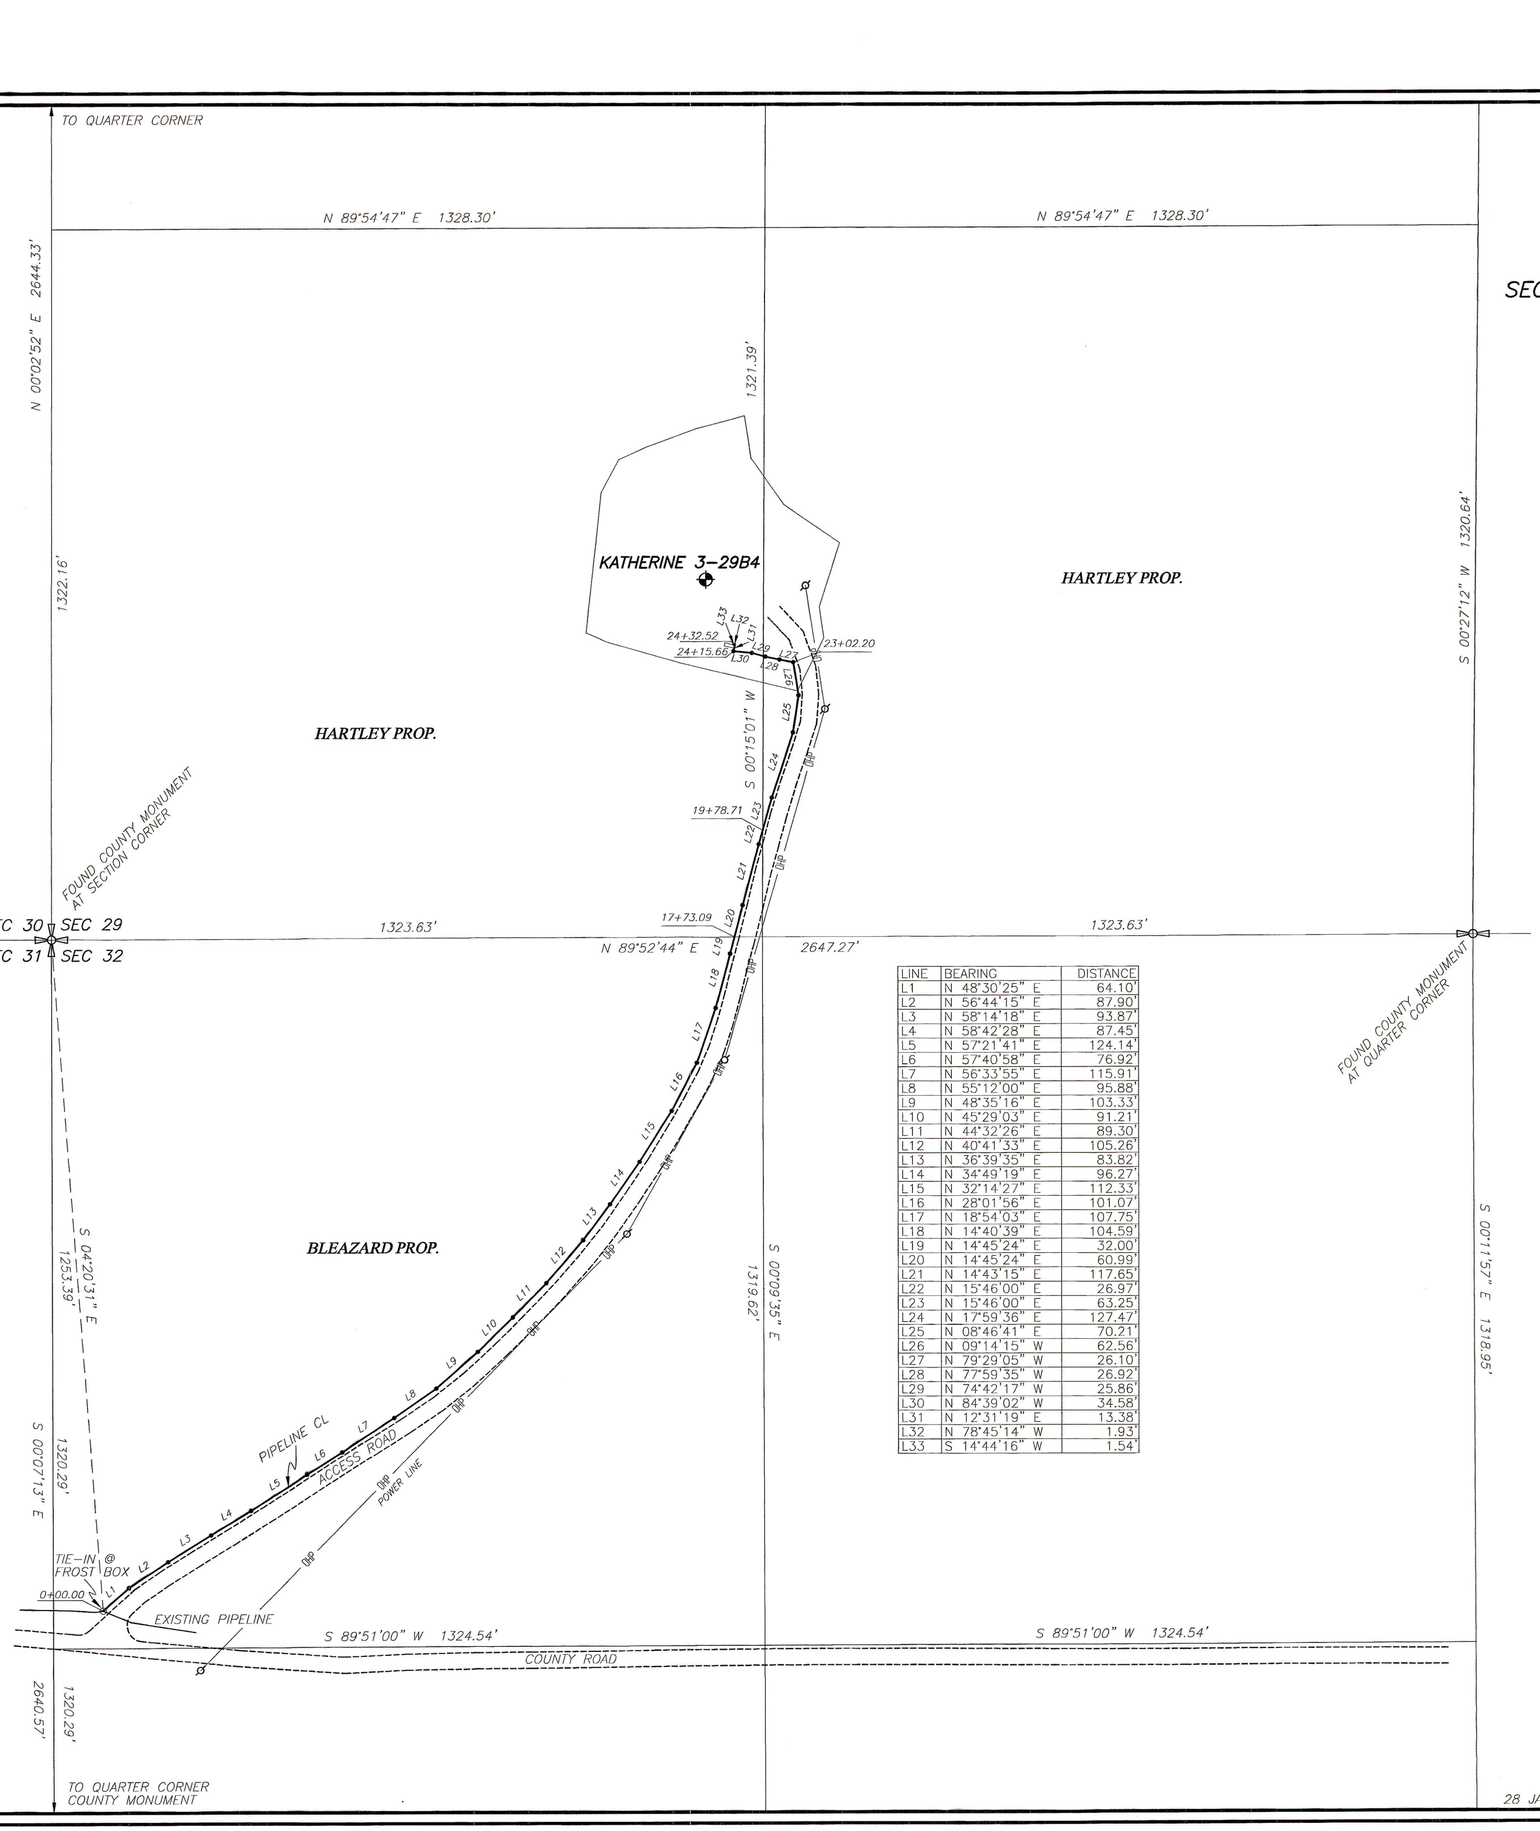

LINE	BEARING	DISTANCE
L1	N 48°30'25" E	64.10'
L2	N 56°44'15" E	87.90'
L3	N 58°14'18" E	93.87'
L4	N 58°42'28" E	87.45'
L5	N 57°21'41" E	124.14'
L6	N 57°40'58" E	76.92'
L7	N 56°33'55" E	115.91'
L8	N 55°12'00" E	95.88'
L9	N 48°35'16" E	103.33'
L10	N 45°29'03" E	91.21'
L11	N 44°32'26" E	89.30'
L12	N 40°41'33" E	105.26'
L13	N 36°39'35" E	83.82'
L14	N 34°49'19" E	96.27'
L15	N 32°14'27" E	112.33'
L16	N 28°01'56" E	101.07'
L17	N 18°54'03" E	107.75'
L18	N 14°40'39" E	104.59'
L19	N 14°45'24" E	32.00'
L20	N 14°45'24" E	60.99'
L21	N 14°43'15" E	117.65'
L22	N 15°46'00" E	26.97'
L23	N 15°46'00" E	63.25'
L24	N 17°59'36" E	127.47'
L25	N 08°46'41" E	70.21'
L26	N 09°14'15" W	62.56'
L27	N 79°29'05" W	26.10'
L28	N 77°59'35" W	26.92'
L29	N 74°42'17" W	25.86'
L30	N 84°39'02" W	34.58'
L31	N 12°31'19" E	13.38'
L32	N 78°45'14" W	1.93'
L33	S 14°44'16" W	1.54'

SCALE:1=200'

0' 200' 400' 600'

THE BASIS OF BEARINGS IS DERIVED FROM G.P.S. OBSERVATIONS

SURVEYOR'S CERTIFICATE

This is to certify that this plat was prepared from the field notes and electronic data collector files of an actual survey made by me, or under my personal supervision, of the location, pipeline and access road shown hereon, and that the monuments indicated were found or set during during said survey, and that this plat accurately represents said survey survey to the best of my knowledge.

PROFESSIONAL LAND SURVEYOR No. 148951 JERRY D. ALLRED STATE OF UTAH 2 Feb '10

Jerry D. Allred, Professional Land Surveyor, Certificate 148951 (Utah)

County Surveyor's file # 2210

JERRY D. ALLRED AND ASSOCIATES

SURVEYING CONSULTANTS

1235 NORTH 700 EAST--P.O. BOX 975

DUCHESNE, UTAH 84021

(435) 738-5352

28 JAN 2010 01-128-013