AS-BUILT SURVEY FOR

KINDER MORGAN ALTAMONT LLC

"KOCH PARALLEL LINE"

SECTIONS 8, 9, & 10
TOWNSHIP 3 SOUTH, RANGE 4 WEST
UINTAH SPECIAL BASE AND MERIDIAN

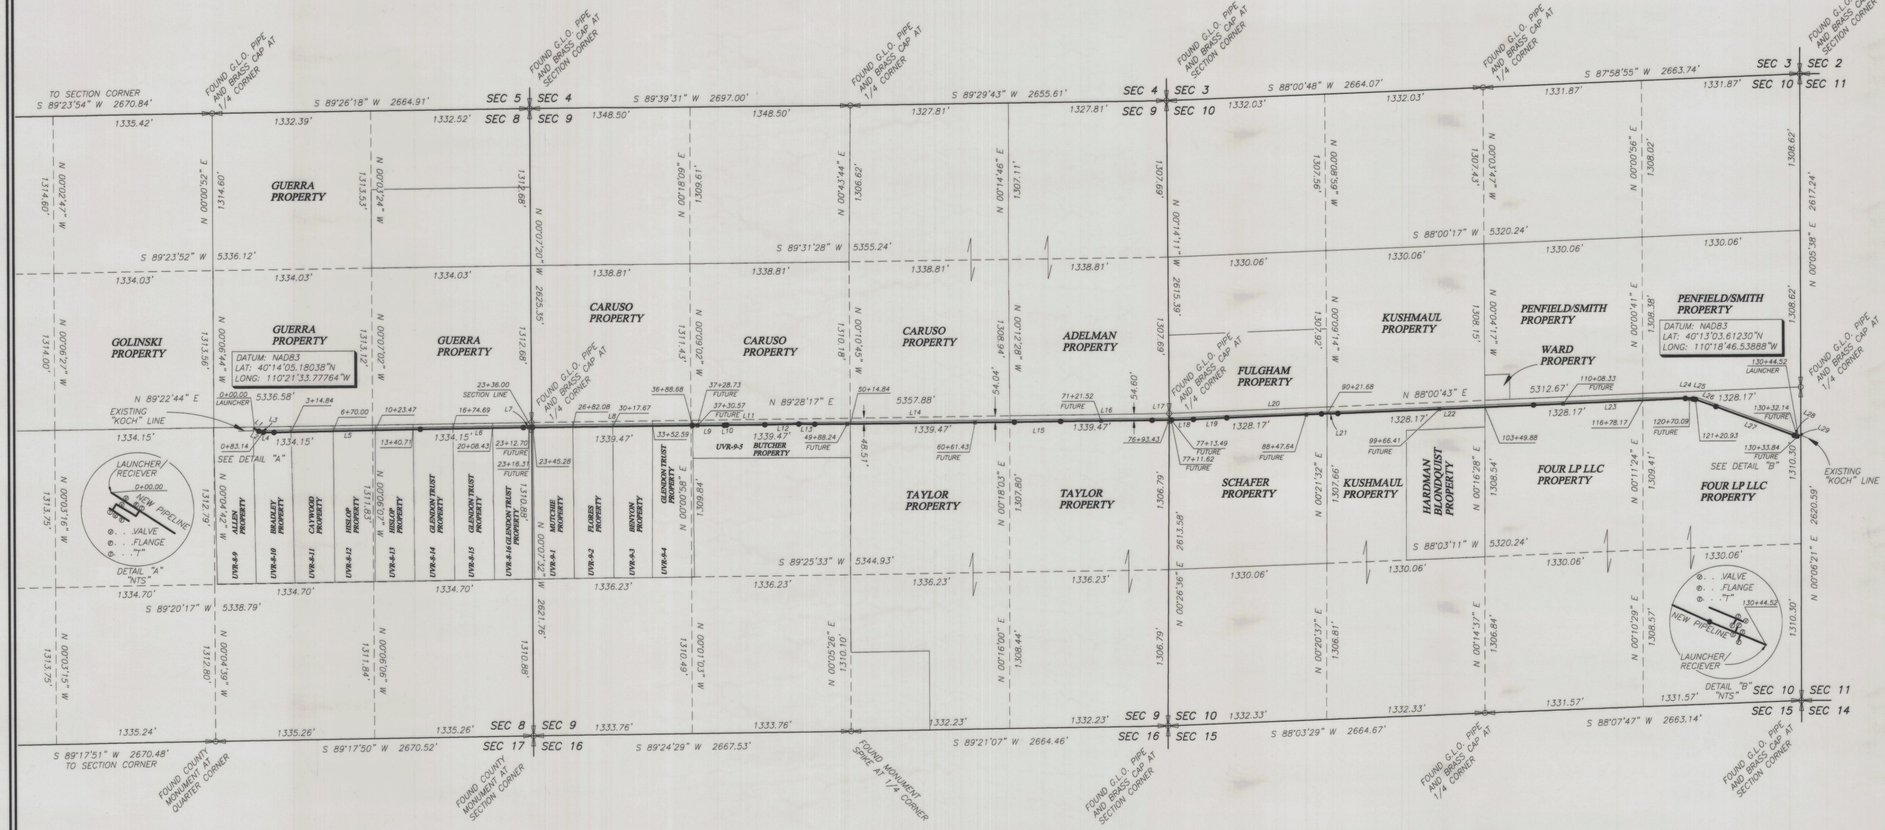

LINE	BEARING	DISTANCE
L1	S 57°10'48" E	43.78'
L2	S 70°06'04" E	13.03'
L3	S 78°15'40" E	26.33'
L4	S 89°08'15" E	89.28'
L5	N 89°03'48" E	1228.96'
L6	N 89°19'48" E	865.27'
L7	S 89°44'25" E	77.00'
L8	N 89°34'45" E	1342.67'
L9	N 89°56'14" E	269.57'
L10	N 83°19'44" E	19.25'
L11	N 89°42'53" E	330.65'
L12	N 88°59'26" E	285.76'
L13	S 89°06'08" E	134.74'
L14	N 89°45'31" E	1675.48'
L15	N 89°17'16" E	389.86'
L16	N 89°33'57" E	767.95'
L17	N 89°37'02" E	163.76'
L18	N 88°34'58" E	183.86'
L19	N 87°35'29" E	279.98'
L20	N 87°59'38" E	797.99'
L21	N 88°50'30" E	137.88'
L22	N 88°01'13" E	1645.15'
L23	N 87°57'02" E	1275.79'
L24	S 85°26'48" E	67.19'
L25	S 79°03'47" E	19.74'
L26	S 70°23'56" E	181.62'
L27	S 69°34'19" E	701.54'
L28	S 65°33'29" E	27.62'
L29	S 67°30'45" E	12.81'

LEGEND AND NOTES

OVERHEAD POWER LINES
PIPELINE CENTERLINE
EXISTING PIPELINE
FUTURE/STAND PIPE AND FLANGE

THIS SURVEY WAS PERFORMED USING GLOBAL POSITIONING SYSTEM PROCEDURES AND EQUIPMENT

THE BASIS OF BEARINGS IS GEODETIC NORTH DERIVED FROM G.P.S. OBSERVATIONS AT A CONTROL POINT (SECTION CORNER) LOCATED AT LAT: 40°15'22.90258"N AND LAT: 110°23'21.19760"W USING THE UTAH STATE G.P.S. VIRTUAL REFERENCE STATION CONTROL NETWORK MAINTAINED AND OPERATED BY THE AUTOMATED GEOGRAPHIC REFERENCE CENTER

SURVEYOR'S CERTIFICATE

This is to certify that this plat was prepared from the field notes and electronic data collector files of an actual survey made by me, or under my personal supervision, of the pipeline as-built shown hereon, and that the monuments indicated were found or set during said survey, and that this plat accurately represents said survey to the best of my knowledge.

PROFESSIONAL LAND SURVEYOR
No. 148951
JERRY D. ALLRED
14 OCT 2013
STATE OF UTAH

Jerry D. Allred, Professional Land Surveyor, Certificate 148951 (Utah)

JERRY D. ALLRED & ASSOCIATES
SURVEYING CONSULTANTS
1235 NORTH 700 EAST--P.O. BOX 975
DUCHESNE, UTAH 84021
(435) 738-5352

14 OCT 2013 12-121-046

COUNTY SURVEYOR'S FILE # 2894