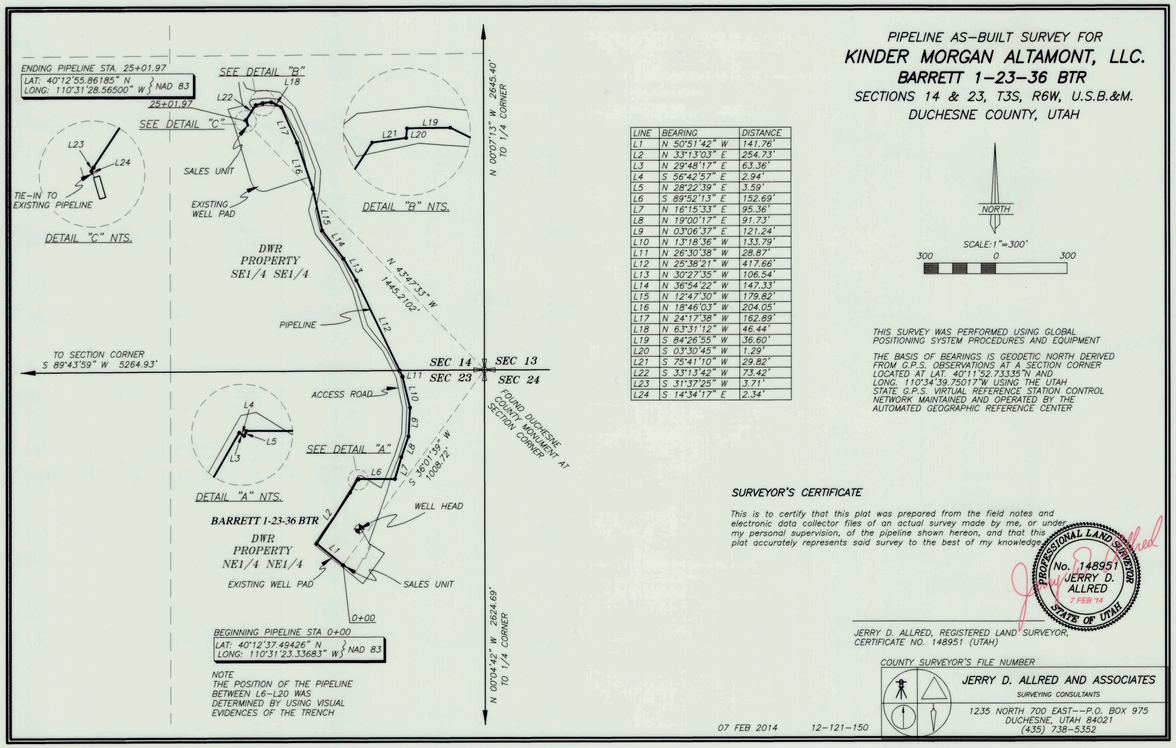

NOTE
THE POSITION OF THE PIPELINE BETWEEN L6-L20 WAS DETERMINED BY USING VISUAL EVIDENCES OF THE TRENCH

PIPELINE AS-BUILT SURVEY FOR

KINDER MORGAN ALTAMONT, LLC.

BARRETT 1-23-36 BTR

SECTIONS 14 & 23, T3S, R6W, U.S.B.&M.

DUCHESNE COUNTY, UTAH

LINE	BEARING	DISTANCE
L1	N 50°51'42" W	141.76'
L2	N 33°13'03" E	254.73'
L3	N 29°48'17" E	63.36'
L4	S 56°42'57" E	2.94'
L5	N 28°22'39" E	3.59'
L6	S 89°52'13" E	152.69'
L7	N 16°15'33" E	95.36'
L8	N 19°00'17" E	91.73'
L9	N 03°06'37" E	121.24'
L10	N 13°18'36" W	133.79'
L11	N 26°30'38" W	28.87'
L12	N 25°38'21" W	417.66'
L13	N 30°27'35" W	106.54'
L14	N 36°54'22" W	147.33'
L15	N 12°47'30" W	179.82'
L16	N 18°46'03" W	204.05'
L17	N 24°17'38" W	162.89'
L18	N 63°31'12" W	46.44'
L19	S 84°26'55" W	36.60'
L20	S 03°30'45" W	1.29'
L21	S 75°41'10" W	29.82'
L22	S 33°13'42" W	73.42'
L23	S 31°37'25" W	3.71'
L24	S 14°34'17" E	2.34'

NORTH

SCALE:1"=300'

300 0 300

THIS SURVEY WAS PERFORMED USING GLOBAL POSITIONING SYSTEM PROCEDURES AND EQUIPMENT

THE BASIS OF BEARINGS IS GEODETIC NORTH DERIVED FROM G.P.S. OBSERVATIONS AT A SECTION CORNER LOCATED AT LAT. 40°11'52.73335"N AND LONG. 110°34'39.75017"W USING THE UTAH STATE G.P.S. VIRTUAL REFERENCE STATION CONTROL NETWORK MAINTAINED AND OPERATED BY THE AUTOMATED GEOGRAPHIC REFERENCE CENTER

SURVEYOR'S CERTIFICATE

This is to certify that this plat was prepared from the field notes and electronic data collector files of an actual survey made by me, or under my personal supervision, of the pipeline shown hereon, and that this plat accurately represents said survey to the best of my knowledge.

PROFESSIONAL LAND SURVEYOR No. 148951 JERRY D. ALLRED 7 FEB '14 STATE OF UTAH

JERRY D. ALLRED, REGISTERED LAND SURVEYOR, CERTIFICATE NO. 148951 (UTAH)

COUNTY SURVEYOR'S FILE NUMBER

JERRY D. ALLRED AND ASSOCIATES
SURVEYING CONSULTANTS
1235 NORTH 700 EAST--P.O. BOX 975
DUCHESNE, UTAH 84021
(435) 738-5352

07 FEB 2014 12-121-150

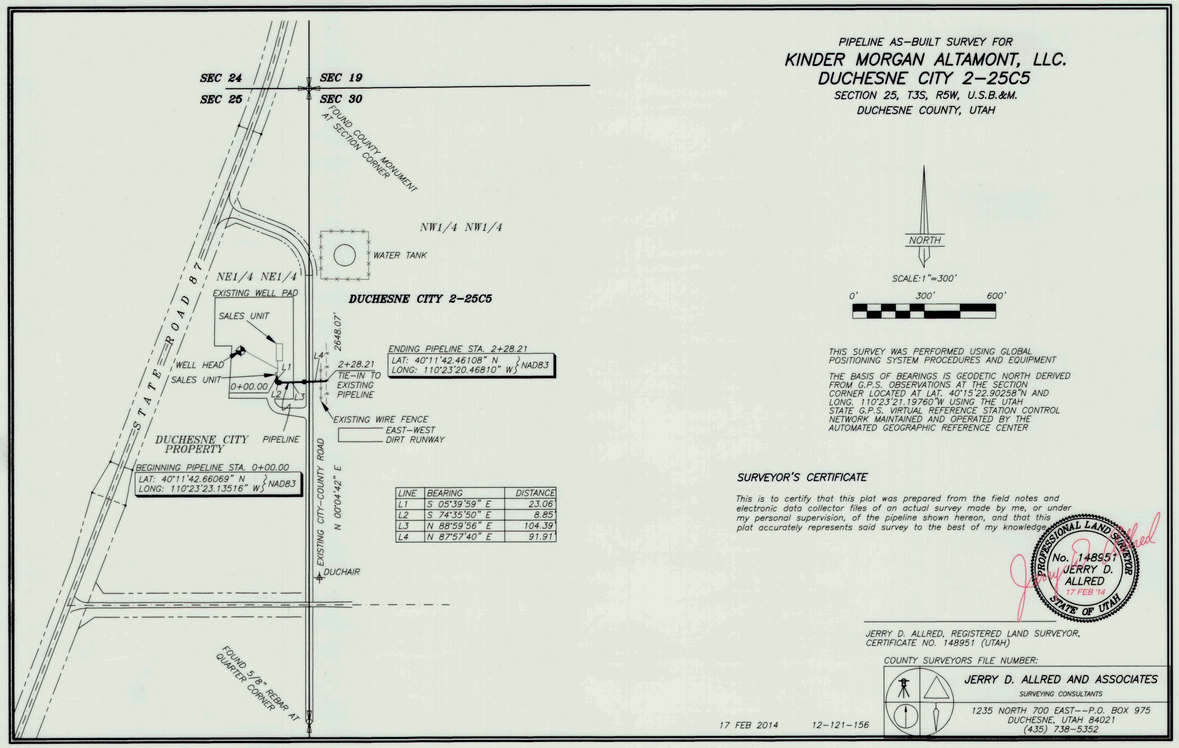

LINE	BEARING	DISTANCE
L1	S 05°39'59" E	23.06'
L2	S 74°35'50" E	8.85'
L3	N 88°59'56" E	104.39'
L4	N 87°57'40" E	91.91'

PIPELINE AS-BUILT SURVEY FOR

KINDER MORGAN ALTAMONT, LLC.

DUCHESNE CITY 2-25C5

SECTION 25, T3S, R5W, U.S.B.&M.

DUCHESNE COUNTY, UTAH

NORTH

SCALE:1"=300'

0' 300' 600'

THIS SURVEY WAS PERFORMED USING GLOBAL POSITIONING SYSTEM PROCEDURES AND EQUIPMENT

THE BASIS OF BEARINGS IS GEODETIC NORTH DERIVED FROM G.P.S. OBSERVATIONS AT THE SECTION CORNER LOCATED AT LAT. 40°15'22.90258"N AND LONG. 110°23'21.19760"W USING THE UTAH STATE G.P.S. VIRTUAL REFERENCE STATION CONTROL NETWORK MAINTAINED AND OPERATED BY THE AUTOMATED GEOGRAPHIC REFERENCE CENTER

SURVEYOR'S CERTIFICATE

This is to certify that this plat was prepared from the field notes and electronic data collector files of an actual survey made by me, or under my personal supervision, of the pipeline shown hereon, and that this plat accurately represents said survey to the best of my knowledge.

PROFESSIONAL LAND SURVEYOR No. 148951 JERRY D. ALLRED 17 FEB '14 STATE OF UTAH

JERRY D. ALLRED, REGISTERED LAND SURVEYOR, CERTIFICATE NO. 148951 (UTAH)

COUNTY SURVEYORS FILE NUMBER:

JERRY D. ALLRED AND ASSOCIATES
SURVEYING CONSULTANTS
1235 NORTH 700 EAST--P.O. BOX 975
DUCHESNE, UTAH 84021
(435) 738-5352

17 FEB 2014 12-121-156

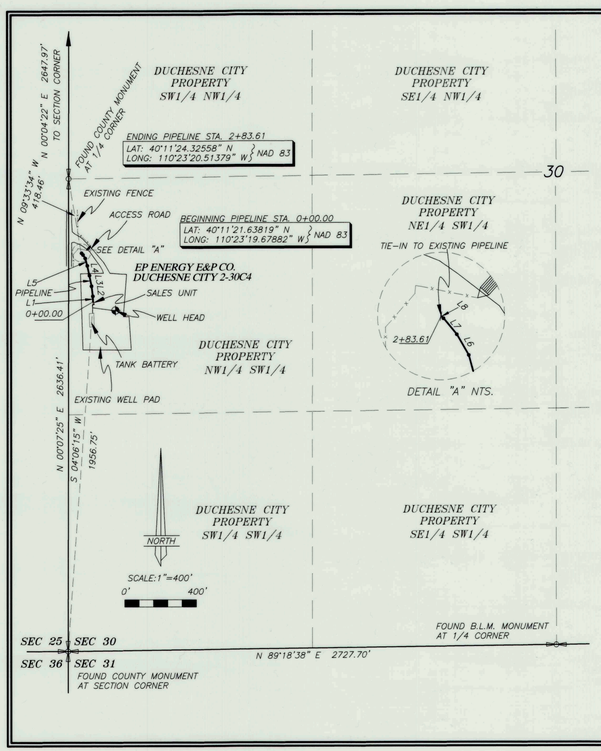

PIPELINE AS-BUILT SURVEY

KINDER MORGAN ALTAMONT LLC.

DUCHESNE CITY 2-30C4

SECTION 30, T3S, R4W, U.S.B.&M.

DUCHESNE COUNTY, UTAH

LINE	BEARING	DISTANCE
L1	N 48°14'23" W	3.08'
L2	N 07°31'09" W	56.36'
L3	N 10°30'26" W	60.56'
L4	N 12°31'38" W	55.92'
L5	N 15°16'12" W	42.55'
L6	N 29°55'55" W	19.03'
L7	N 39°19'10" W	16.29'
L8	N 01°52'11" W	29.82'

THIS SURVEY WAS PERFORMED USING GLOBAL POSITIONING SYSTEM PROCEDURES AND EQUIPMENT

THE BASIS OF BEARINGS IS GEODETIC NORTH DERIVED FROM G.P.S. OBSERVATIONS AT THE CONTROL MONUMENT LOCATED AT LAT. 40°10'43.26237"N AND LONG. 110°23'52.06157"W USING THE UTAH STATE G.P.S. VIRTUAL REFERENCE STATION CONTROL NETWORK MAINTAINED AND OPERATED BY THE AUTOMATED GEOGRAPHIC REFERENCE CENTER

SURVEYOR'S CERTIFICATE

This is to certify that this plat was prepared from the field notes and electronic data collector files of an actual survey made by me, or under my personal supervision, of the pipeline shown hereon, and that this plat accurately represents said survey to the best of my knowledge.

PROFESSIONAL LAND SURVEYOR No. 148951 JERRY D. ALLRED 19 FEB '14 STATE OF UTAH

Jerry D. Allred, Professional Land Surveyor, Certificate 148951 (Utah)

COUNTY SURVEYOR'S FILE NUMBER

JERRY D. ALLRED AND ASSOCIATES
SURVEYING CONSULTANTS
1235 NORTH 700 EAST--P.O. BOX 975
DUCHESNE, UTAH 84021
(435) 738-5352

18 FEB 2014 12-121-160

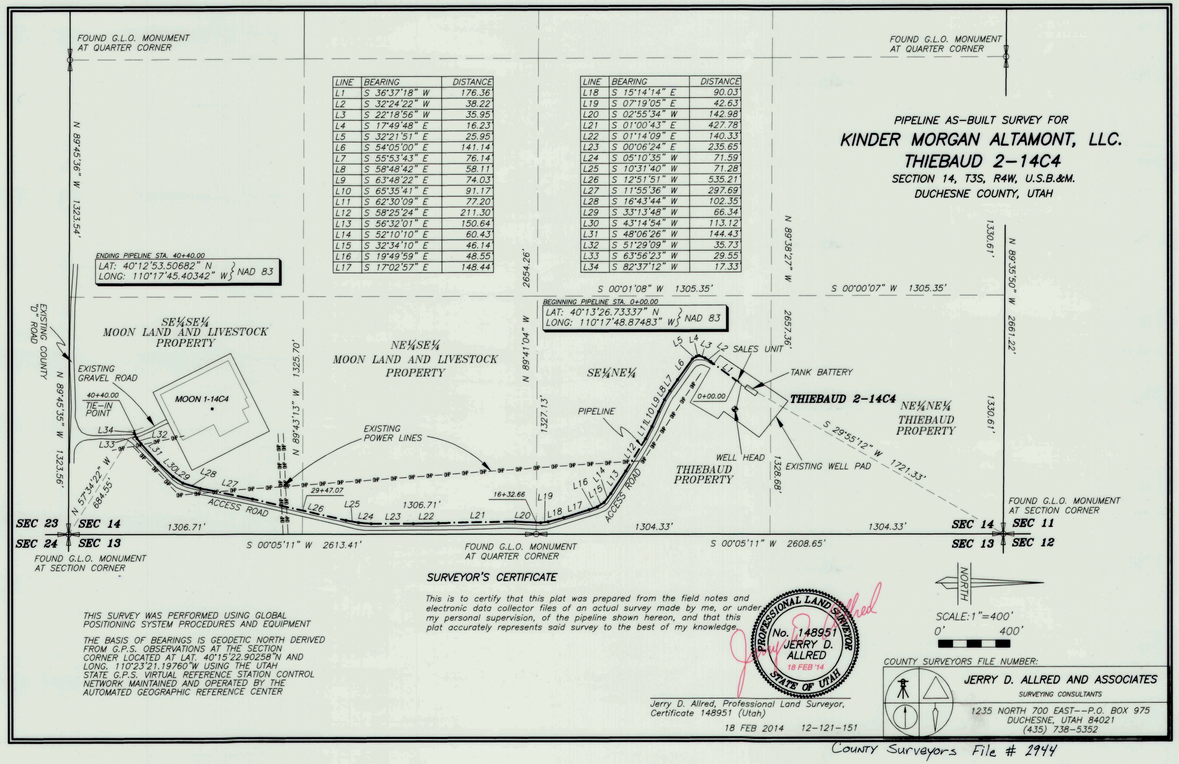

LINE	BEARING	DISTANCE
L1	S 36°37'18" W	176.36'
L2	S 32°24'22" W	38.22'
L3	S 22°18'56" W	35.95'
L4	S 17°49'48" E	16.23'
L5	S 32°21'51" E	25.95'
L6	S 54°05'00" E	141.14'
L7	S 55°53'43" E	76.14'
L8	S 58°48'42" E	58.11'
L9	S 63°48'22" E	74.03'
L10	S 65°35'41" E	91.17'
L11	S 62°30'09" E	77.20'
L12	S 58°25'24" E	211.30'
L13	S 56°32'01" E	150.64'
L14	S 52°10'10" E	60.43'
L15	S 32°34'10" E	46.14'
L16	S 19°49'59" E	48.55'
L17	S 17°02'57" E	148.44'

LINE	BEARING	DISTANCE
L18	S 15°14'14" E	90.03'
L19	S 07°19'05" E	42.63'
L20	S 02°55'34" W	142.98'
L21	S 01°00'43" E	427.78'
L22	S 01°14'09" E	140.33'
L23	S 00°06'24" E	235.65'
L24	S 05°10'35" W	71.59'
L25	S 10°31'40" W	71.28'
L26	S 12°51'51" W	535.21'
L27	S 11°55'36" W	297.69'
L28	S 16°43'44" W	102.35'
L29	S 33°13'48" W	66.34'
L30	S 43°14'54" W	113.12'
L31	S 48°06'26" W	144.43'
L32	S 51°29'09" W	35.73'
L33	S 63°56'23" W	29.55'
L34	S 82°37'12" W	17.33'

THIS SURVEY WAS PERFORMED USING GLOBAL POSITIONING SYSTEM PROCEDURES AND EQUIPMENT

THE BASIS OF BEARINGS IS GEODETIC NORTH DERIVED FROM G.P.S. OBSERVATIONS AT THE SECTION CORNER LOCATED AT LAT. 40°15'22.90258"N AND LONG. 110°23'21.19760"W USING THE UTAH STATE G.P.S. VIRTUAL REFERENCE STATION CONTROL NETWORK MAINTAINED AND OPERATED BY THE AUTOMATED GEOGRAPHIC REFERENCE CENTER

SURVEYOR'S CERTIFICATE

This is to certify that this plat was prepared from the field notes and electronic data collector files of an actual survey made by me, or under my personal supervision, of the pipeline shown hereon, and that this plat accurately represents said survey to the best of my knowledge.

PROFESSIONAL LAND SURVEYOR No. 148951 JERRY D. ALLRED 18 FEB '14 STATE OF UTAH

Jerry D. Allred, Professional Land Surveyor, Certificate 148951 (Utah)

COUNTY SURVEYORS FILE NUMBER:

JERRY D. ALLRED AND ASSOCIATES
SURVEYING CONSULTANTS
1235 NORTH 700 EAST--P.O. BOX 975
DUCHESNE, UTAH 84021
(435) 738-5352

18 FEB 2014 12-121-151

County Surveyors File # 2944