AS-BUILT SURVEY FOR

KINDER MORGAN ALTAMONT LLC. BBC PHASE 6

SECTIONS 27, 33, & 34, T2S, R5W
SECTIONS 4, 8, 9, 17, 19 & 20, T3S, R5W
SECTION 24, T3S, R6W
UINTAH SPECIAL BASE AND MERIDIAN

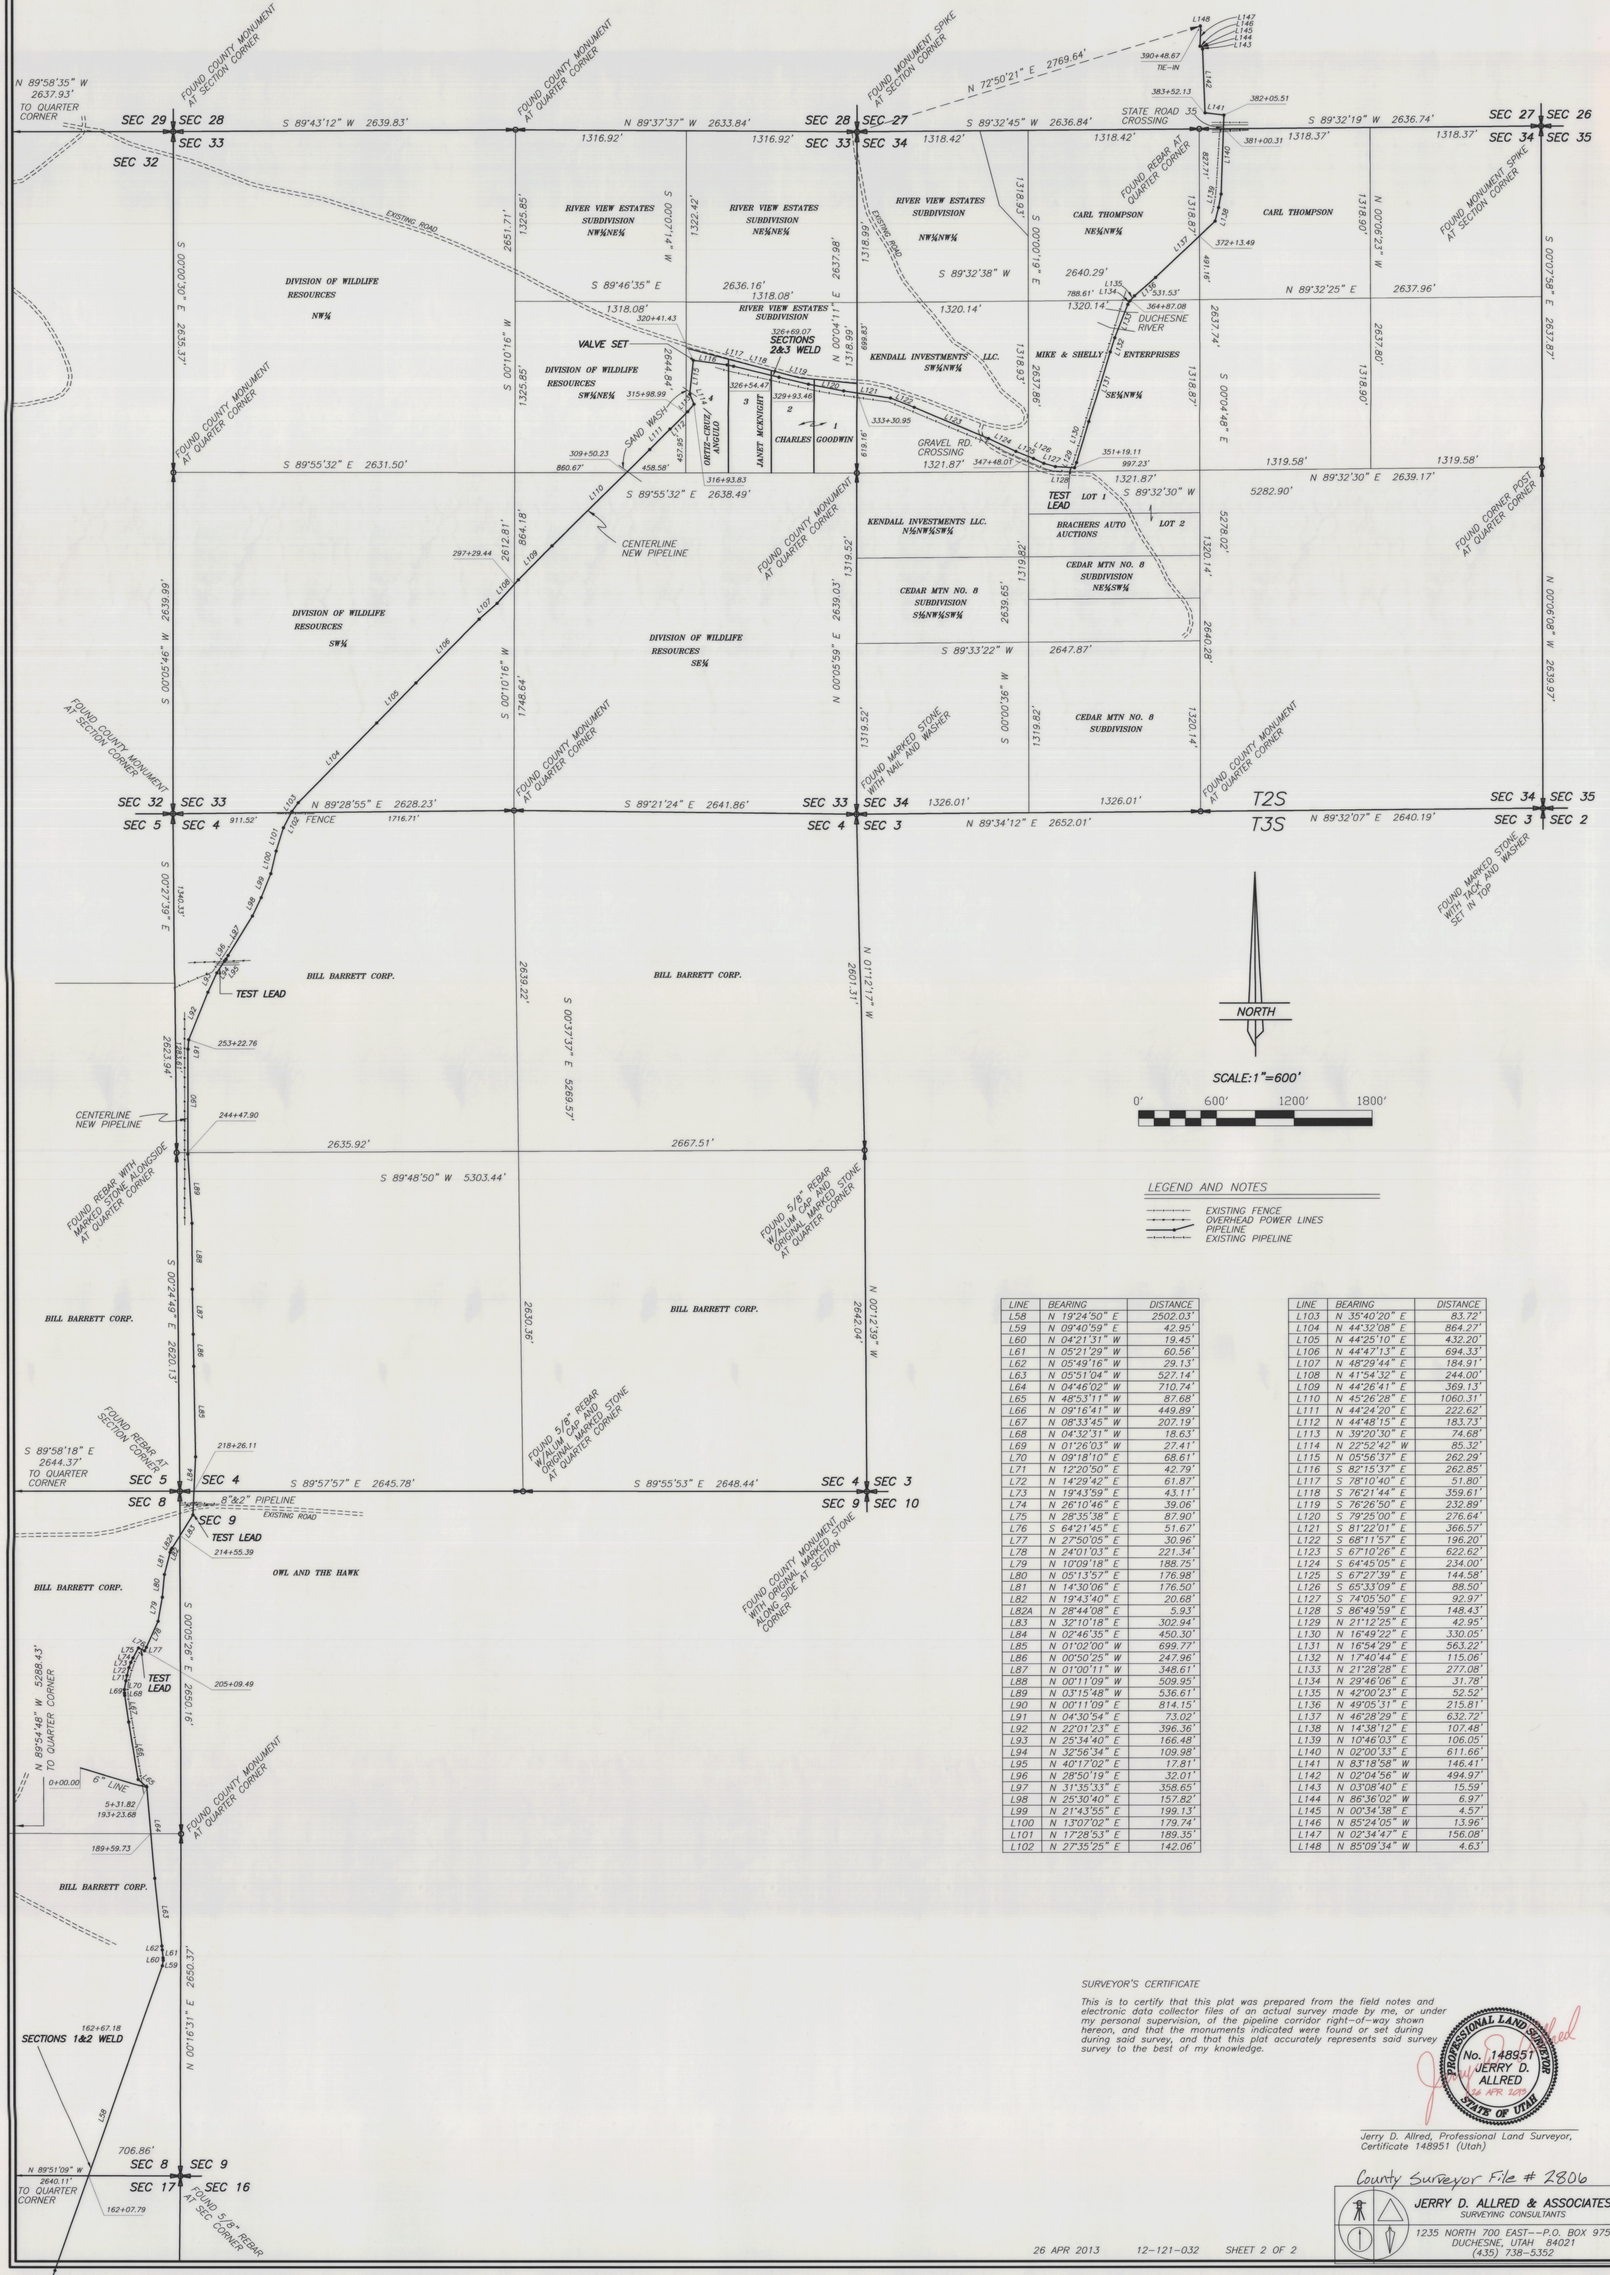

LEGEND AND NOTES

- EXISTING FENCE
- OVERHEAD POWER LINES
- PIPELINE
- EXISTING PIPELINE

LINE	BEARING	DISTANCE
L58	N 19°24'50" E	2502.03'
L59	N 09°40'59" E	42.95'
L60	N 04°21'31" W	19.45'
L61	N 05°21'29" W	60.56'
L62	N 05°49'16" W	29.13'
L63	N 05°51'04" W	527.14'
L64	N 04°46'02" W	710.74'
L65	N 48°53'11" W	87.68'
L66	N 09°16'41" W	449.89'
L67	N 08°33'45" W	207.19'
L68	N 04°32'31" W	18.63'
L69	N 01°26'03" W	27.41'
L70	N 09°18'10" E	68.61'
L71	N 12°20'50" E	42.79'
L72	N 14°29'42" E	61.87'
L73	N 19°43'59" E	43.11'
L74	N 26°10'46" E	39.06'
L75	N 28°35'38" E	87.90'
L76	S 64°21'45" E	51.67'
L77	N 27°50'05" E	30.96'
L78	N 24°01'03" E	221.34'
L79	N 10°09'18" E	188.75'
L80	N 05°13'57" E	176.98'
L81	N 14°30'06" E	176.50'
L82	N 19°43'40" E	20.68'
L82A	N 28°44'08" E	5.93'
L83	N 32°10'18" E	302.94'
L84	N 02°46'35" E	450.30'
L85	N 01°02'00" W	699.77'
L86	N 00°50'25" W	247.96'
L87	N 01°00'11" W	348.61'
L88	N 00°11'09" W	509.95'
L89	N 03°15'48" W	536.61'
L90	N 00°11'09" E	814.15'
L91	N 04°30'54" E	73.02'
L92	N 22°01'23" E	396.36'
L93	N 25°34'40" E	166.48'
L94	N 32°56'34" E	109.98'
L95	N 40°17'02" E	17.81'
L96	N 28°50'19" E	32.01'
L97	N 31°35'33" E	358.65'
L98	N 25°30'40" E	157.82'
L99	N 21°43'56" E	199.13'
L100	N 13°07'02" E	179.74'
L101	N 17°28'53" E	189.35'
L102	N 27°35'25" E	142.06'

LINE	BEARING	DISTANCE
L103	N 35°40'20" E	83.72'
L104	N 44°32'08" E	864.27'
L105	N 44°25'10" E	432.20'
L106	N 44°47'13" E	694.33'
L107	N 48°29'44" E	184.91'
L108	N 41°54'32" E	244.00'
L109	N 44°26'41" E	369.13'
L110	N 45°26'28" E	1060.31'
L111	N 44°24'20" E	222.62'
L112	N 44°48'15" E	183.73'
L113	N 39°20'30" E	74.68'
L114	N 22°52'42" W	85.32'
L115	N 05°56'37" E	262.29'
L116	S 82°15'37" E	262.85'
L117	S 78°10'40" E	51.80'
L118	S 76°21'44" E	359.61'
L119	S 76°26'50" E	232.89'
L120	S 79°25'00" E	276.64'
L121	S 81°22'01" E	366.57'
L122	S 68°11'57" E	196.20'
L123	S 67°10'26" E	622.62'
L124	S 64°45'05" E	234.00'
L125	S 67°27'39" E	144.58'
L126	S 65°33'09" E	88.50'
L127	S 74°05'50" E	92.97'
L128	S 86°49'59" E	148.43'
L129	N 21°12'25" E	42.95'
L130	N 16°49'22" E	330.05'
L131	N 16°54'29" E	563.22'
L132	N 17°40'44" E	115.06'
L133	N 21°28'28" E	277.08'
L134	N 29°46'06" E	31.78'
L135	N 42°00'23" E	52.52'
L136	N 49°05'31" E	215.81'
L137	N 46°28'29" E	632.72'
L138	N 14°38'12" E	107.48'
L139	N 10°46'03" E	106.05'
L140	N 02°00'33" E	611.66'
L141	N 83°18'58" W	146.41'
L142	N 02°04'56" W	494.97'
L143	N 03°08'40" E	15.59'
L144	N 86°36'02" W	6.97'
L145	N 00°34'38" E	4.57'
L146	N 85°34'05" W	13.96'
L147	N 02°34'47" E	156.08'
L148	N 85°09'34" W	4.63'

SURVEYOR'S CERTIFICATE

This is to certify that this plat was prepared from the field notes and electronic data collector files of an actual survey made by me, or under my personal supervision, of the pipeline corridor right-of-way shown hereon, and that the monuments indicated were found or set during during said survey, and that this plat accurately represents said survey survey to the best of my knowledge.

PROFESSIONAL LAND SURVEYOR No. 148951 JERRY D. ALLRED 26 APR 2013 STATE OF UTAH

Jerry D. Allred, Professional Land Surveyor, Certificate 148951 (Utah)

County Surveyor File # 2806

JERRY D. ALLRED & ASSOCIATES
SURVEYING CONSULTANTS
1235 NORTH 700 EAST--P.O. BOX 975
DUCHESNE, UTAH 84021
(435) 738-5352