"AS-BUILT" SURVEY FOR

ELPASO E&P, CO.

DWR 3-14C6

SECTION 14, TOWNSHIP 3 SOUTH, RANGE 6 WEST

UINTAH SPECIAL BASE AND MERIDIAN

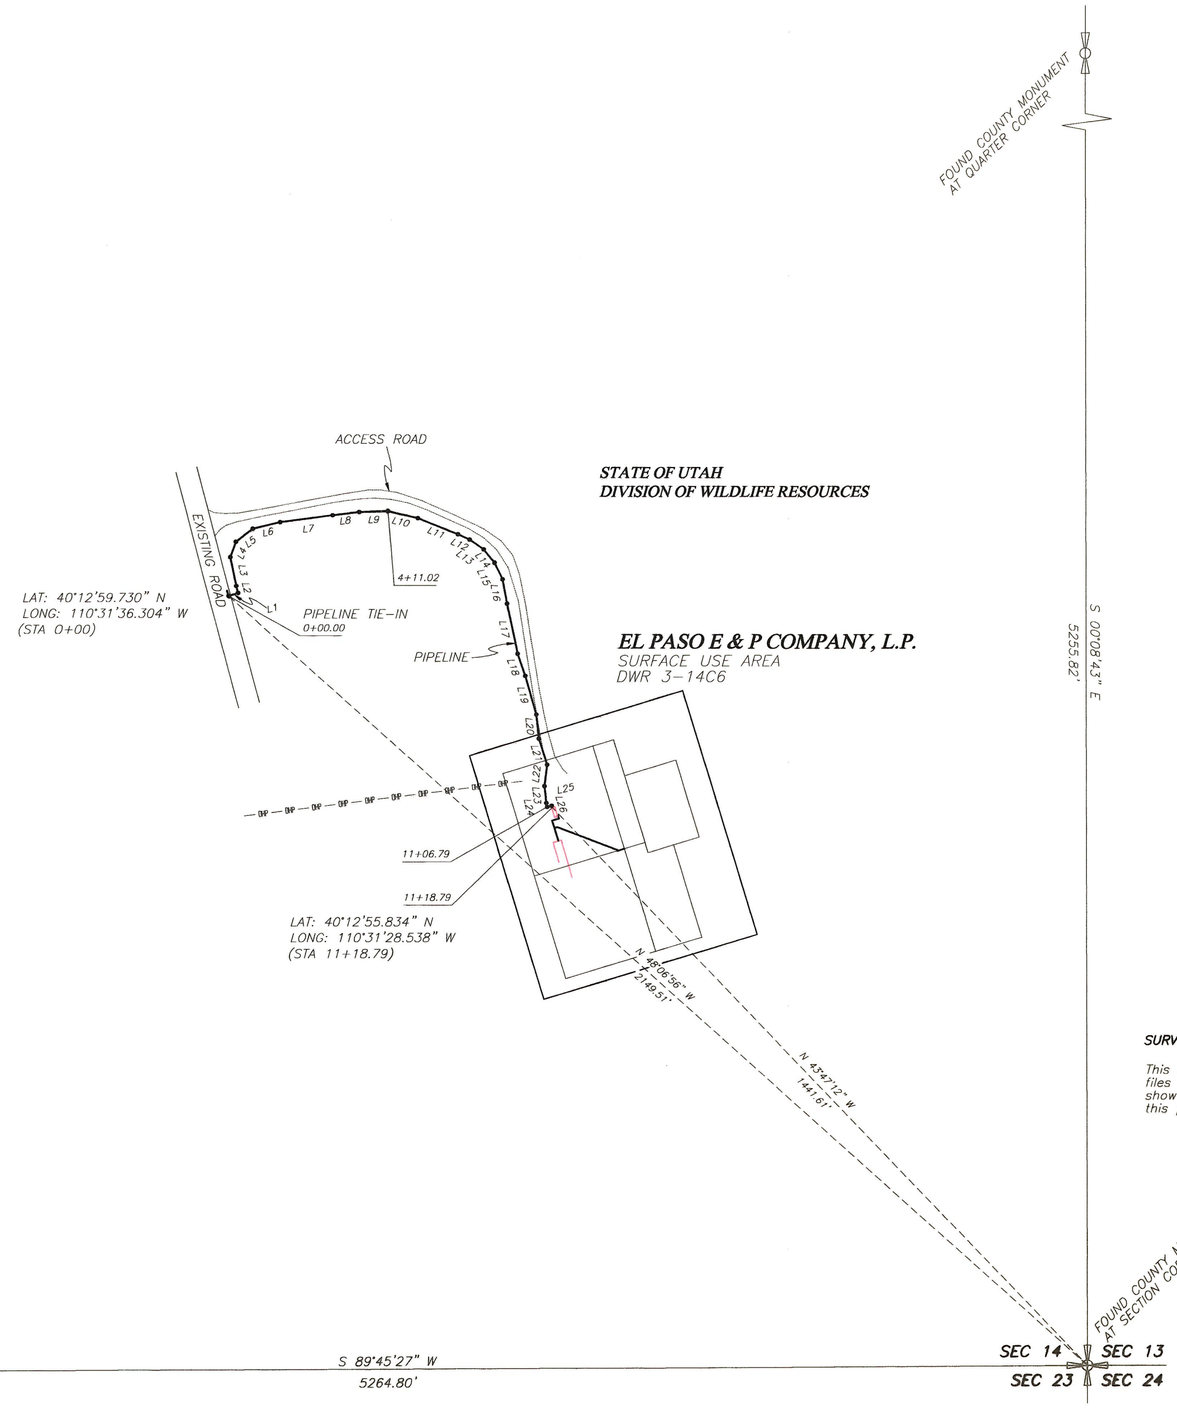

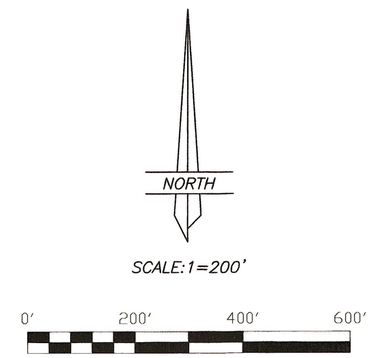

THE BASIS OF BEARINGS IS DERIVED FROM G.P.S. OBSERVATIONS
LATITUDE AND LONGITUDE ARE BASED ON NAD83 PROJECTION

SURVEYOR'S CERTIFICATE

This is to certify that this plat was prepared from the field notes and electronic data collector files of an actual survey made by me, or under my personal supervision, of the parcel of land shown hereon, and that the monuments indicated were found or set during said survey, and that this plat accurately represents said survey to the best of my knowledge.

PROFESSIONAL LAND SURVEYOR No. 148951 JERRY D. ALLRED STATE OF UTAH

1 Jun '10

Jerry D. Allred, Professional Land Surveyor,
Certificate No. 148951, (Utah)

COUNTY SURVEYOR'S FILE # 2279

JERRY D. ALLRED AND ASSOCIATES
SURVEYING CONSULTANTS
1235 NORTH 700 EAST ST.--P.O. BOX 975
DUCHESNE, UTAH 84021
(435) 738-5352

22 MAR 2010 01-128-162