PIPELINE AS-BUILT SURVEY FOR

# KINDER MORGAN ALTAMONT, LLC.

## BARRETT 5-21-36 BTR

SECTION 21, T3S, R6W, U.S.B.&M.

DUCHESNE COUNTY, UTAH

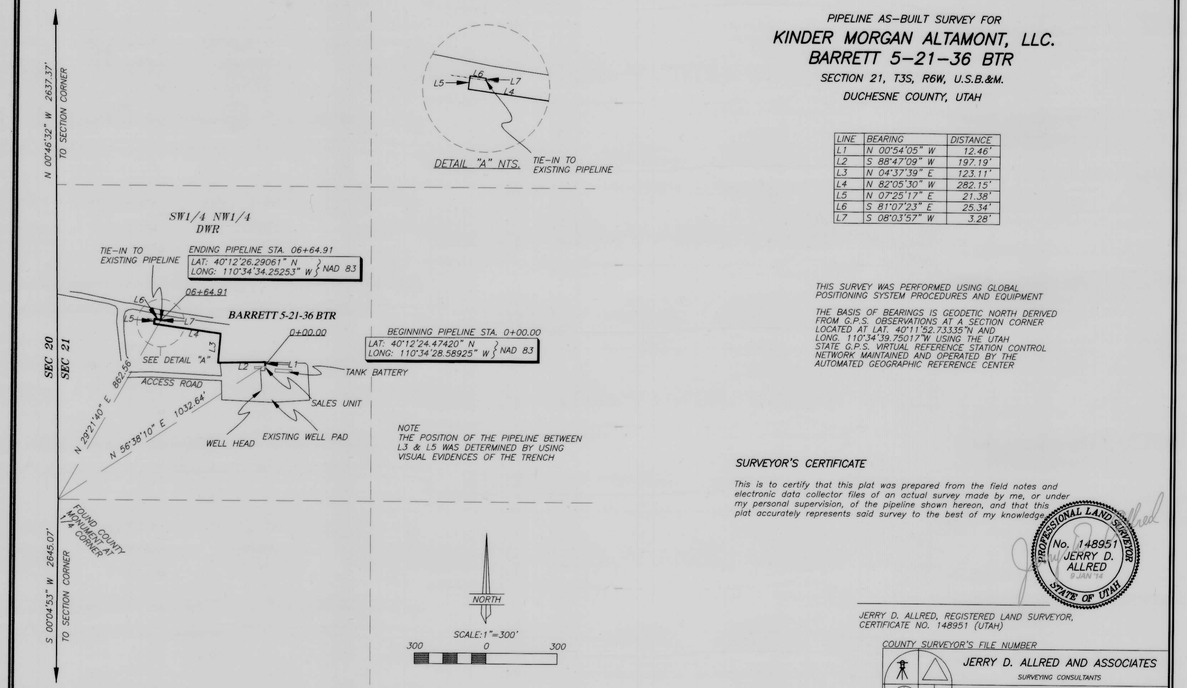


| LINE | BEARING | DISTANCE |
|---|---|---|
| L1 | N 00°54'05" W | 12.46' |
| L2 | S 88°47'09" W | 197.19' |
| L3 | N 04°37'39" E | 123.11' |
| L4 | N 82°05'30" W | 282.15' |
| L5 | N 07°25'17" E | 21.38' |
| L6 | S 81°07'23" E | 25.34' |
| L7 | S 08°03'57" W | 3.28' |

THIS SURVEY WAS PERFORMED USING GLOBAL POSITIONING SYSTEM PROCEDURES AND EQUIPMENT

THE BASIS OF BEARINGS IS GEODETIC NORTH DERIVED FROM G.P.S. OBSERVATIONS AT A SECTION CORNER LOCATED AT LAT. 40°11'52.73335"N AND LONG. 110°34'39.75017"W USING THE UTAH STATE G.P.S. VIRTUAL REFERENCE STATION CONTROL NETWORK MAINTAINED AND OPERATED BY THE AUTOMATED GEOGRAPHIC REFERENCE CENTER

### SURVEYOR'S CERTIFICATE

This is to certify that this plat was prepared from the field notes and electronic data collector files of an actual survey made by me, or under my personal supervision, of the pipeline shown hereon, and that this plat accurately represents said survey to the best of my knowledge.

PROFESSIONAL LAND SURVEYOR — No. 148951 — JERRY D. ALLRED — 9 JAN '14 — STATE OF UTAH

JERRY D. ALLRED, REGISTERED LAND SURVEYOR,
CERTIFICATE NO. 148951 (UTAH)

COUNTY SURVEYOR'S FILE NUMBER


JERRY D. ALLRED AND ASSOCIATES
SURVEYING CONSULTANTS
1235 NORTH 700 EAST--P.O. BOX 975
DUCHESNE, UTAH 84021
(435) 738-5352


9 JAN 2014 12-121-108

PIPELINE AS-BUILT SURVEY FOR

# KINDER MORGAN ALTAMONT, LLC.

## BARRETT 13-26-36 BTR

SECTIONS 26 & 27, T3S, R6W, U.S.B.&M.

DUCHESNE COUNTY, UTAH

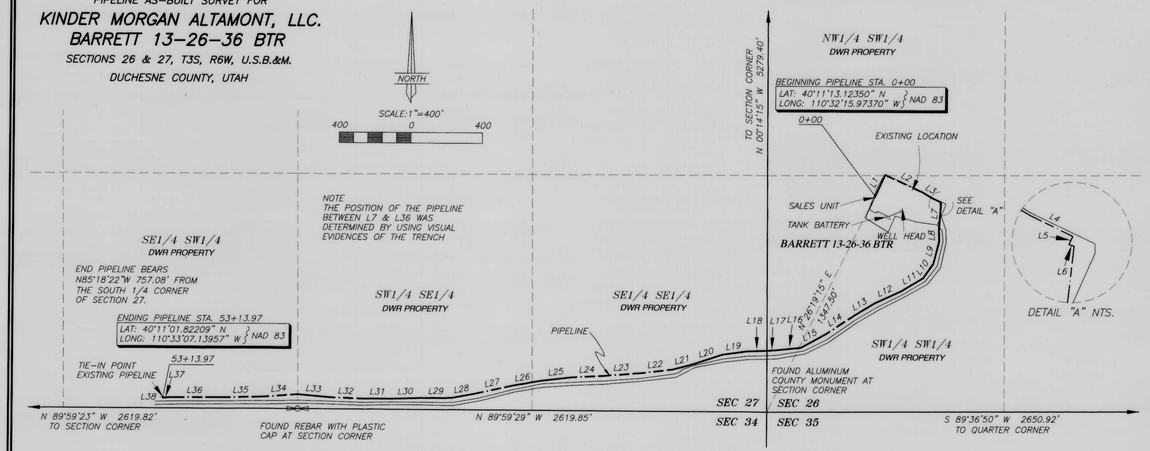


| LINE | BEARING | DISTANCE |
|---|---|---|
| L1 | N 24°35'29" E | 131.68' |
| L2 | S 65°12'27" E | 230.31' |
| L3 | S 59°58'22" E | 64.44' |
| L4 | S 64°01'24" E | 53.79' |
| L5 | S 25°11'44" W | 9.88' |
| L6 | S 71°33'18" E | 3.60' |
| L7 | S 04°11'06" W | 147.38' |
| L8 | S 01°42'19" E | 59.88' |
| L9 | S 14°04'17" W | 129.71' |
| L10 | S 34°31'27" W | 97.88' |
| L11 | S 58°53'47" W | 138.76' |
| L12 | S 65°04'31" W | 168.99' |
| L13 | S 58°43'29" W | 142.93' |
| L14 | S 56°10'07" W | 178.94' |
| L15 | S 61°08'01" W | 157.33' |
| L16 | S 64°11'22" W | 139.26' |
| L17 | S 87°03'39" W | 51.04' |
| L18 | S 87°03'39" W | 113.41' |
| L19 | S 81°57'12" W | 136.05' |

| LINE | BEARING | DISTANCE |
|---|---|---|
| L20 | S 71°54'15" W | 163.60' |
| L21 | S 74°45'25" W | 128.85' |
| L22 | S 83°04'53" W | 179.43' |
| L23 | S 85°46'40" W | 204.77' |
| L24 | S 86°50'16" W | 178.22' |
| L25 | S 83°13'32" W | 167.18' |
| L26 | S 80°01'44" W | 163.87' |
| L27 | S 77°27'35" W | 220.73' |
| L28 | S 79°26'59" W | 131.67' |
| L29 | S 89°37'08" W | 170.15' |
| L30 | S 88°06'23" W | 168.19' |
| L31 | S 89°58'23" W | 155.13' |
| L32 | N 88°11'01" W | 191.52' |
| L33 | N 84°47'47" W | 174.66' |
| L34 | S 85°37'17" W | 203.10' |
| L35 | S 88°57'09" W | 227.79' |
| L36 | S 89°56'30" W | 289.41' |
| L37 | S 82°03'23" W | 34.64' |
| L38 | N 01°21'09" E | 5.80' |

THIS SURVEY WAS PERFORMED USING GLOBAL POSITIONING SYSTEM PROCEDURES AND EQUIPMENT

THE BASIS OF BEARINGS IS GEODETIC NORTH DERIVED FROM G.P.S. OBSERVATIONS AT A SECTION CORNER LOCATED AT LAT. 40°11'52.73335"N AND LONG. 110°34'39.75017"W USING THE UTAH STATE G.P.S. VIRTUAL REFERENCE STATION CONTROL NETWORK MAINTAINED AND OPERATED BY THE AUTOMATED GEOGRAPHIC REFERENCE CENTER

### SURVEYOR'S CERTIFICATE

This is to certify that this plat was prepared from the field notes and electronic data collector files of an actual survey made by me, or under my personal supervision, of the pipeline shown hereon, and that this plat accurately represents said survey to the best of my knowledge.

PROFESSIONAL LAND SURVEYOR — No. 148951 — JERRY D. ALLRED — 9 JAN '14 — STATE OF UTAH

JERRY D. ALLRED, REGISTERED LAND SURVEYOR,
CERTIFICATE NO. 148951 (UTAH)

COUNTY SURVEYOR'S FILE NUMBER


JERRY D. ALLRED AND ASSOCIATES
SURVEYING CONSULTANTS
1235 NORTH 700 EAST--P.O. BOX 975
DUCHESNE, UTAH 84021
(435) 738-5352


9 JAN 2013 12-121-110

PIPELINE AS-BUILT SURVEY FOR

# KINDER MORGAN ALTAMONT, LLC.

## BARRETT 15-10-36 BTR

SECTION 10, T3S, R6W, U.S.B.&M.

DUCHESNE COUNTY, UTAH

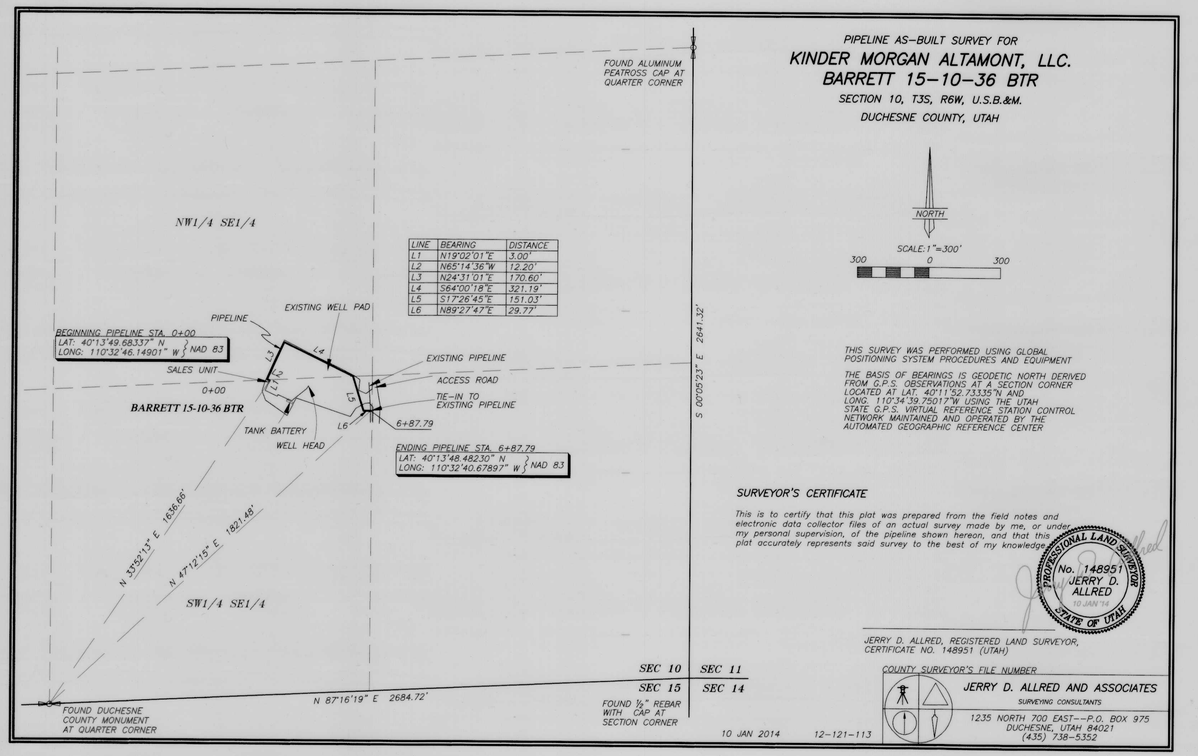


| LINE | BEARING | DISTANCE |
|---|---|---|
| L1 | N19°02'01"E | 3.00' |
| L2 | N65°14'36"W | 12.20' |
| L3 | N24°31'01"E | 170.60' |
| L4 | S64°00'18"E | 321.19' |
| L5 | S17°26'45"E | 151.03' |
| L6 | N89°27'47"E | 29.77' |

THIS SURVEY WAS PERFORMED USING GLOBAL POSITIONING SYSTEM PROCEDURES AND EQUIPMENT

THE BASIS OF BEARINGS IS GEODETIC NORTH DERIVED FROM G.P.S. OBSERVATIONS AT A SECTION CORNER LOCATED AT LAT. 40°11'52.73335"N AND LONG. 110°34'39.75017"W USING THE UTAH STATE G.P.S. VIRTUAL REFERENCE STATION CONTROL NETWORK MAINTAINED AND OPERATED BY THE AUTOMATED GEOGRAPHIC REFERENCE CENTER

### SURVEYOR'S CERTIFICATE

This is to certify that this plat was prepared from the field notes and electronic data collector files of an actual survey made by me, or under my personal supervision, of the pipeline shown hereon, and that this plat accurately represents said survey to the best of my knowledge.

PROFESSIONAL LAND SURVEYOR — No. 148951 — JERRY D. ALLRED — 10 JAN '14 — STATE OF UTAH

JERRY D. ALLRED, REGISTERED LAND SURVEYOR,
CERTIFICATE NO. 148951 (UTAH)

COUNTY SURVEYOR'S FILE NUMBER


JERRY D. ALLRED AND ASSOCIATES
SURVEYING CONSULTANTS
1235 NORTH 700 EAST--P.O. BOX 975
DUCHESNE, UTAH 84021
(435) 738-5352


10 JAN 2014 12-121-113

PIPELINE AS-BUILT SURVEY FOR

# KINDER MORGAN ALTAMONT, LLC.

## BARRETT 14-30-36 BTR

SECTION 30, T3S, R6W, U.S.B.&M.

DUCHESNE COUNTY, UTAH

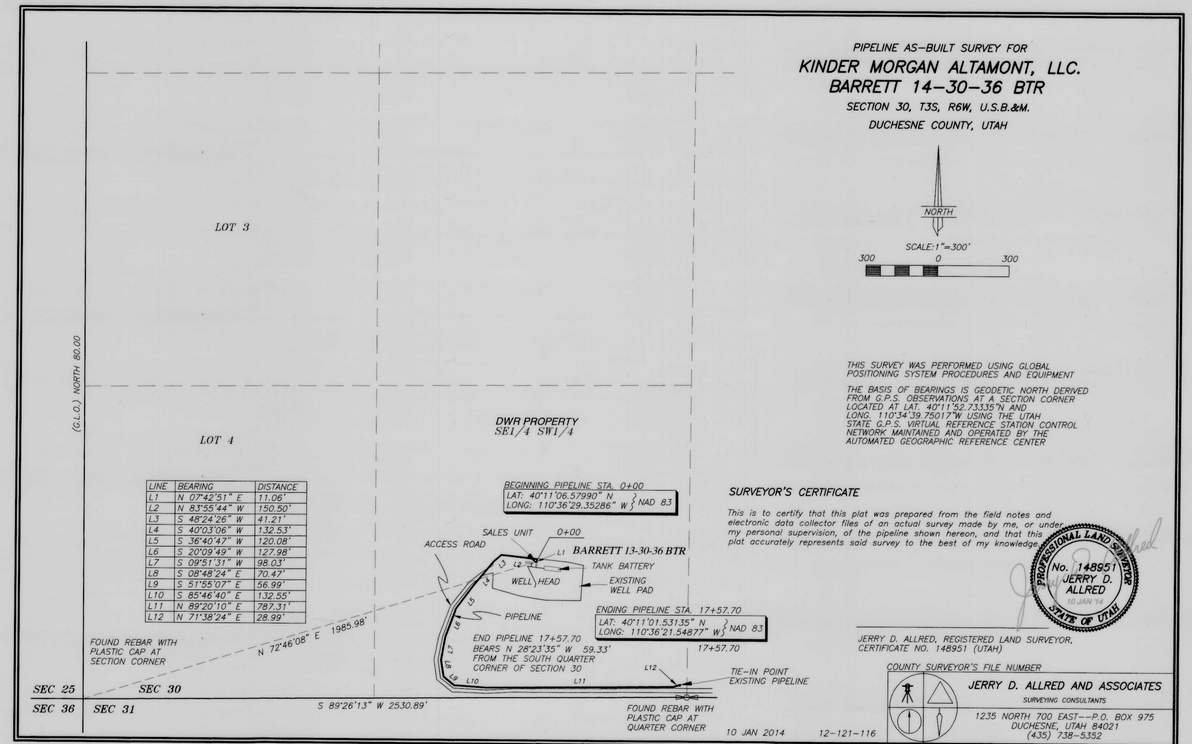


| LINE | BEARING | DISTANCE |
|---|---|---|
| L1 | N 07°42'51" E | 11.06' |
| L2 | N 83°55'44" W | 150.50' |
| L3 | S 48°24'26" W | 41.21' |
| L4 | S 40°03'06" W | 132.53' |
| L5 | S 36°40'47" W | 120.08' |
| L6 | S 20°09'49" W | 127.98' |
| L7 | S 09°51'31" W | 98.03' |
| L8 | S 08°48'24" E | 70.47' |
| L9 | S 51°55'07" E | 56.99' |
| L10 | S 85°46'40" E | 132.55' |
| L11 | N 89°20'10" E | 787.31' |
| L12 | N 71°38'24" E | 28.99' |

THIS SURVEY WAS PERFORMED USING GLOBAL POSITIONING SYSTEM PROCEDURES AND EQUIPMENT

THE BASIS OF BEARINGS IS GEODETIC NORTH DERIVED FROM G.P.S. OBSERVATIONS AT A SECTION CORNER LOCATED AT LAT. 40°11'52.73335"N AND LONG. 110°34'39.75017"W USING THE UTAH STATE G.P.S. VIRTUAL REFERENCE STATION CONTROL NETWORK MAINTAINED AND OPERATED BY THE AUTOMATED GEOGRAPHIC REFERENCE CENTER

### SURVEYOR'S CERTIFICATE

This is to certify that this plat was prepared from the field notes and electronic data collector files of an actual survey made by me, or under my personal supervision, of the pipeline shown hereon, and that this plat accurately represents said survey to the best of my knowledge.

PROFESSIONAL LAND SURVEYOR — No. 148951 — JERRY D. ALLRED — 10 JAN '14 — STATE OF UTAH

JERRY D. ALLRED, REGISTERED LAND SURVEYOR,
CERTIFICATE NO. 148951 (UTAH)

COUNTY SURVEYOR'S FILE NUMBER


JERRY D. ALLRED AND ASSOCIATES
SURVEYING CONSULTANTS
1235 NORTH 700 EAST--P.O. BOX 975
DUCHESNE, UTAH 84021
(435) 738-5352


10 JAN 2014 12-121-116

County Surveyors File # 2918